


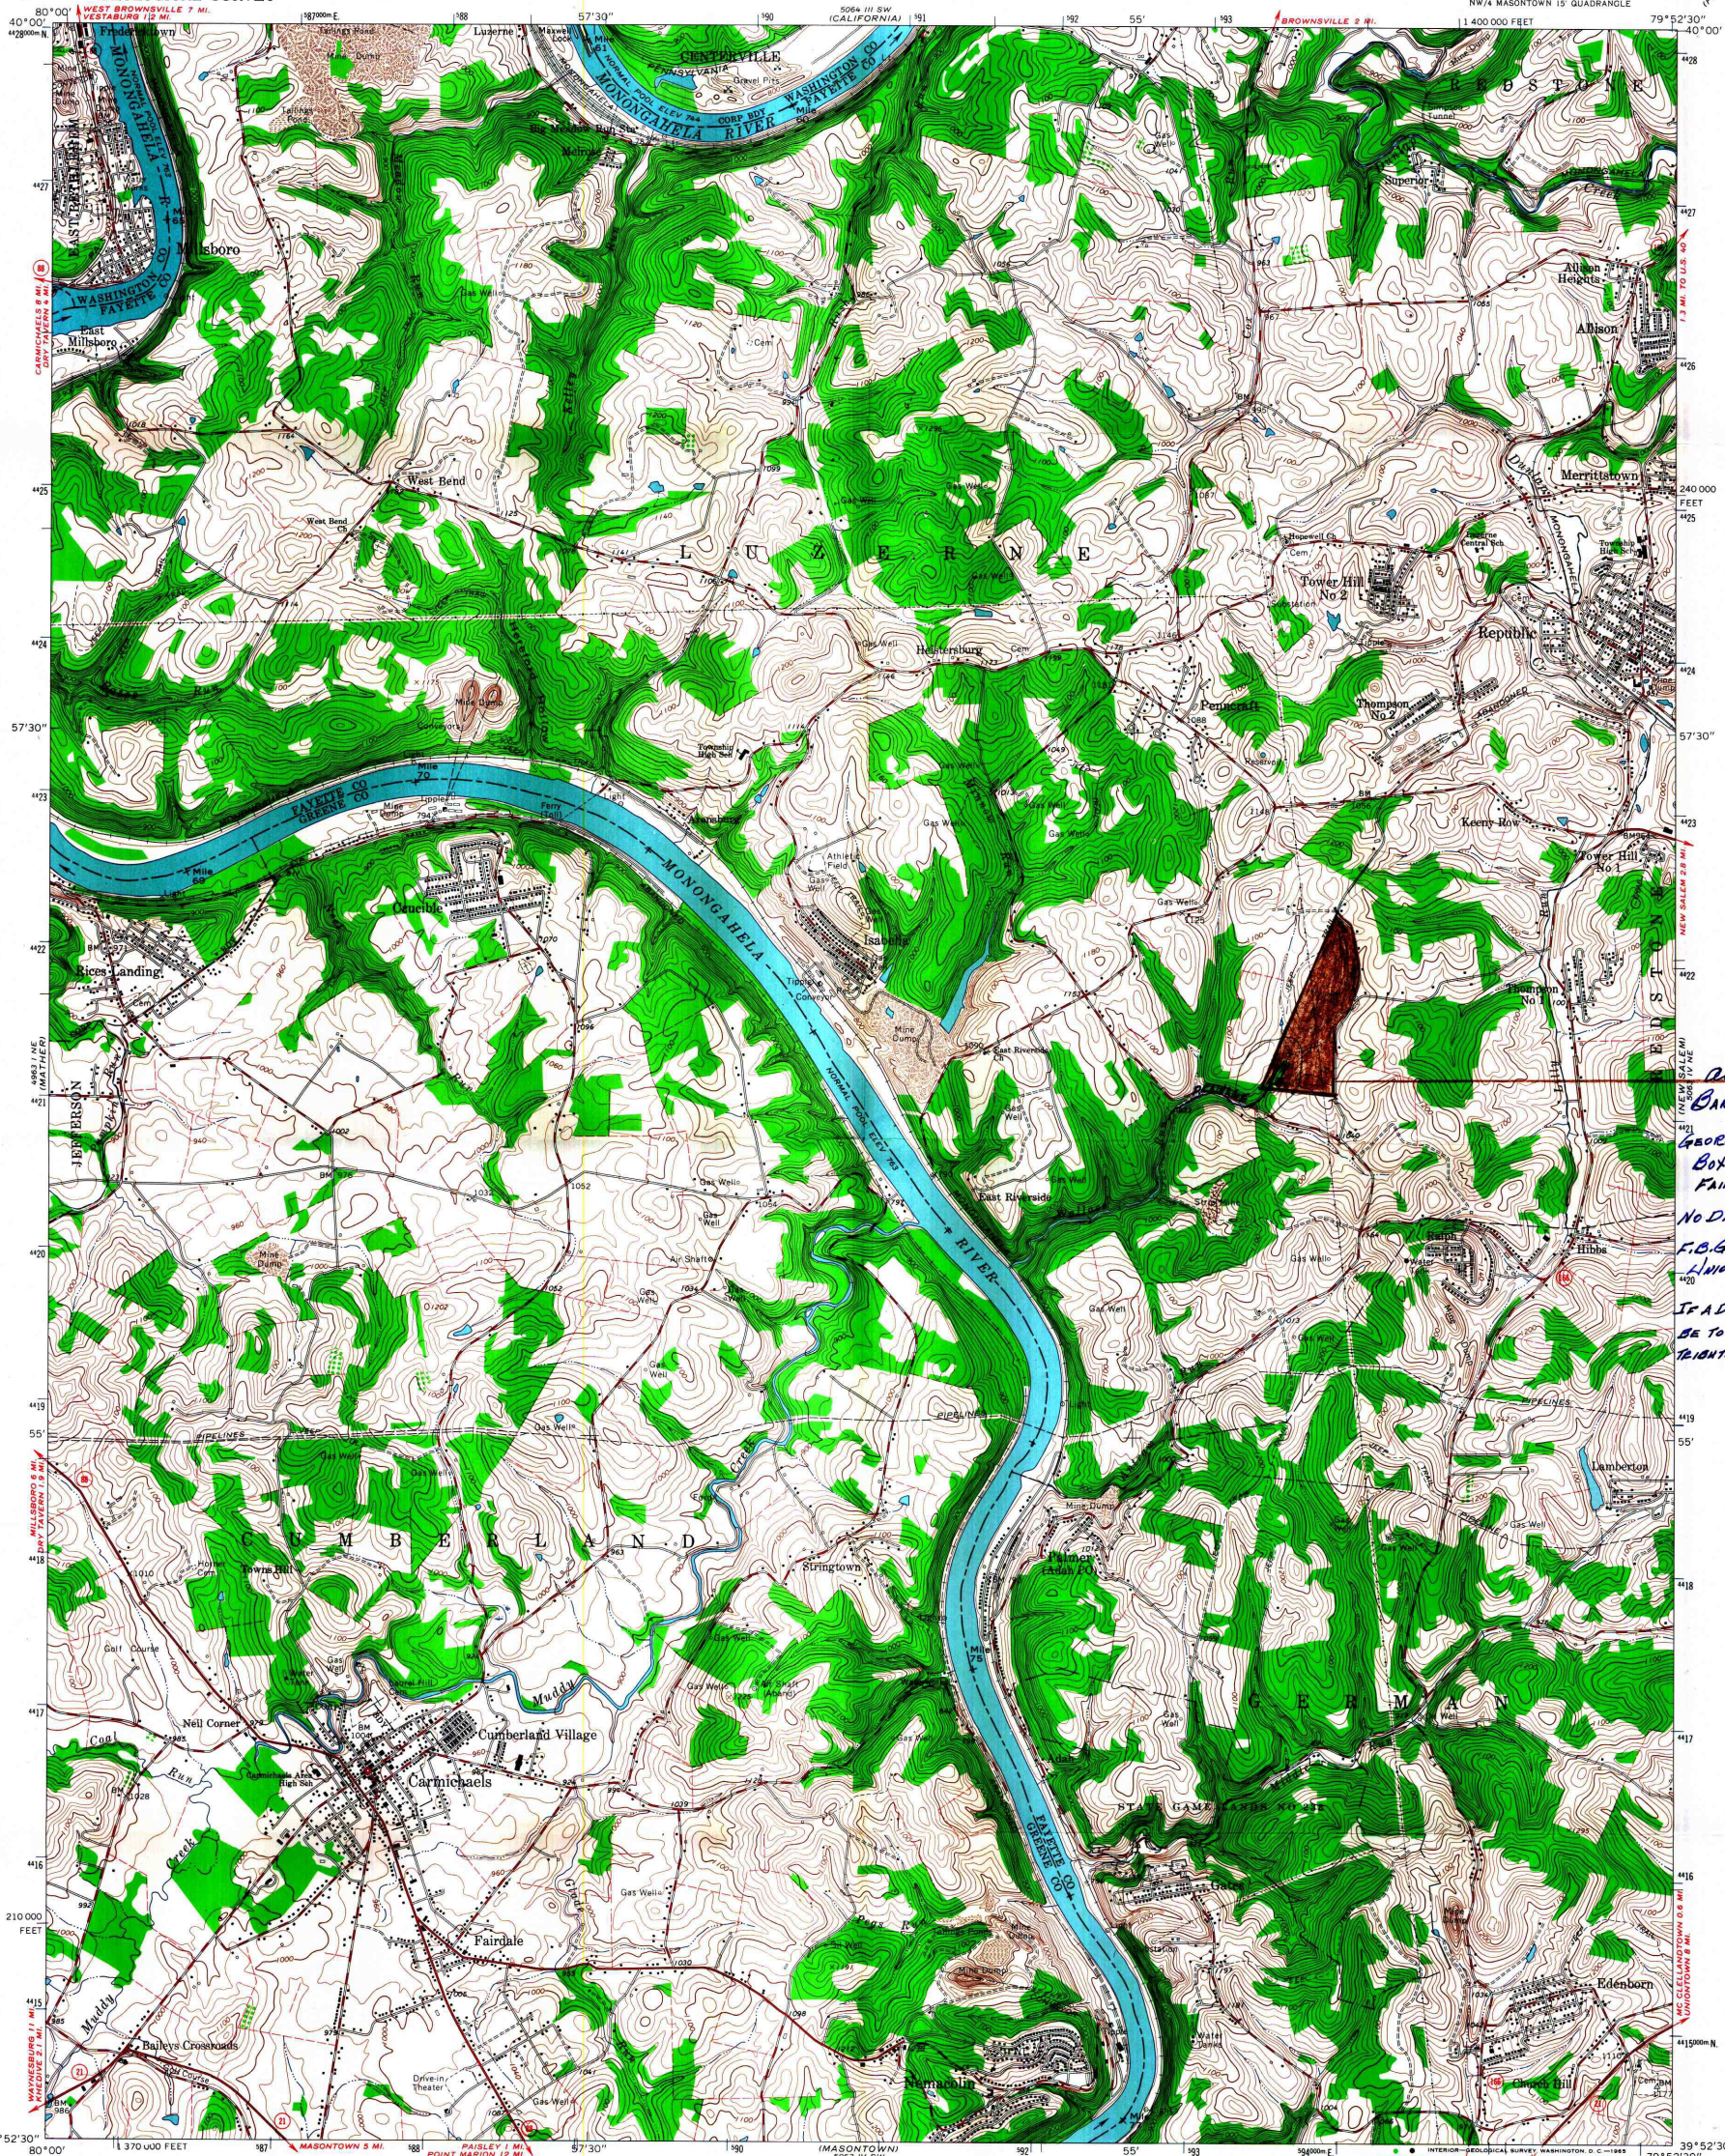


Red. 6.1966
Barry Mine
George Skovran Jr.
Box 215
Fairbanks, Pa 15433
No Discharge
F.C. Goodall
Linton, Pa
If a discharge it would be to an unnamed cwm tributary of Wallace Run

Mapped, edited, and published by the Geological Survey
Control by USGS, USC&GS, and USCE
Topography by photogrammetric methods from aerial photographs
taken 1962 and 1963. Field checked 1964
Polyconic projection. 1927 North American datum
10,000-foot grid based on Pennsylvania coordinate system, south zone
1000-meter Universal Transverse Mercator grid ticks
zone 17, shown in blue
Fine red dashed lines indicate selected fence and field lines where
generally visible on aerial photographs. This information is unchecked

UTM GRID AND 1964 MAGNETIC NORTH
DECLINATION AT CENTER OF SHEET

SCALE 1:24,000
CONTOUR INTERVAL 20 FEET
DATUM IS MEAN SEA LEVEL

ROAD CLASSIFICATION
Heavy-duty ——— Light-duty ———
Medium-duty ——— Unimproved dirt ———
State Route

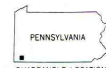

THIS MAP COMPLIES WITH NATIONAL MAP ACCURACY STANDARDS
FOR SALE BY U. S. GEOLOGICAL SURVEY, WASHINGTON, D. C. 20242
A FOLDER DESCRIBING TOPOGRAPHIC MAPS AND SYMBOLS IS AVAILABLE ON REQUEST

PEN-OR-WES-MAP COMPANY
PHONE 261-0645 511 MAGEE BLDG
336 FOURTH AVENUE PHILADELPHIA 19106

CARMICHAELS, PA.
NW 1/4 MASON TOWN 15 QUADRANGLE
N3952.5-W7952.5/7.5

1964

AMS 5063 IV NW—SERIES V831