


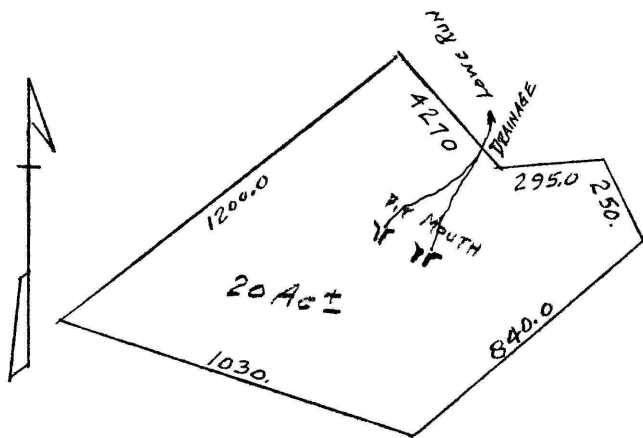

DEED PLOT
 PROPERTY OF
 NORMAN D. SPAW
 GEORGES TWP, FAYETTE CO., PA
 SCALE 1"=400' JULY 19, 1963

F.E. CO.
 UNIONTON 15, PA.

