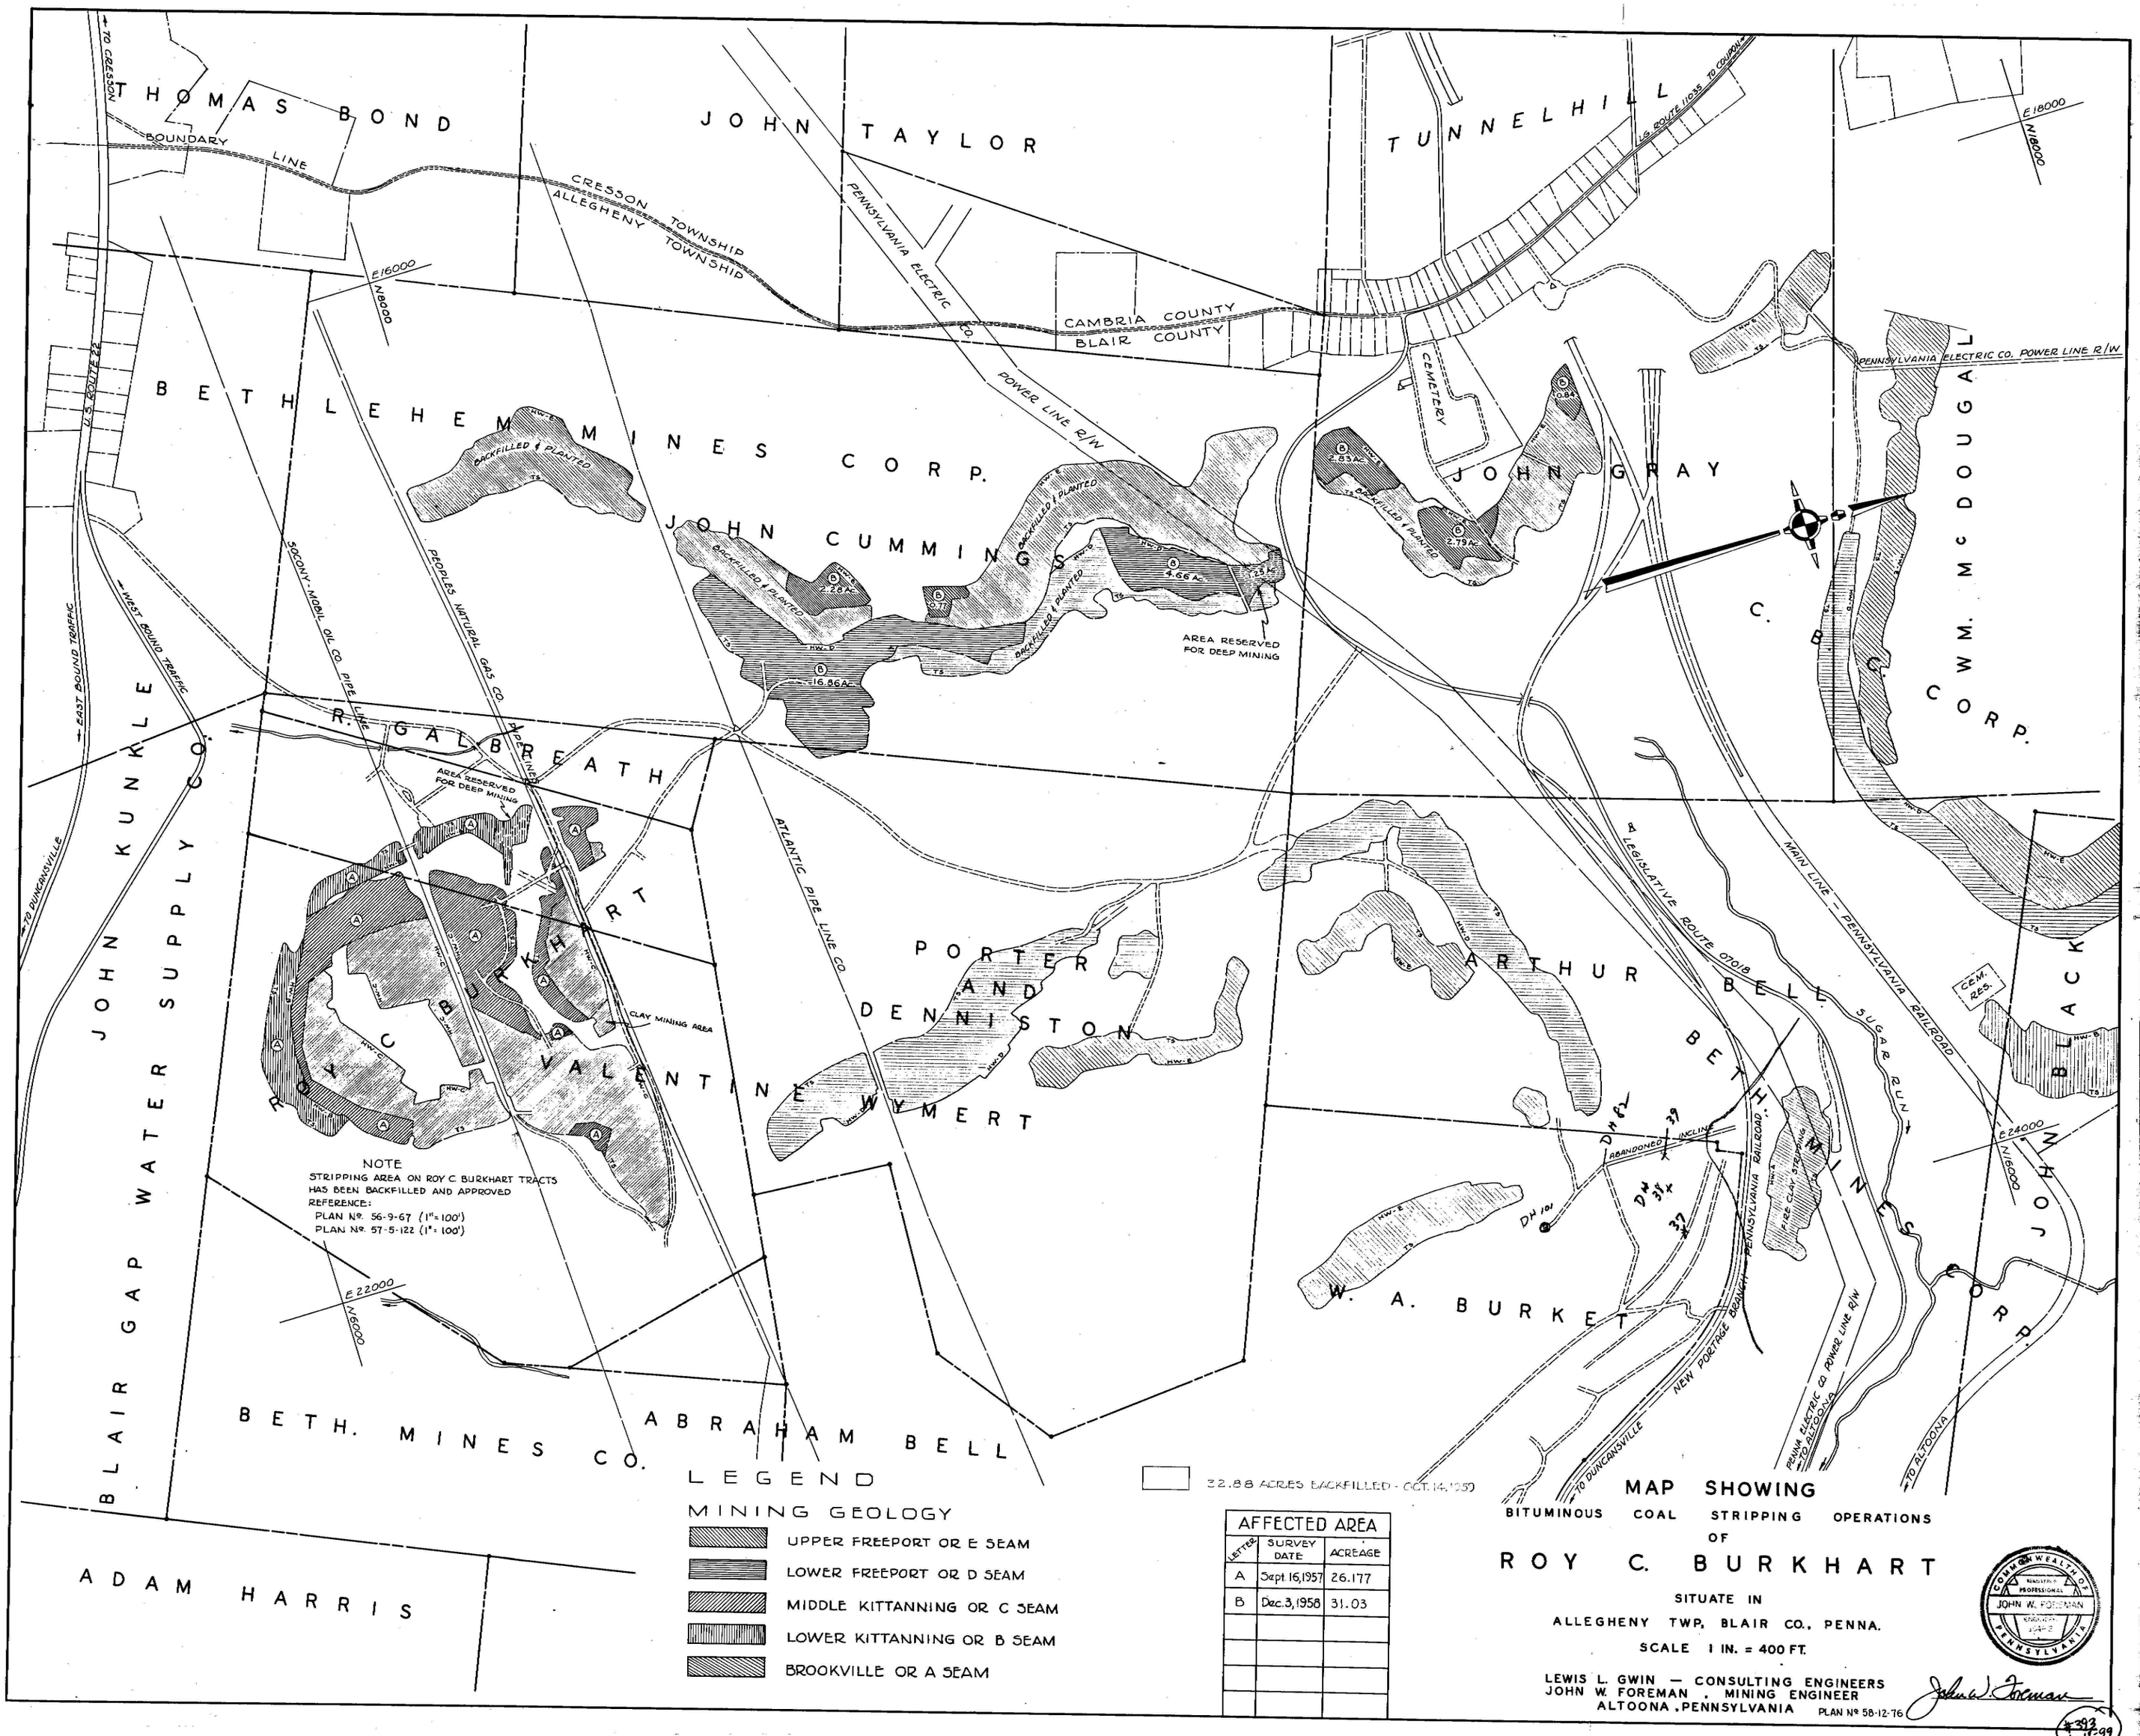
THOMAS BOND
BOUNDARY LINE
JOHN TAYLOR
TUNNELHILL
U.S. ROUTE 1035 TO COUDON
CRESSON TOWNSHIP
ALLEGHENY TOWNSHIP
PENNSYLVANIA ELECTRIC CO. POWER LINE R/W
CAMBRIA COUNTY
BLAIR COUNTY
CEMETERY
PENNSYLVANIA ELECTRIC CO. POWER LINE R/W
BETHLEHEM MINES CORP.
JOHN CUMMINGS
JOHN GRAY
C. B. C. CORP.
WM. McDOUGAL
U.S. ROUTE 22
TO CRESSON
EAST BOUND TRAFFIC
WEST BOUND TRAFFIC
SOCONY-MOBIL OIL CO. PIPE LINE
PEOPLES NATURAL GAS CO. PIPE LINE
ATLANTIC PIPE LINE CO.
JOHN KUNKLE
BLAIR GAP WATER SUPPLY CO.
TO DUNCANSVILLE
R. GALBREATH
AREA RESERVED FOR DEEP MINING
ROY C. BURKHART
CLAY MINING AREA
VALENTINE WYMERT
PORTER AND DENNISTON
ARTHUR BELL
BETH. MINES CORP.
LEGISLATIVE ROUTE 0701B
MAIN LINE - PENNSYLVANIA RAILROAD
SUGAR RUN
CEM. RES.
BLACK
JOHN
ABANDONED INCLINE
PENNSYLVANIA RAILROAD
FIRE CLAY STRIPPING
W. A. BURKET
NEW PORTAGE BRANCH
PENNA. ELECTRIC CO. POWER LINE R/W
TO ALTOONA
BETH. MINES CO.
ABRAHAM BELL
ADAM HARRIS
E 16000
N 18000
E 18000
N 18000
E 22000
N 16000
E 24000
N 16000
NOTE
STRIPPING AREA ON ROY C. BURKHART TRACTS HAS BEEN BACKFILLED AND APPROVED
REFERENCE:
PLAN Nº 56-9-67 (1" = 100')
PLAN Nº 57-5-122 (1" = 100')
LEGEND
MINING GEOLOGY
UPPER FREEPORT OR E SEAM
LOWER FREEPORT OR D SEAM
MIDDLE KITTANNING OR C SEAM
LOWER KITTANNING OR B SEAM
BROOKVILLE OR A SEAM
32.88 ACRES BACKFILLED - OCT. 14, 1959
AFFECTED AREA
LETTER | SURVEY DATE | ACREAGE
A | Sept. 16, 1957 | 26.177
B | Dec. 3, 1958 | 31.03
MAP SHOWING
BITUMINOUS COAL STRIPPING OPERATIONS
OF
ROY C. BURKHART
SITUATE IN
ALLEGHENY TWP. BLAIR CO., PENNA.
SCALE 1 IN. = 400 FT.
LEWIS L. GWIN — CONSULTING ENGINEERS
JOHN W. FOREMAN . MINING ENGINEER
ALTOONA, PENNSYLVANIA
PLAN Nº 58-12-76
COMMONWEALTH OF PENNSYLVANIA
REGISTERED PROFESSIONAL
JOHN W. FOREMAN
REGISTRATION 1942
PENNSYLVANIA