




APRIL 29, 1964
NEWMAN DEEP MINE
RHANE-ARNOLD COAL CO
70 KENSINGTON STREET
UNIONTOWN, PA.
WATERSHED
JENNINGS RUN
F.B. GONNALL RPE
UNIONTOWN, PA.

H.M. Wilson, Geographer in charge.
Control by S.S. Gannett, Sledge Tatum, and A.C. Roberts.
Topography by Frank Sutton, R.D. Cummin, and H.C. Frick Coke Co.
Surveyed in 1899 in cooperation with the State of Pennsylvania.
Culture in Fayette County part revised in 1930-1931 by
J.H. Wilke and C.S. Wells.

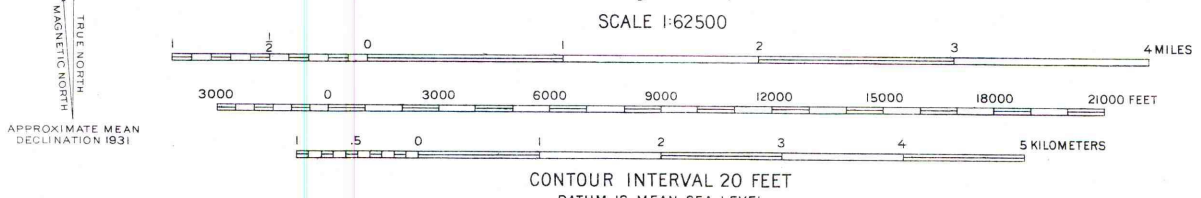

INTERIOR - GEOLOGICAL SURVEY, WASHINGTON, D. C. 1957
Polyconic projection, 1927 North American datum
MASONTOWN, PA.
N3945-W7945/15
1931