


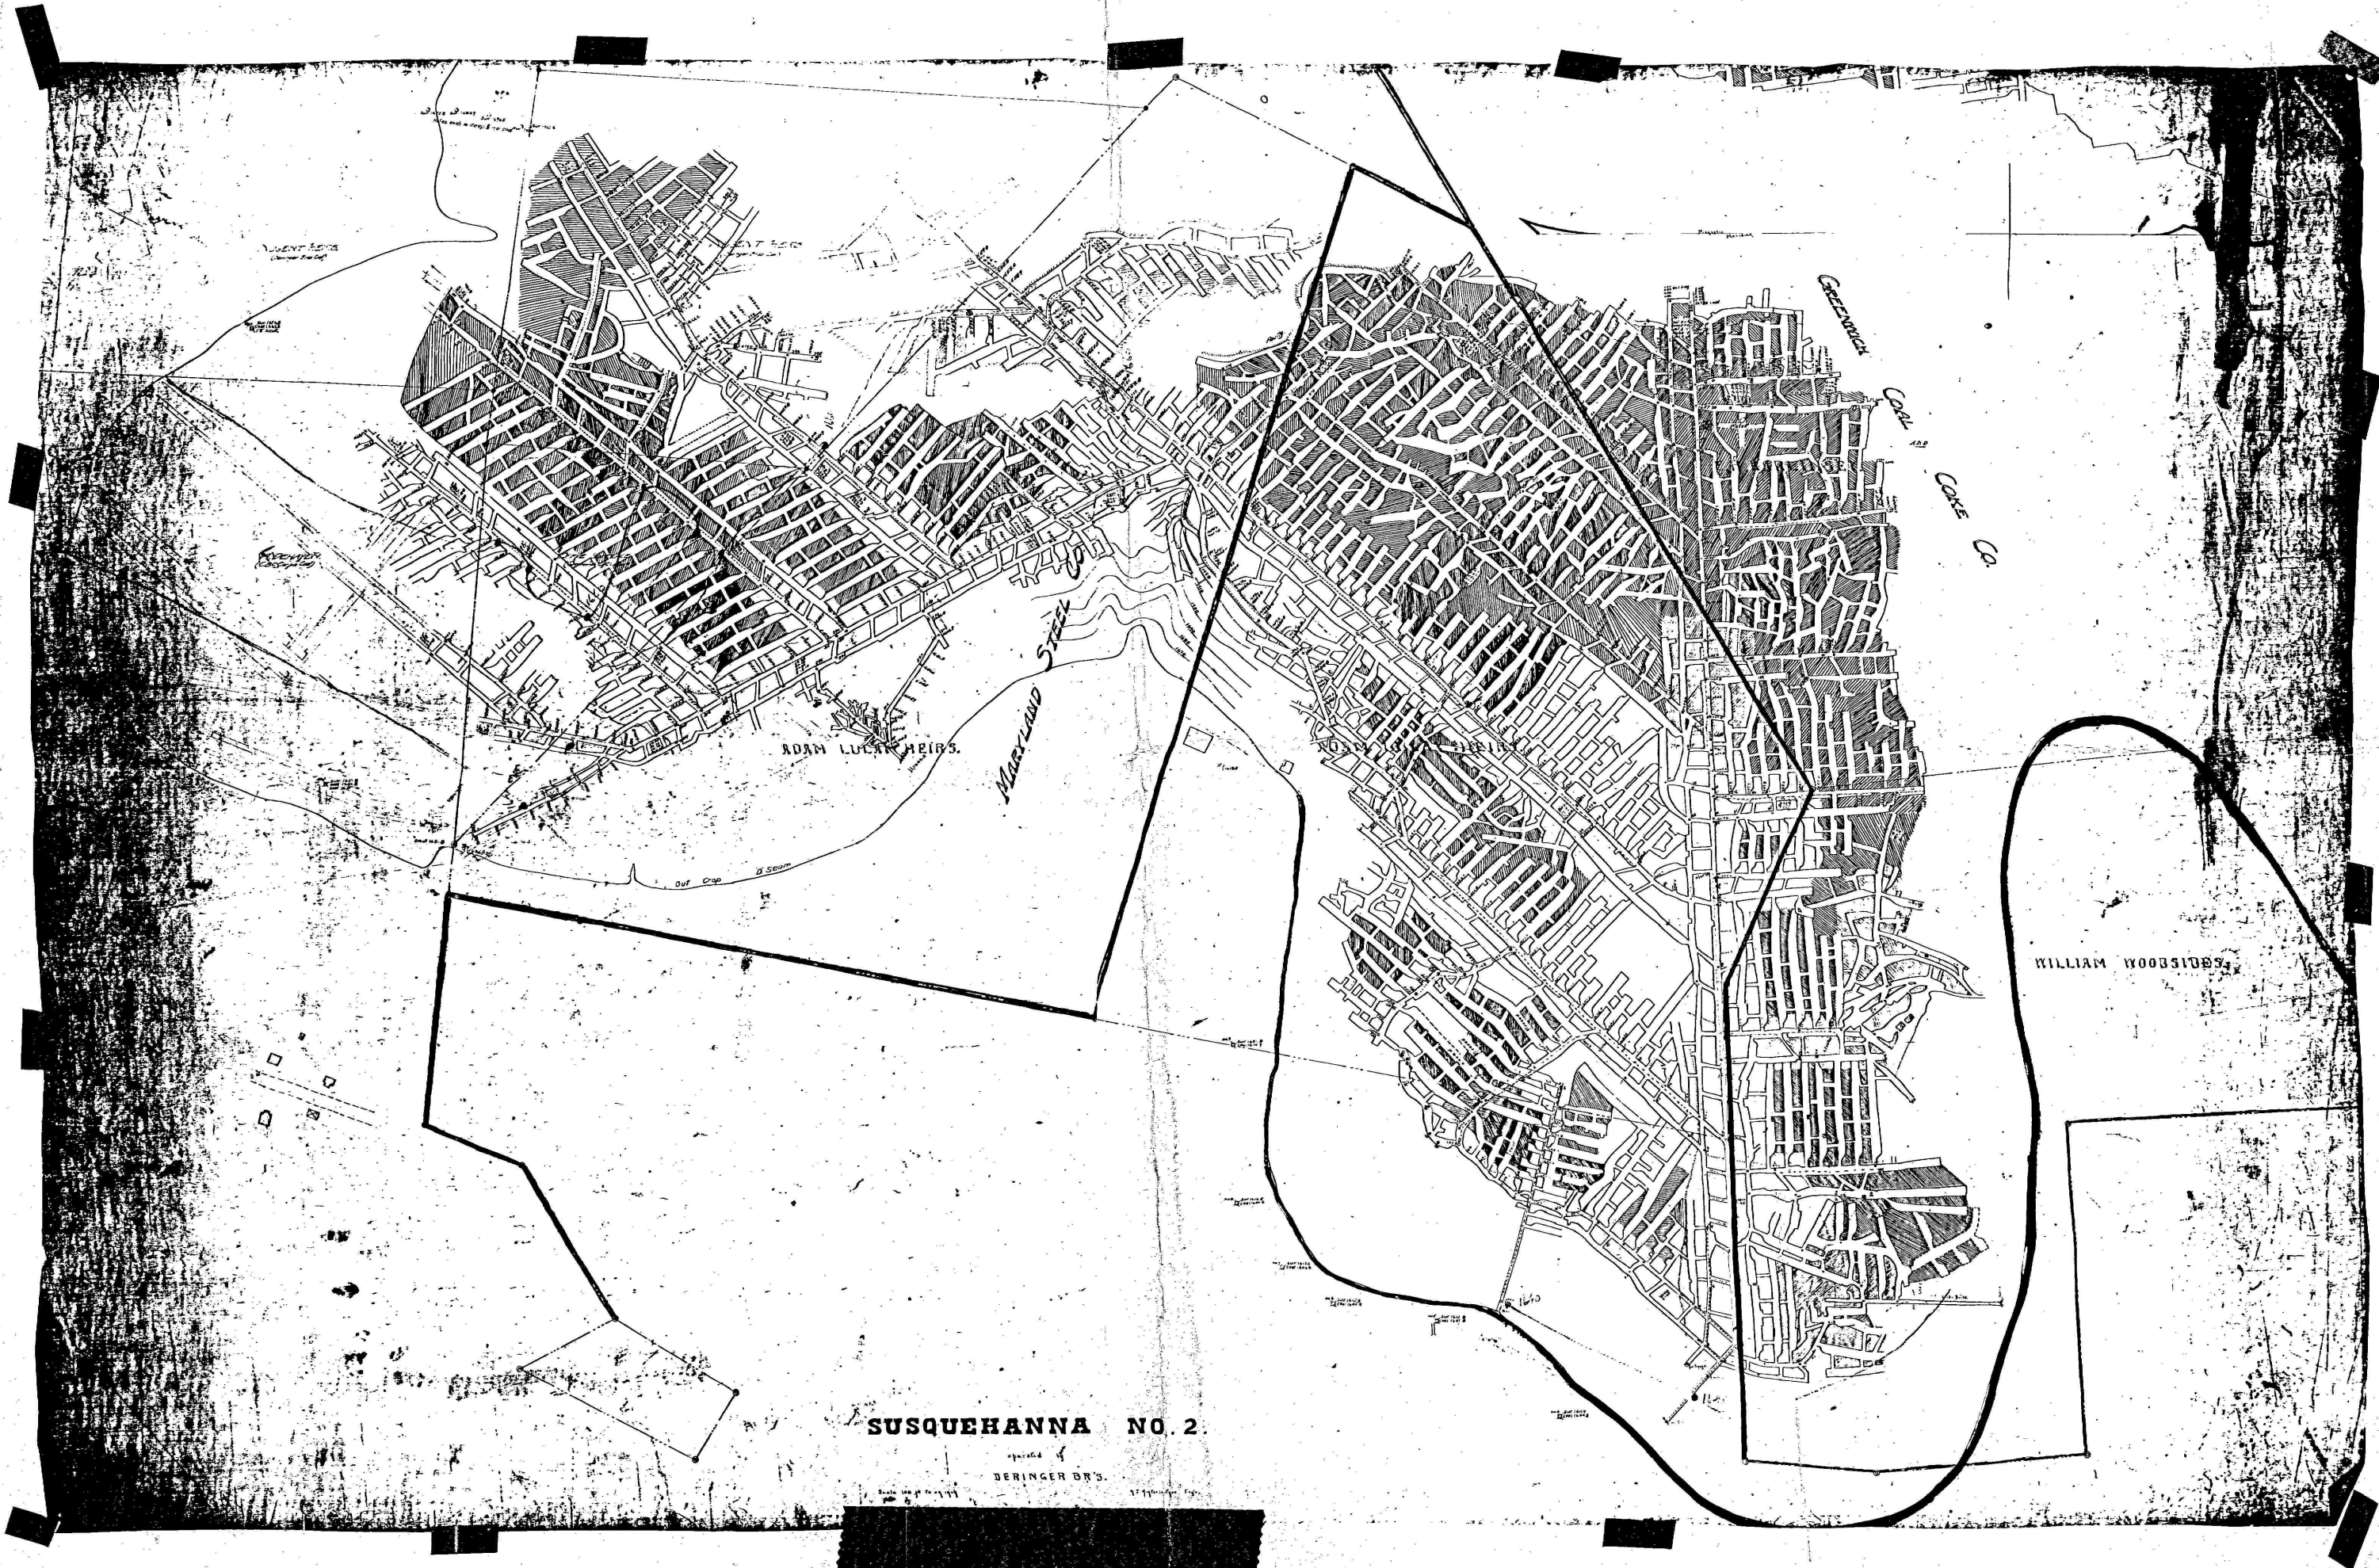

SUSQUEHANNA NO. 2

DERINGER DR.

