


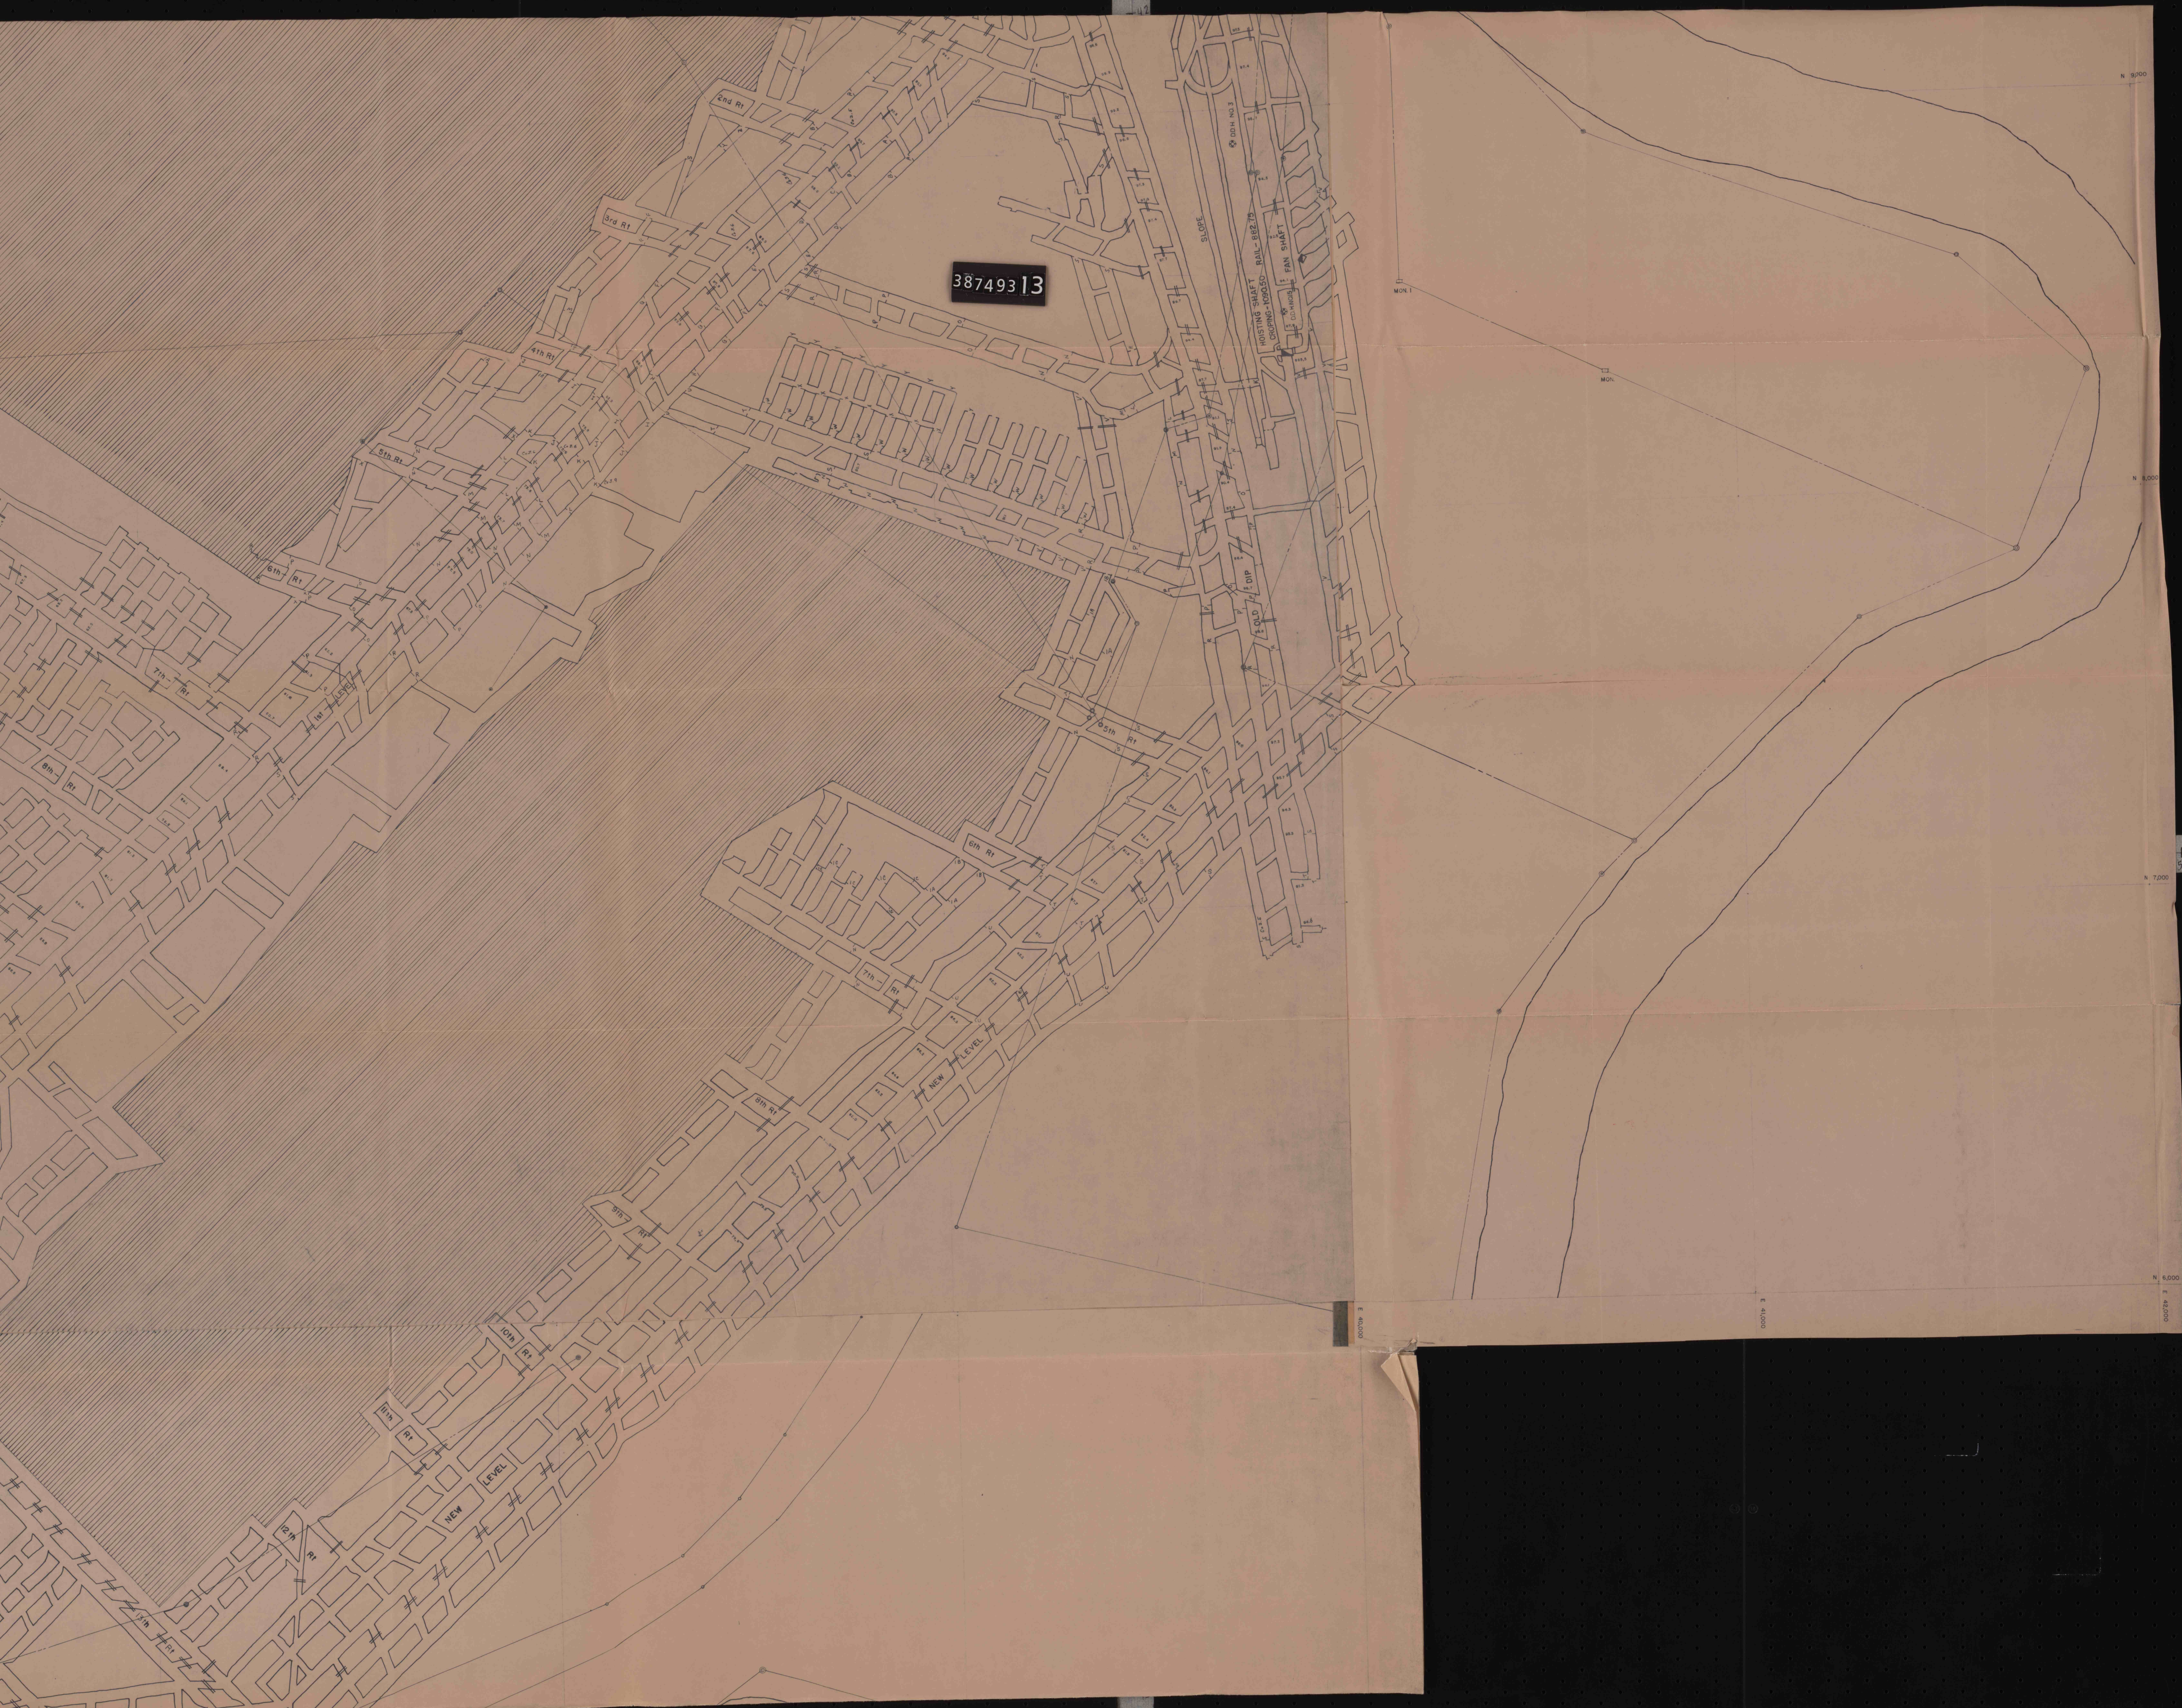

38749313

N 9,000

N 8,000

N 7,000

N 6,000














