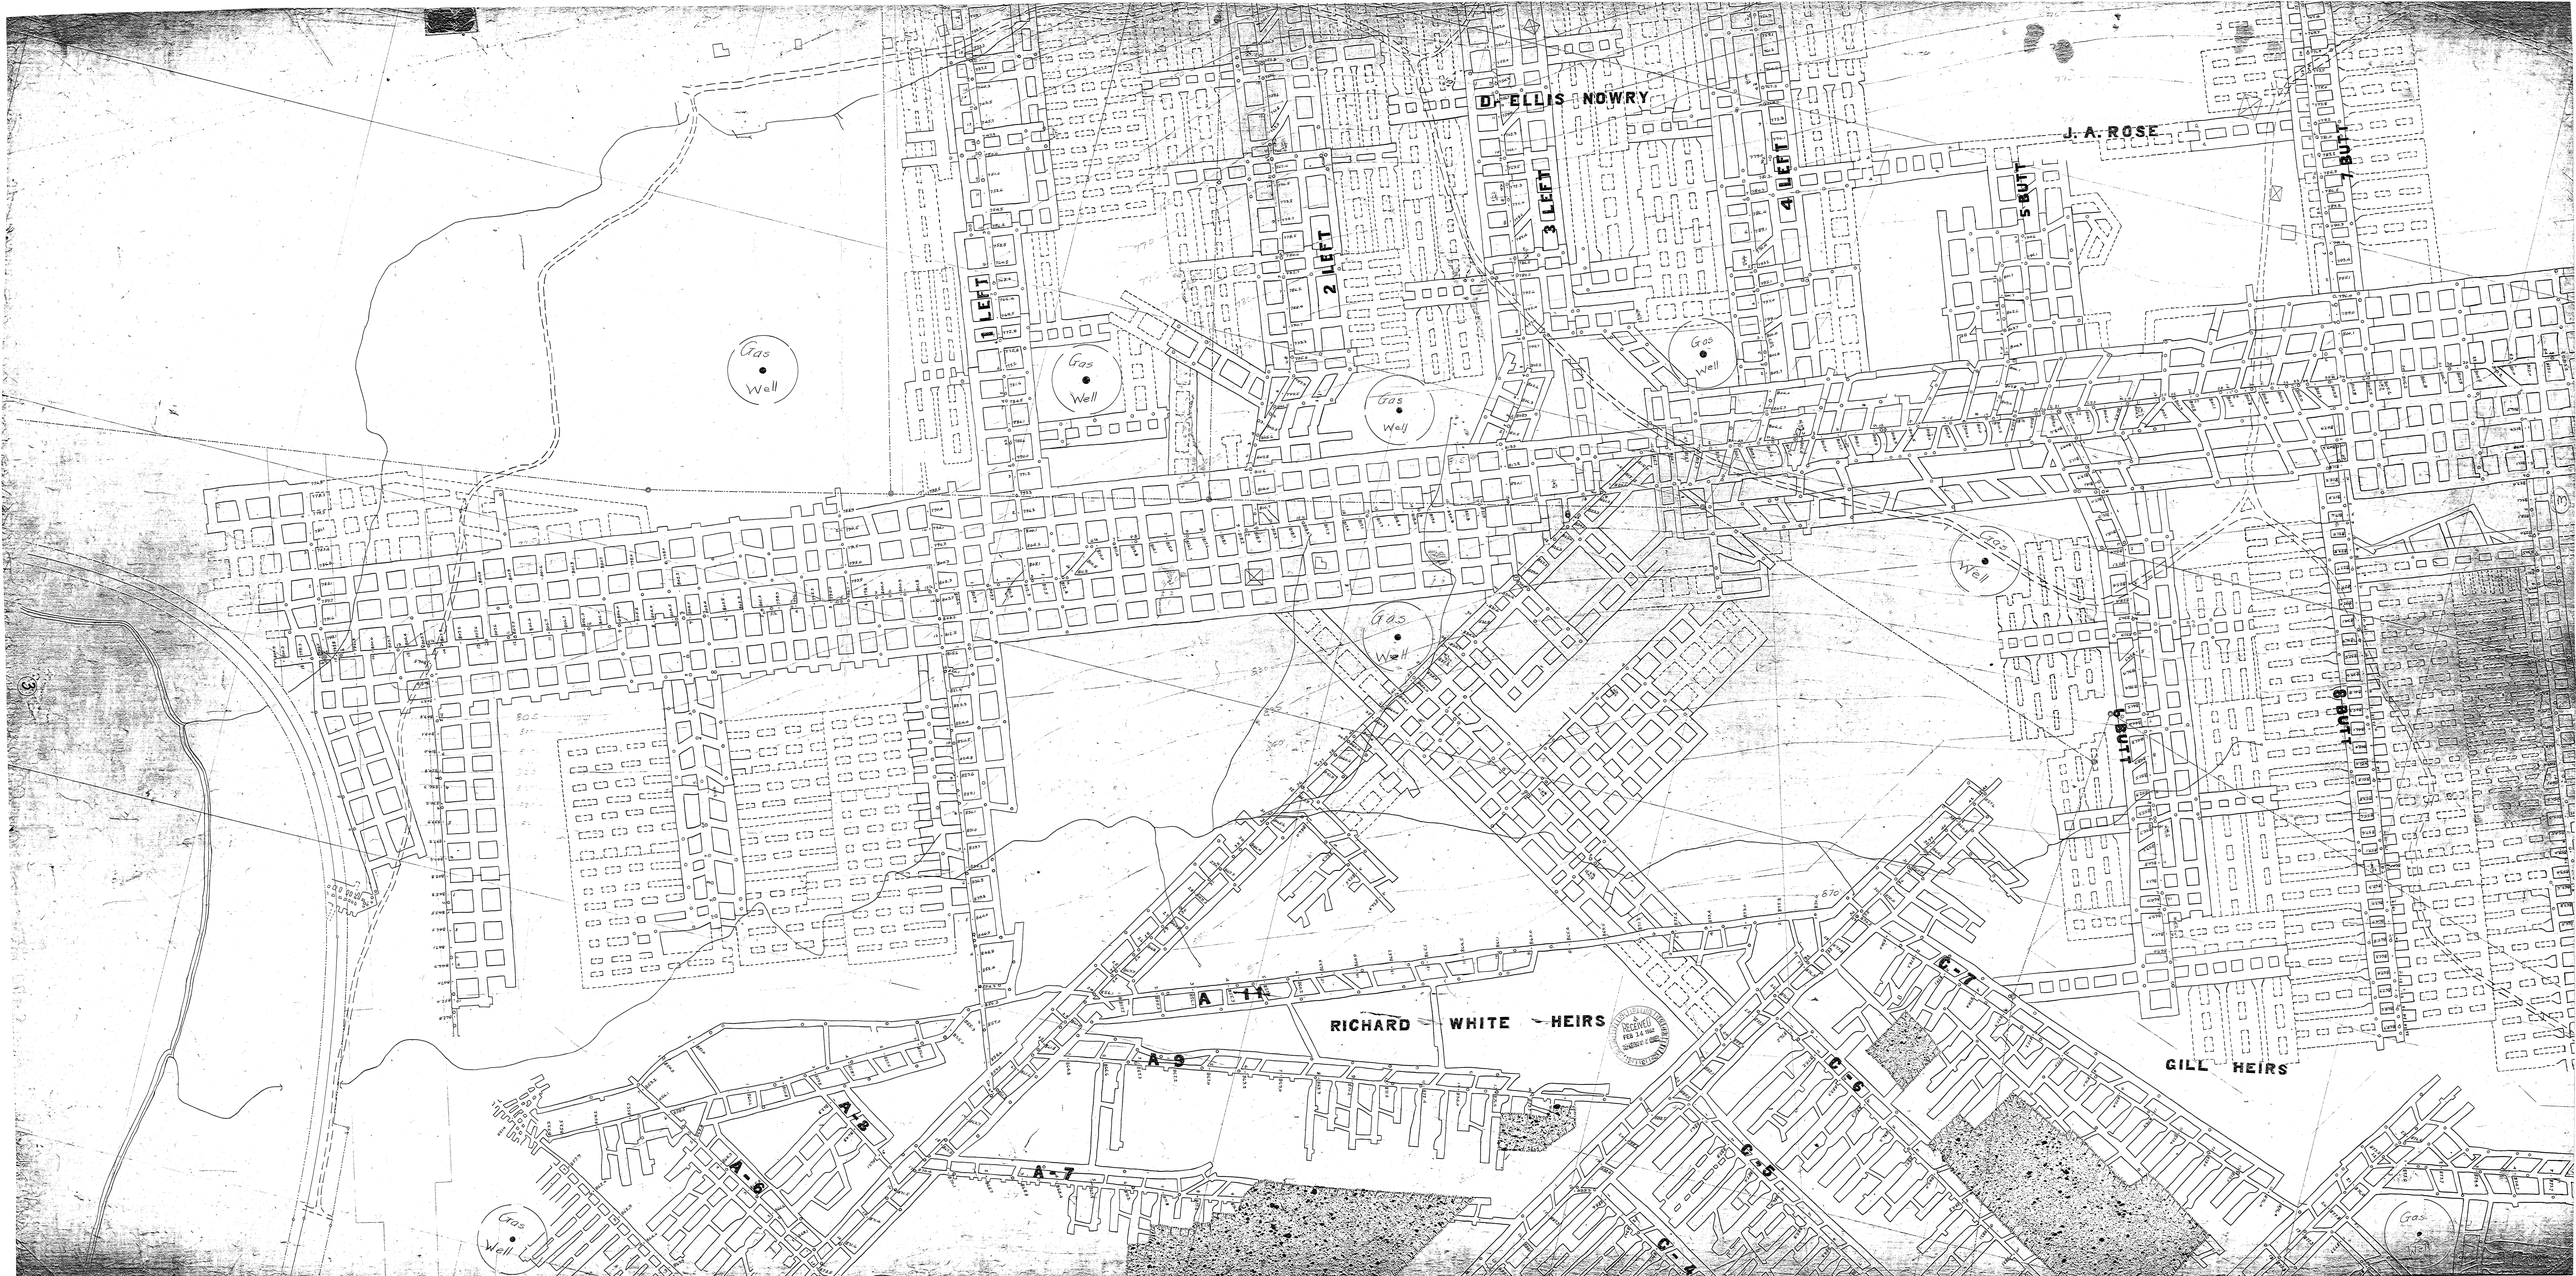
D. ELLIS NOWRY
J. A. ROSE
1 LEFT
2 LEFT
3 LEFT
4 LEFT
5 BUTT
7 BUTT
6 BUTT
4 BUTT
Gas Well
A 11
A 9
A-7
A-6
A-2
RICHARD WHITE HEIRS
GILL HEIRS
C-7
C-6
C-5
RECEIVED
FEB 24 1941