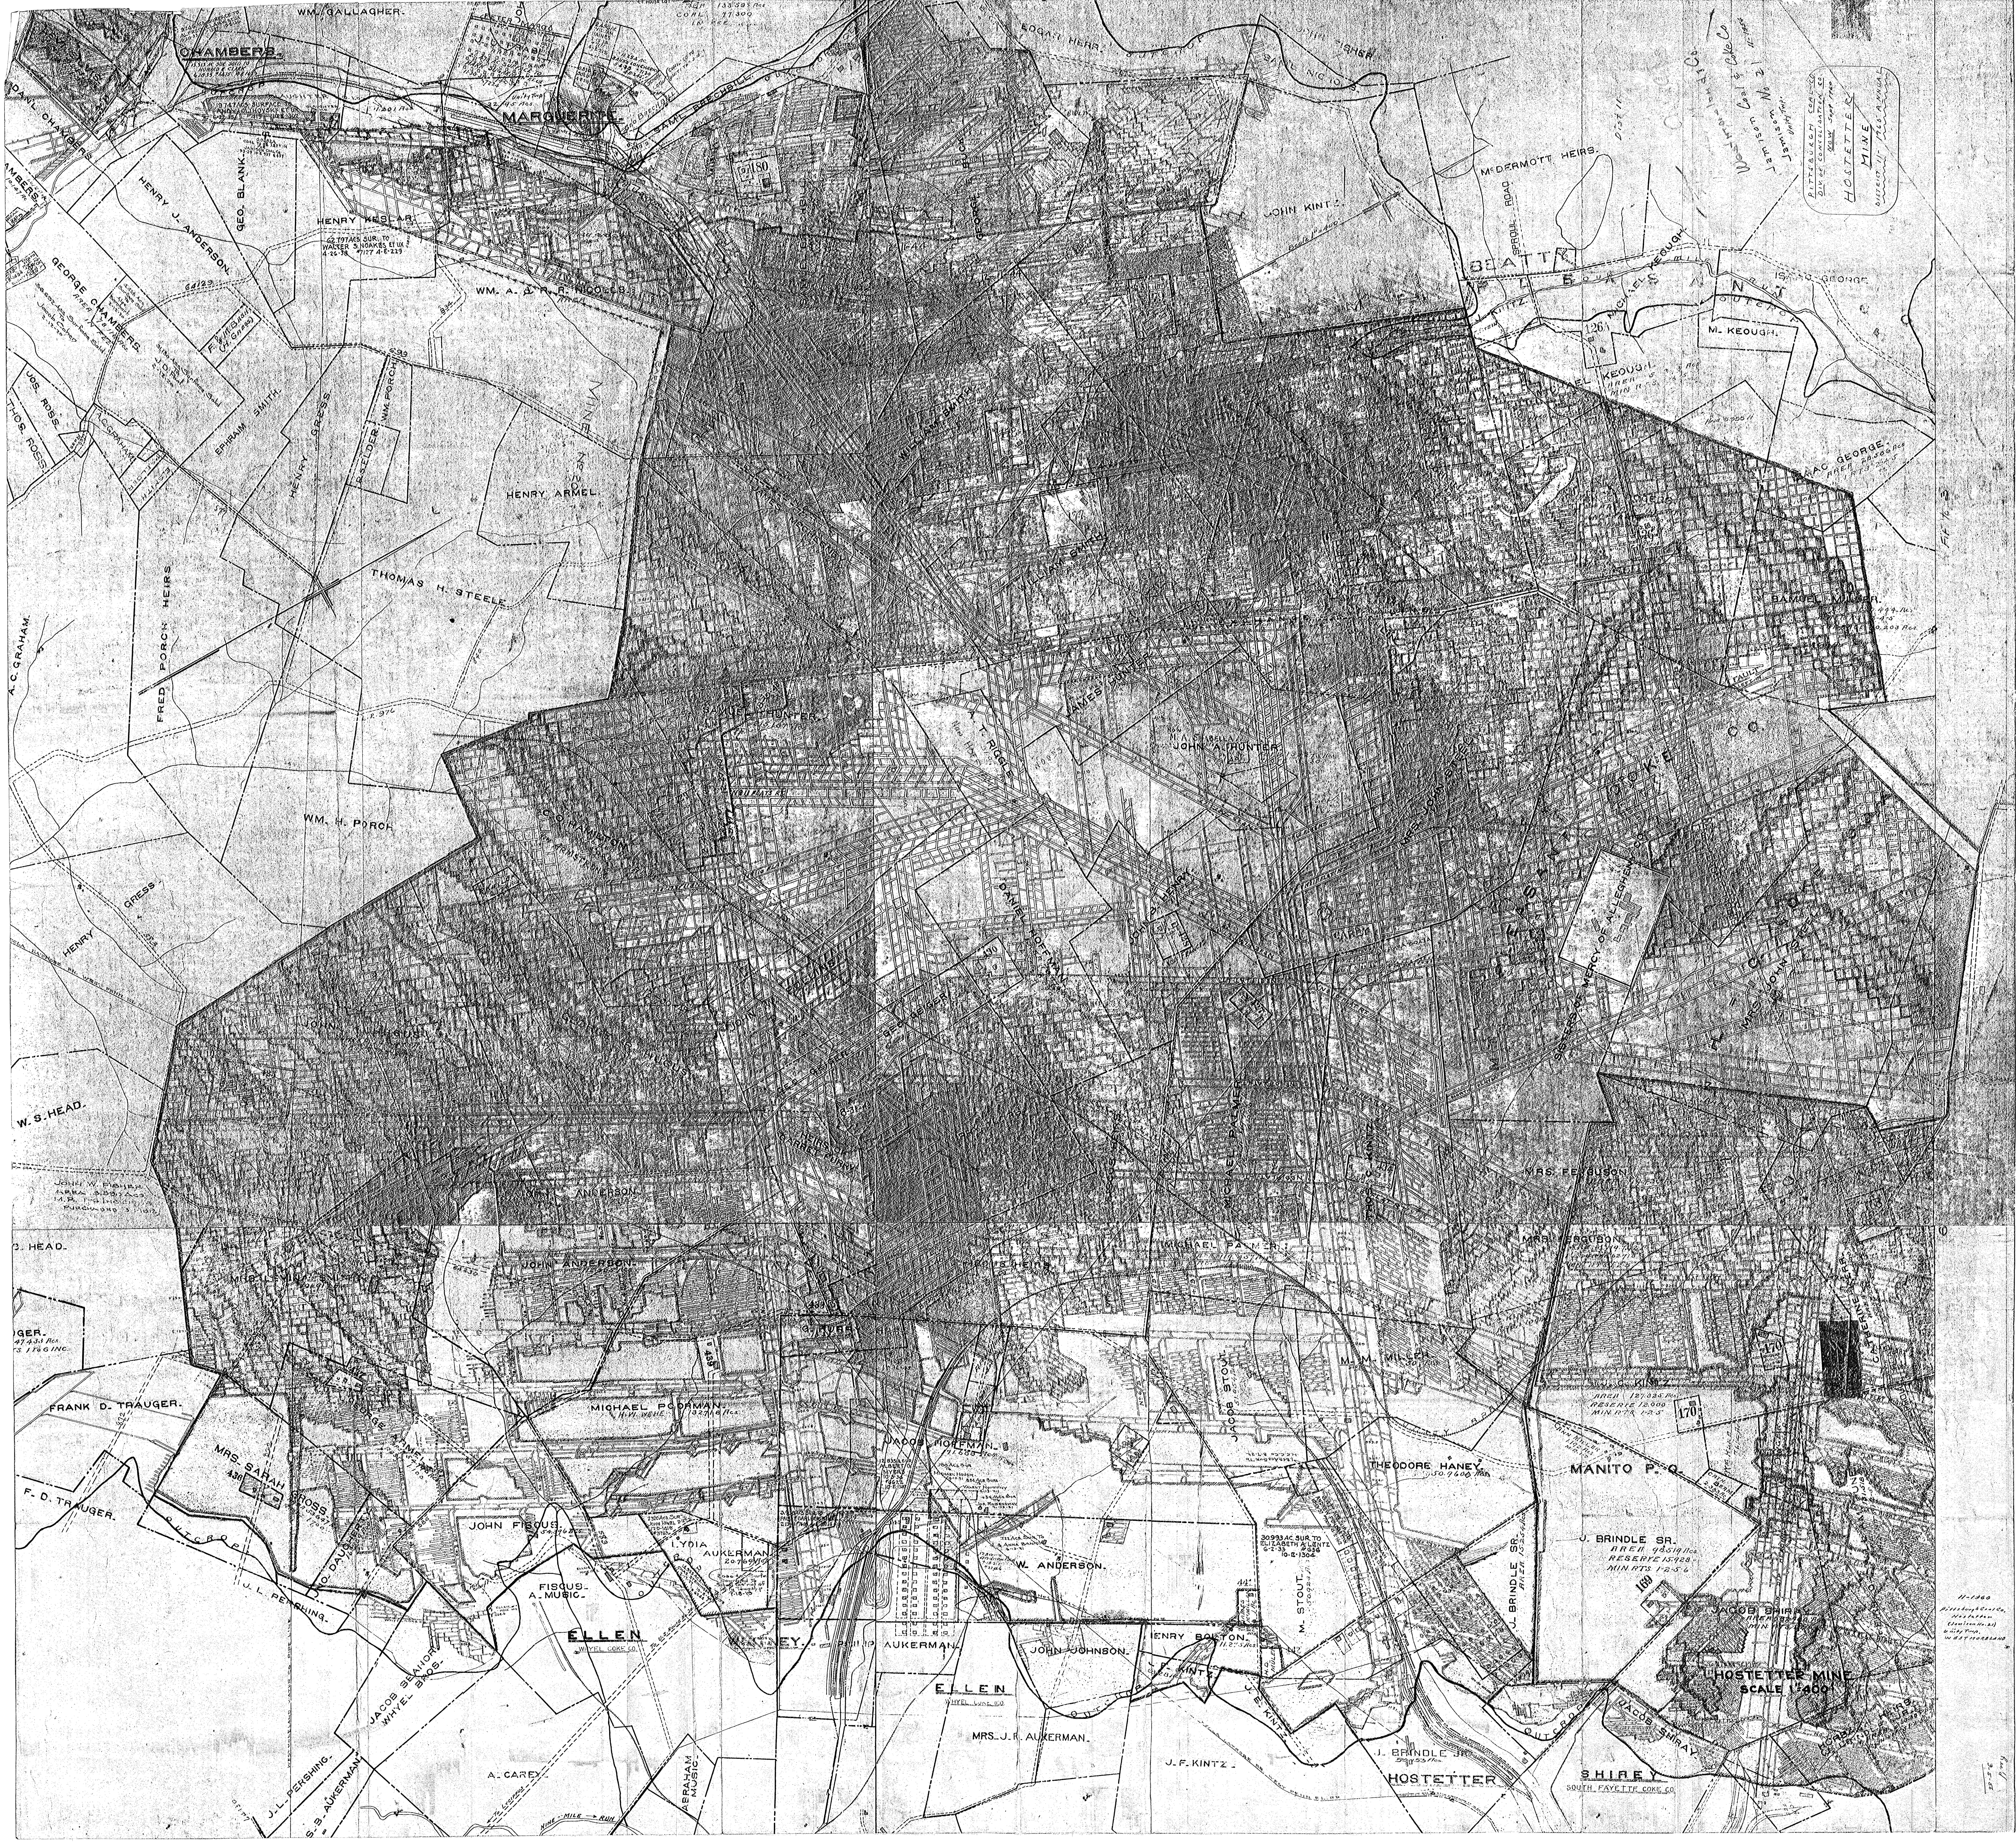
PITTSBURGH COAL CO
DIV. OF CONSOLIDATION CO.
NOW Sept 1960
HOSTETTER MINE
DISTRICT 11 - 1960 ANNUAL
Westmoreland Coal & Coke Co
Jamison No 21
Jamison No 21 11-1954
Unity Twp.
HOSTETTER MINE
SCALE 1"=800'
CHAMBERS
MARGUERITE
WM. GALLAGHER
HENRY J. ANDERSON
GEO. BLANK
HENRY KESLAR
GEORGE CHAMBERS
WM. A. & R. R. NICOLLS
EPHRAIM SMITH
HENRY GRESS
HENRY ARMEL
THOMAS H. STEELE
FRED PORCH HEIRS
A. C. GRAHAM
JOS. ROSS
THOS. ROSS
WM. H. PORCH
HENRY GRESS
W. S. HEAD
C. HEAD
FRANK D. TRAUGER
F. D. TRAUGER
MRS. SARAH GROSS
J. L. PERSHING
JOHN FISCUS
FISCUS - A. MUSIC
ELLEN
WHYEL COKE CO.
LYDIA AUKERMAN
MICHAEL POORMAN
JACOB HOFFMAN
W. ANDERSON
PHILIP AUKERMAN
JOHN JOHNSON
HENRY BOLTON
MRS. J. R. AUKERMAN
J. F. KINTZ
A. CAREY
GRAHAM MUSIC
S. B. AUKERMAN
JACOB SEANOR
WHYEL BROS.
HOSTETTER
SHIREY
SOUTH FAYETTE COKE CO.
J. BRINDLE JR.
J. BRINDLE SR.
JACOB SHIRAY
M. STOUT
JACOB STOUT
THEODORE HANEY
MANITO P. O.
M. M. MILLER
MICHAEL PALMER
MRS. FERGUSON
JOHN ANDERSON
JAMES CONER
JOHN A. HUNTER
SISTERS OF MERCY OF ALLEGHENY CO.
DANIEL HOFFMAN
ISAAC GEORGE
DANIEL MILLER
M. KEOUGH
MICHAEL KEOUGH
BEATTY
McDERMOTT HEIRS
JOHN KINTZ
SPROUL ROAD
EDGAR HEIRS
OUTCROP
NINE - MILE - RUN
JOHN W. FISHER
170
126
169
180

11-1960

Pittsburgh Coal Co.
Hostetter
(Jamison No. 21)
Unity Twp.
WESTMORELAND