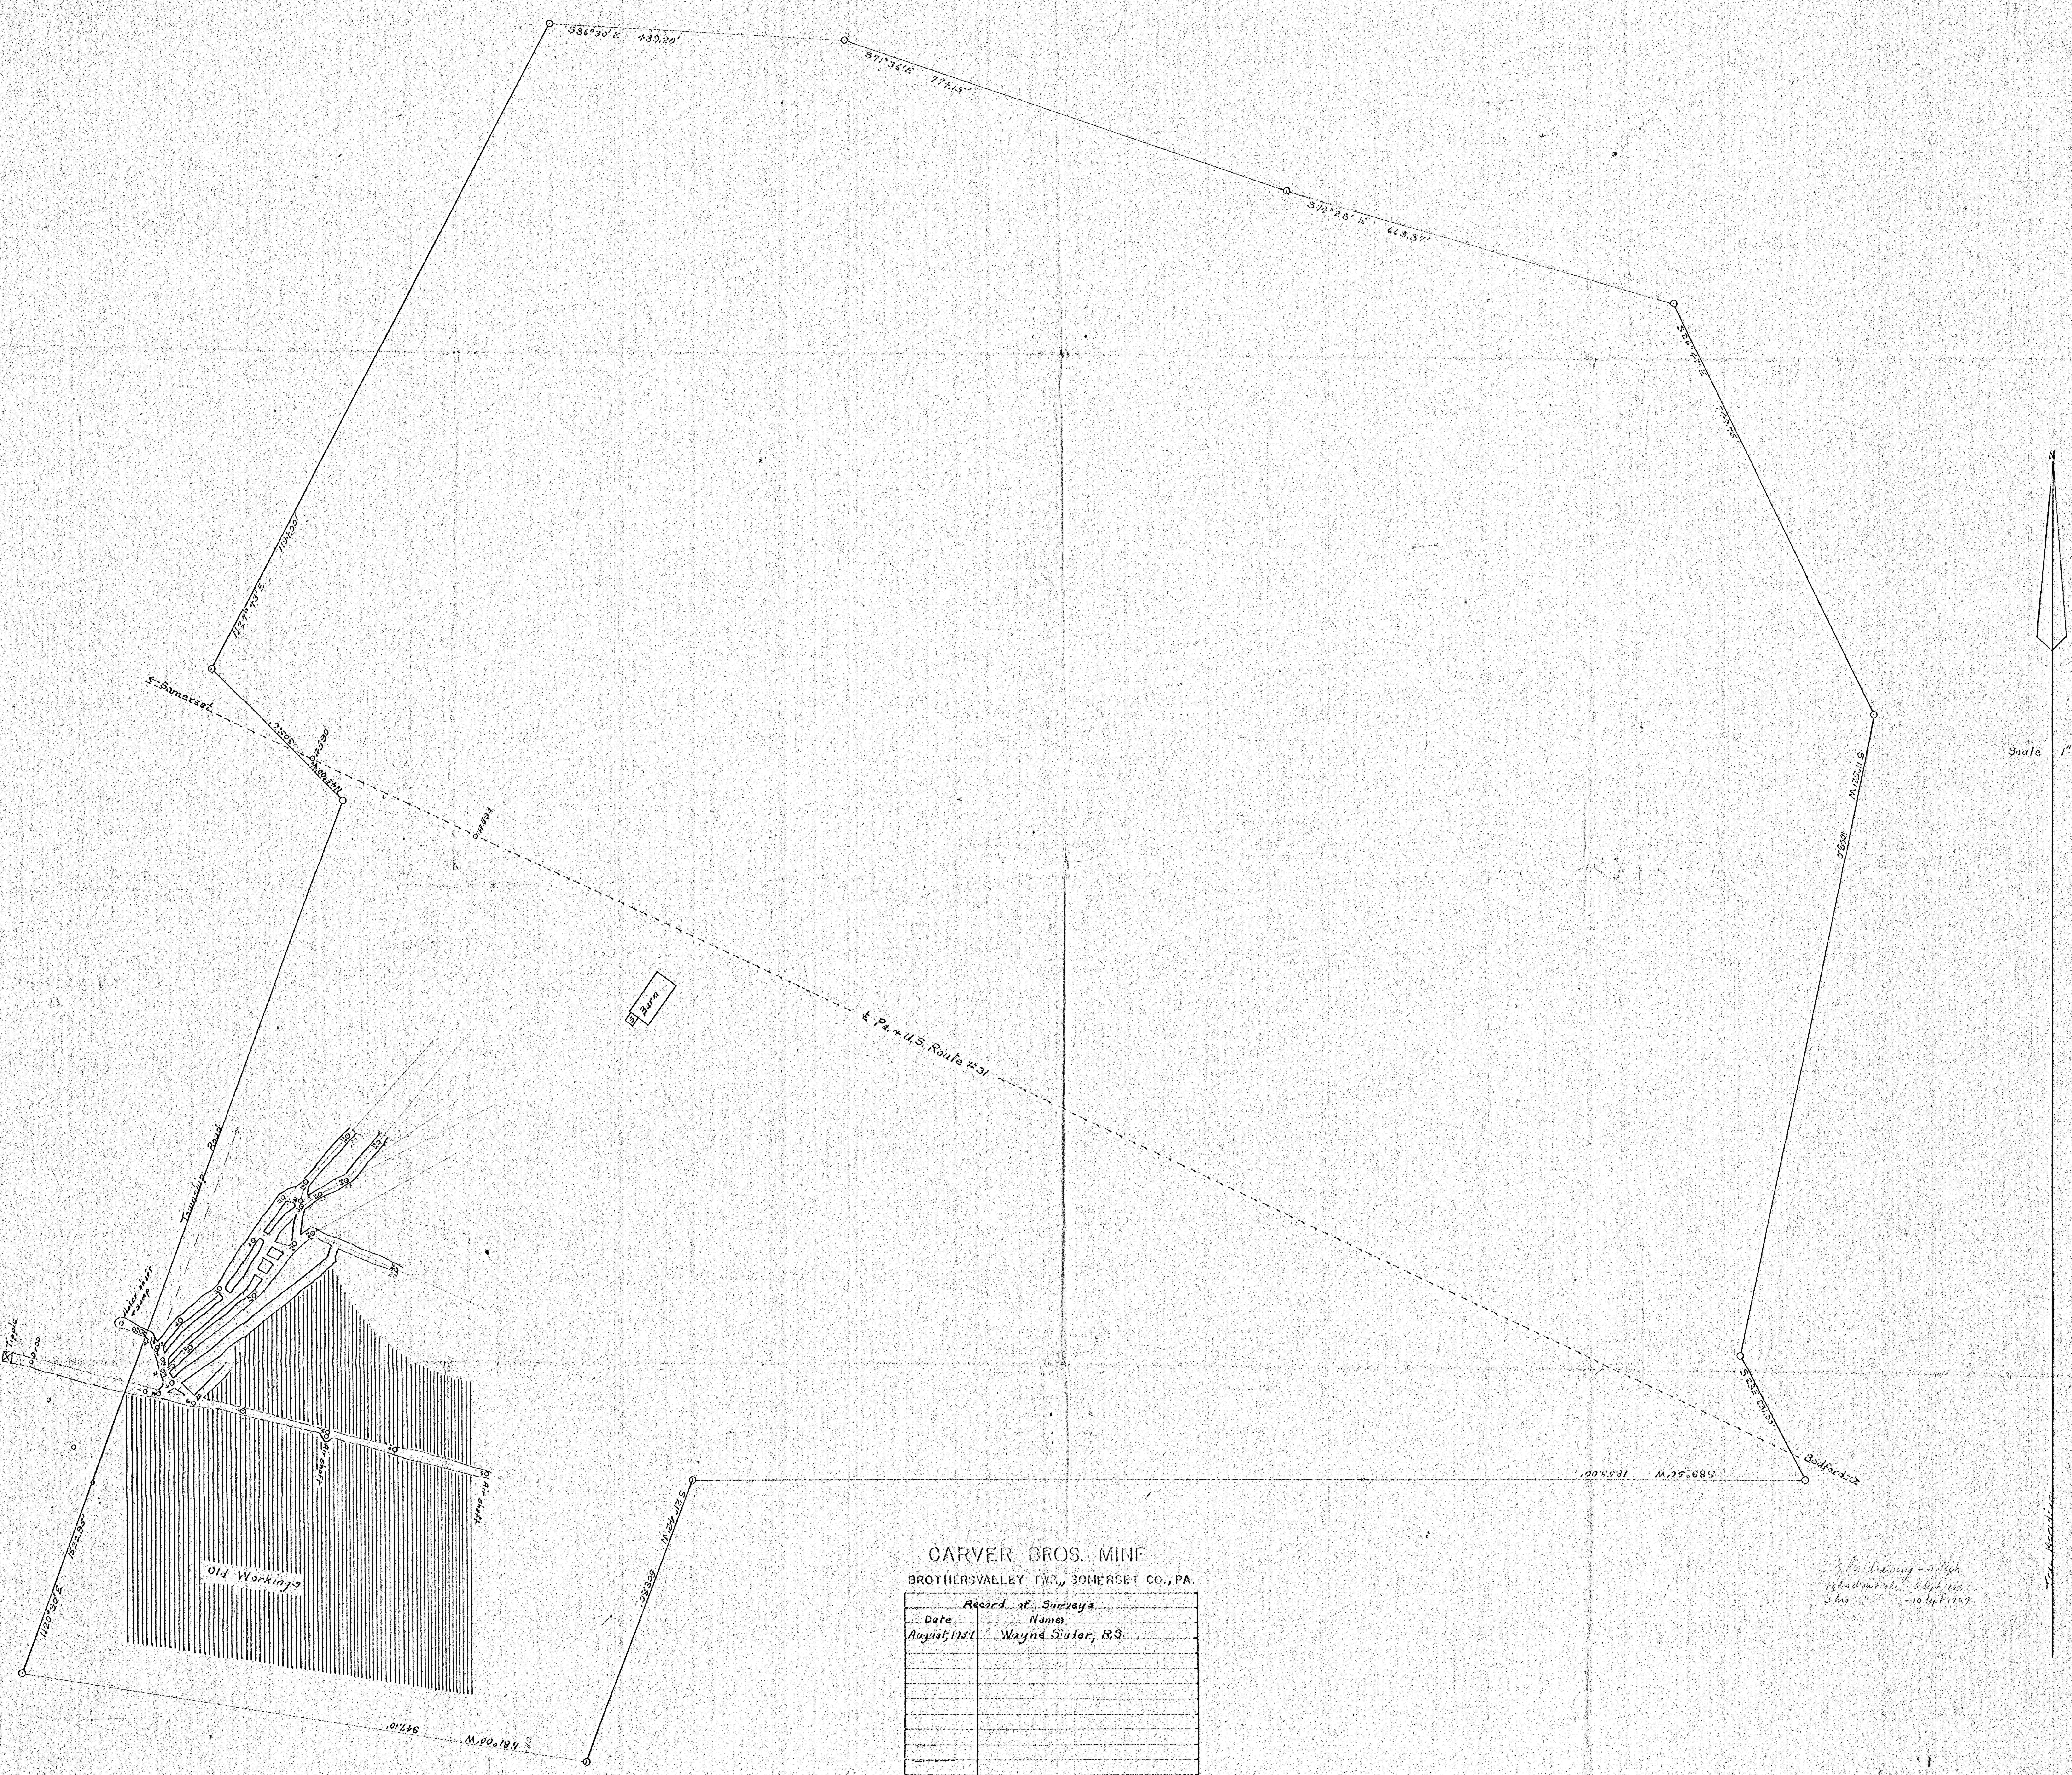

# CARVER BROS. MINE

BROTHERSVALLEY TWP., SOMERSET CO., PA.

Record of Surveys

| Date | Name |
|---|---|
| August, 1951 | Wayne Sluder, R.S. |

½ hr. Drawing – 3 Sept.
1½ hrs drawing – 5 Sept 1957
3 hrs " – 10 Sept 1957