


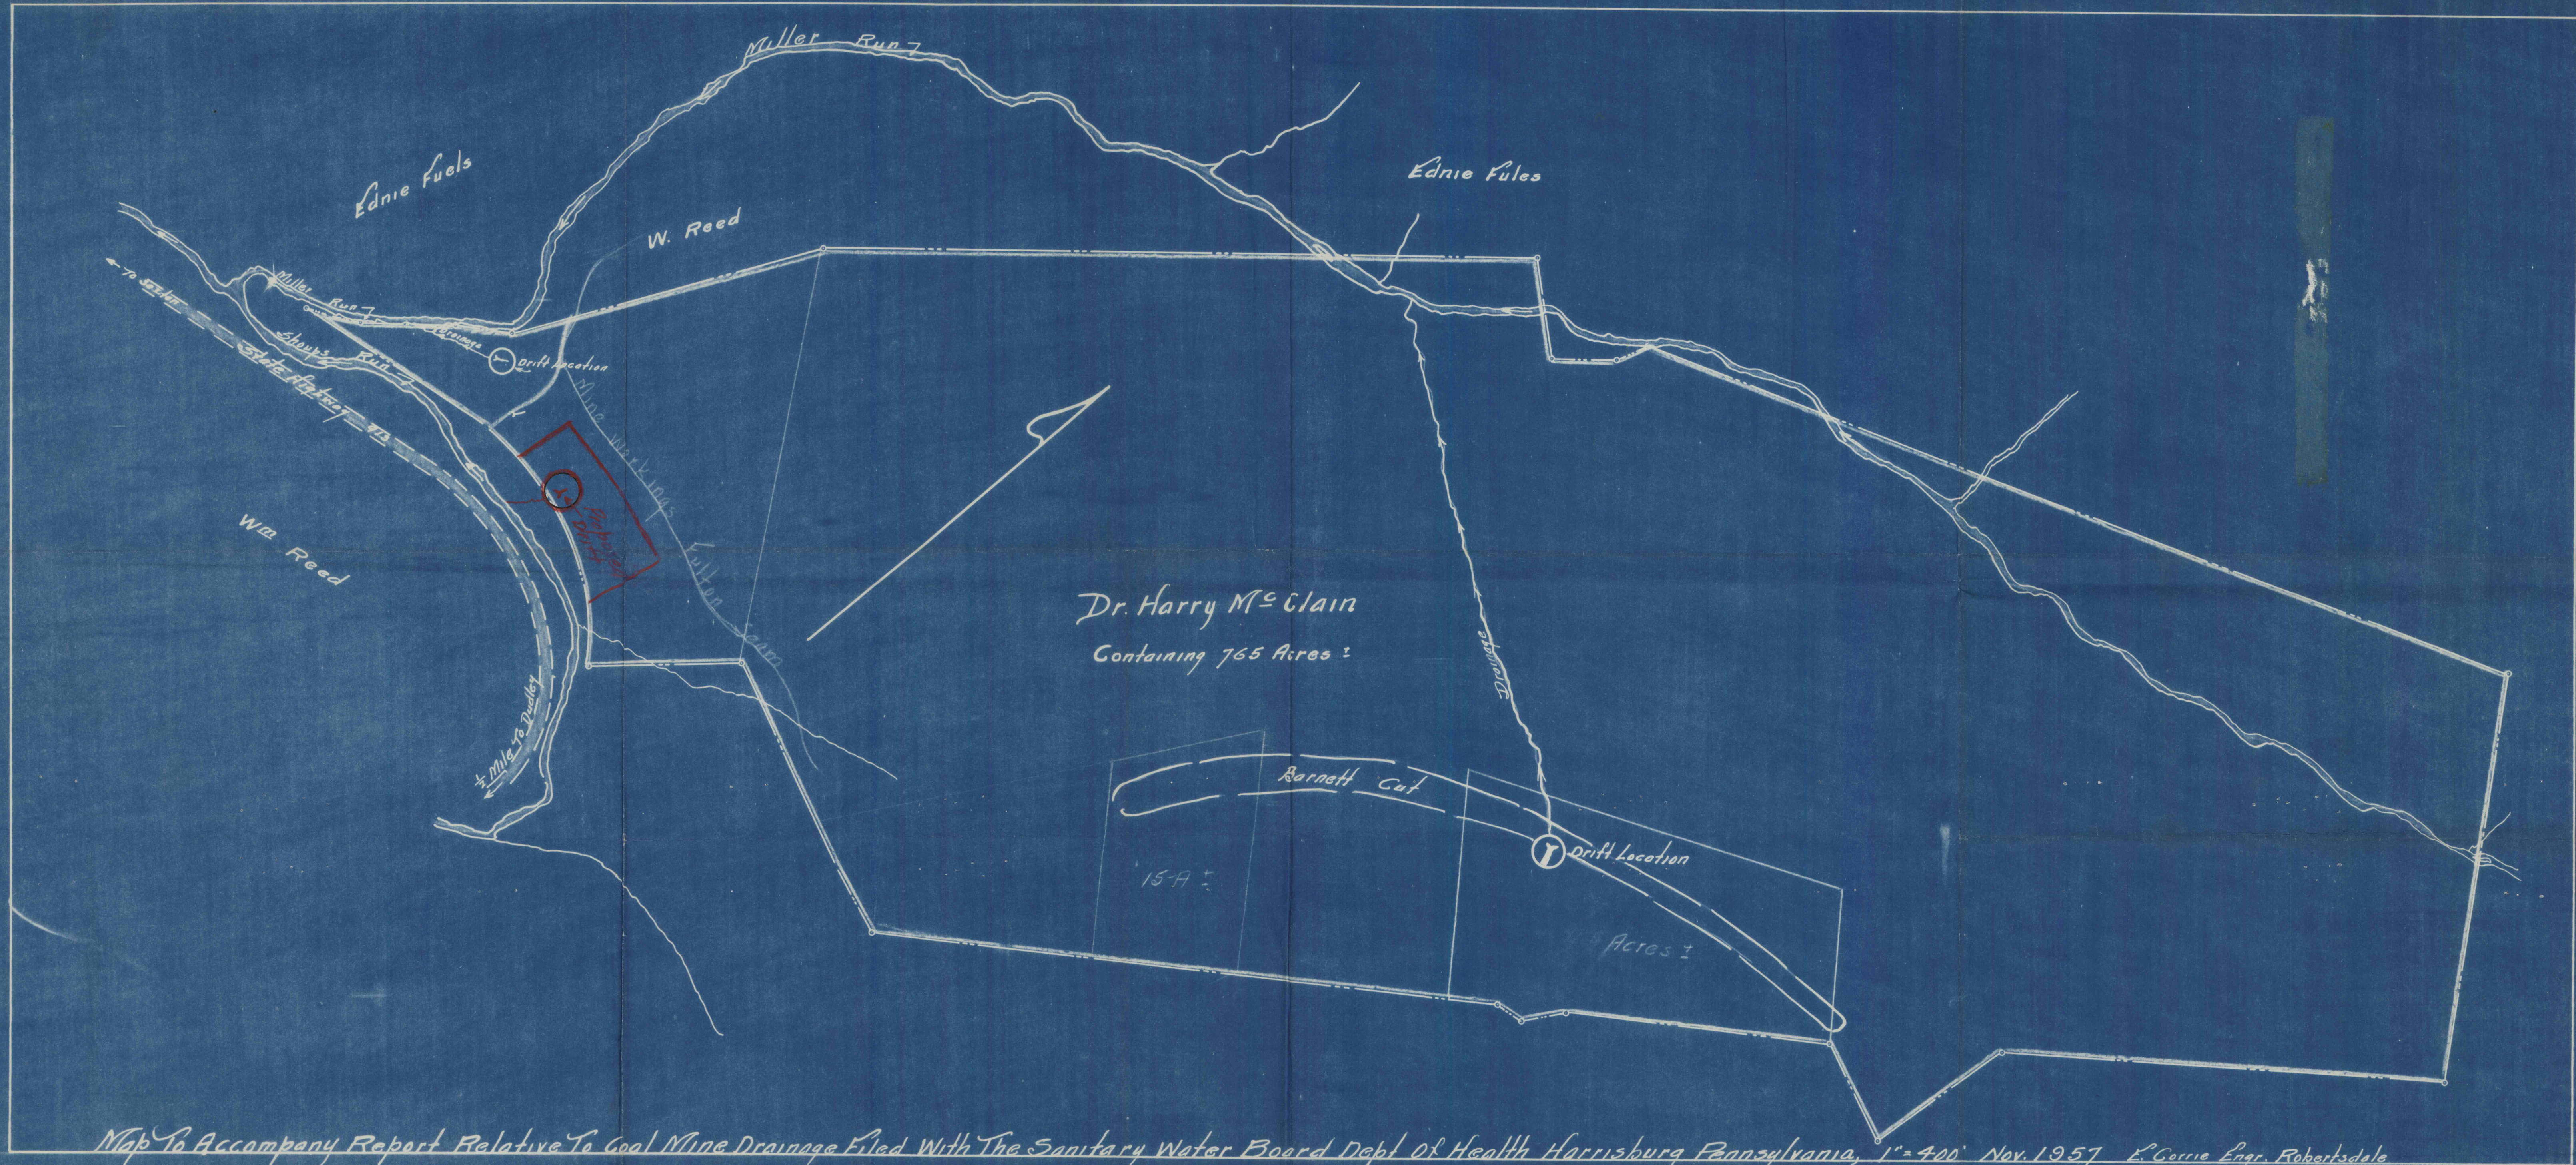

Map To Accompany Report Relative To Coal Mine Drainage Filed With The Sanitary Water Board Dept of Health Harrisburg Pennsylvania, 1"=400' Nov. 1957 E. Corrie Engr. Robertsdale
Situated in Carbon Twp. Huntingdon County Penna.