



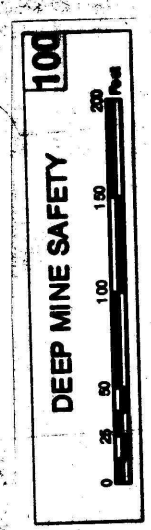

MILTON LAPE

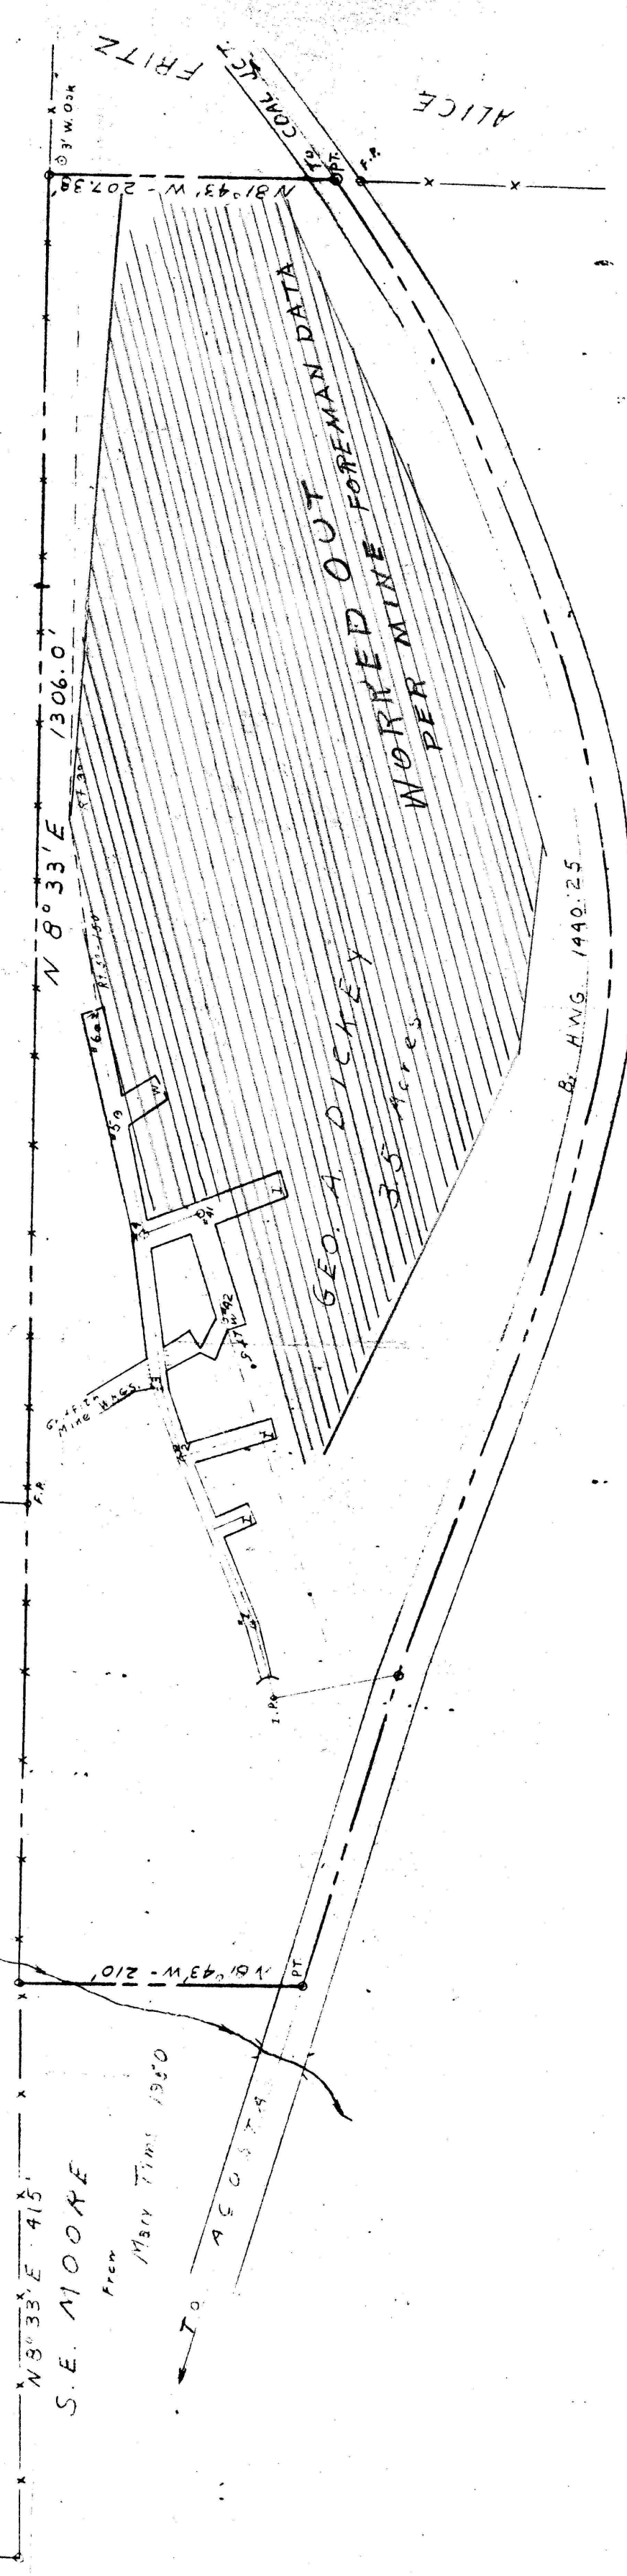

JUNIOR HARTMAN

Neri, George & Archille
Dickey #1
Dickey #2 Oct 1957
Somerset Co., District 20
1956 Annual

THE NEILAN ENGINEERS
PLOT of MINE WORKINGS
ON
GEORGE A. DICKEY TRACT
IN
JENNER TWP., SOMERSET CO., PA.
SURVEYED - C. McL. APRIL 1951
PLOTTED - C. McL. SCALE - 1 in = 100 ft.