


JAMES H. MINDS

M&E
BULAH SHAFT
OPERATED BY THE
BULAH SHAFT COAL CO.




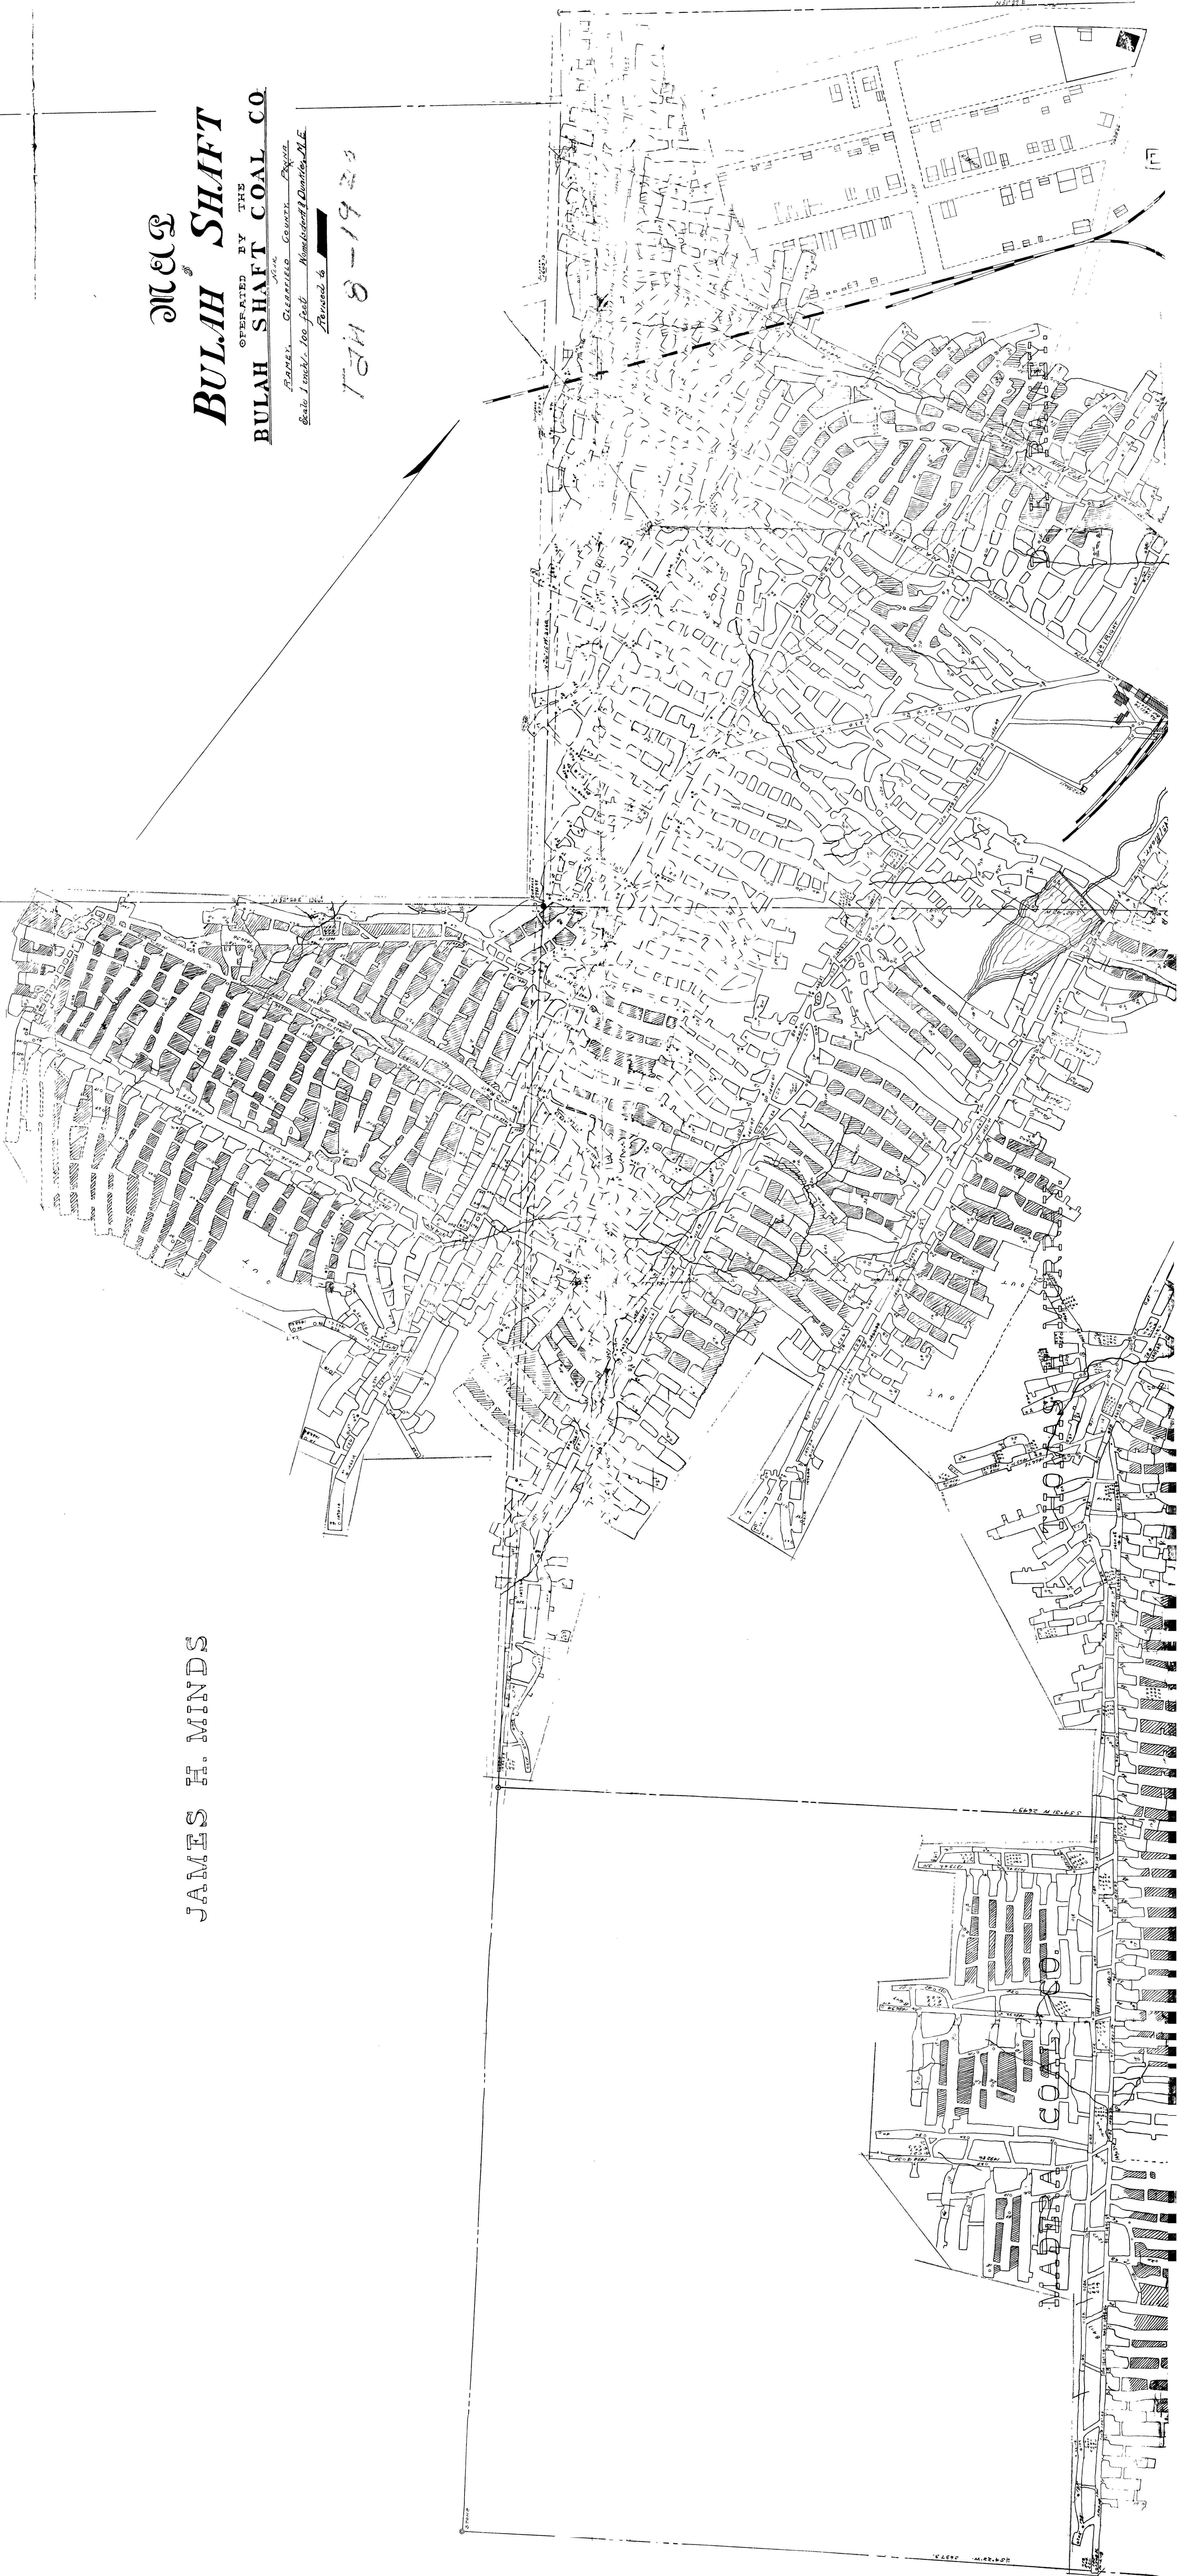

TURNER, No. 1 LEASE

MADEIRA COAL CO.

