



1522-58
S. J. Frazier

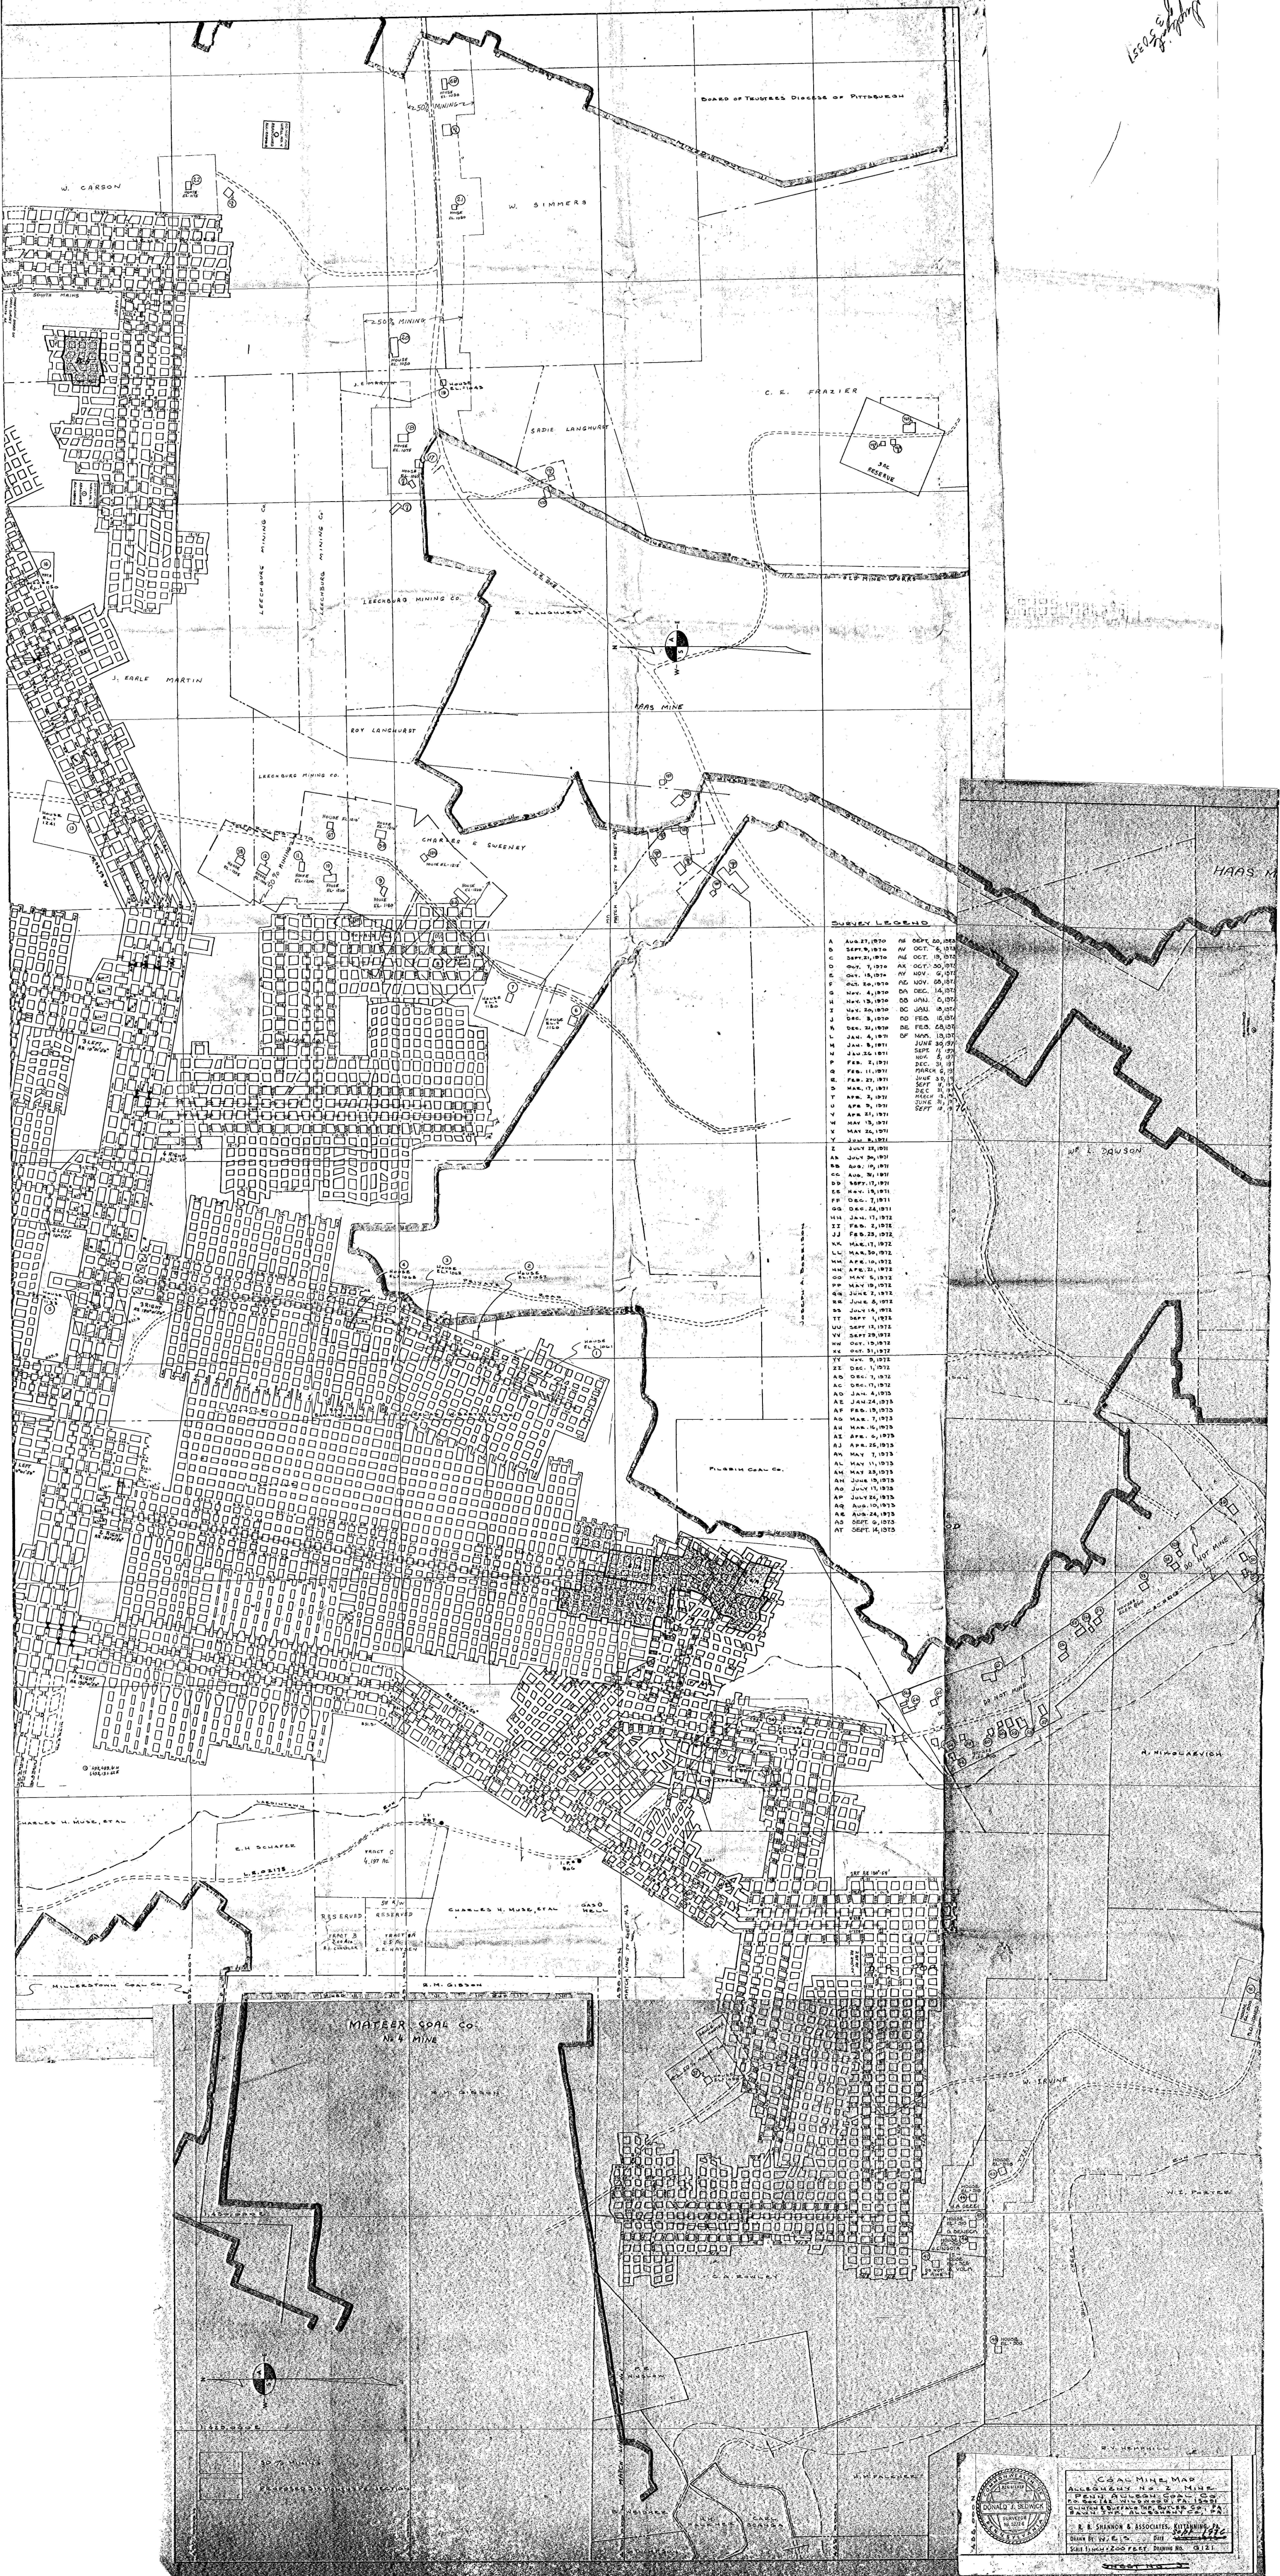

SURVEY LEGEND


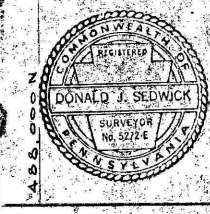

COAL MINE MAP
