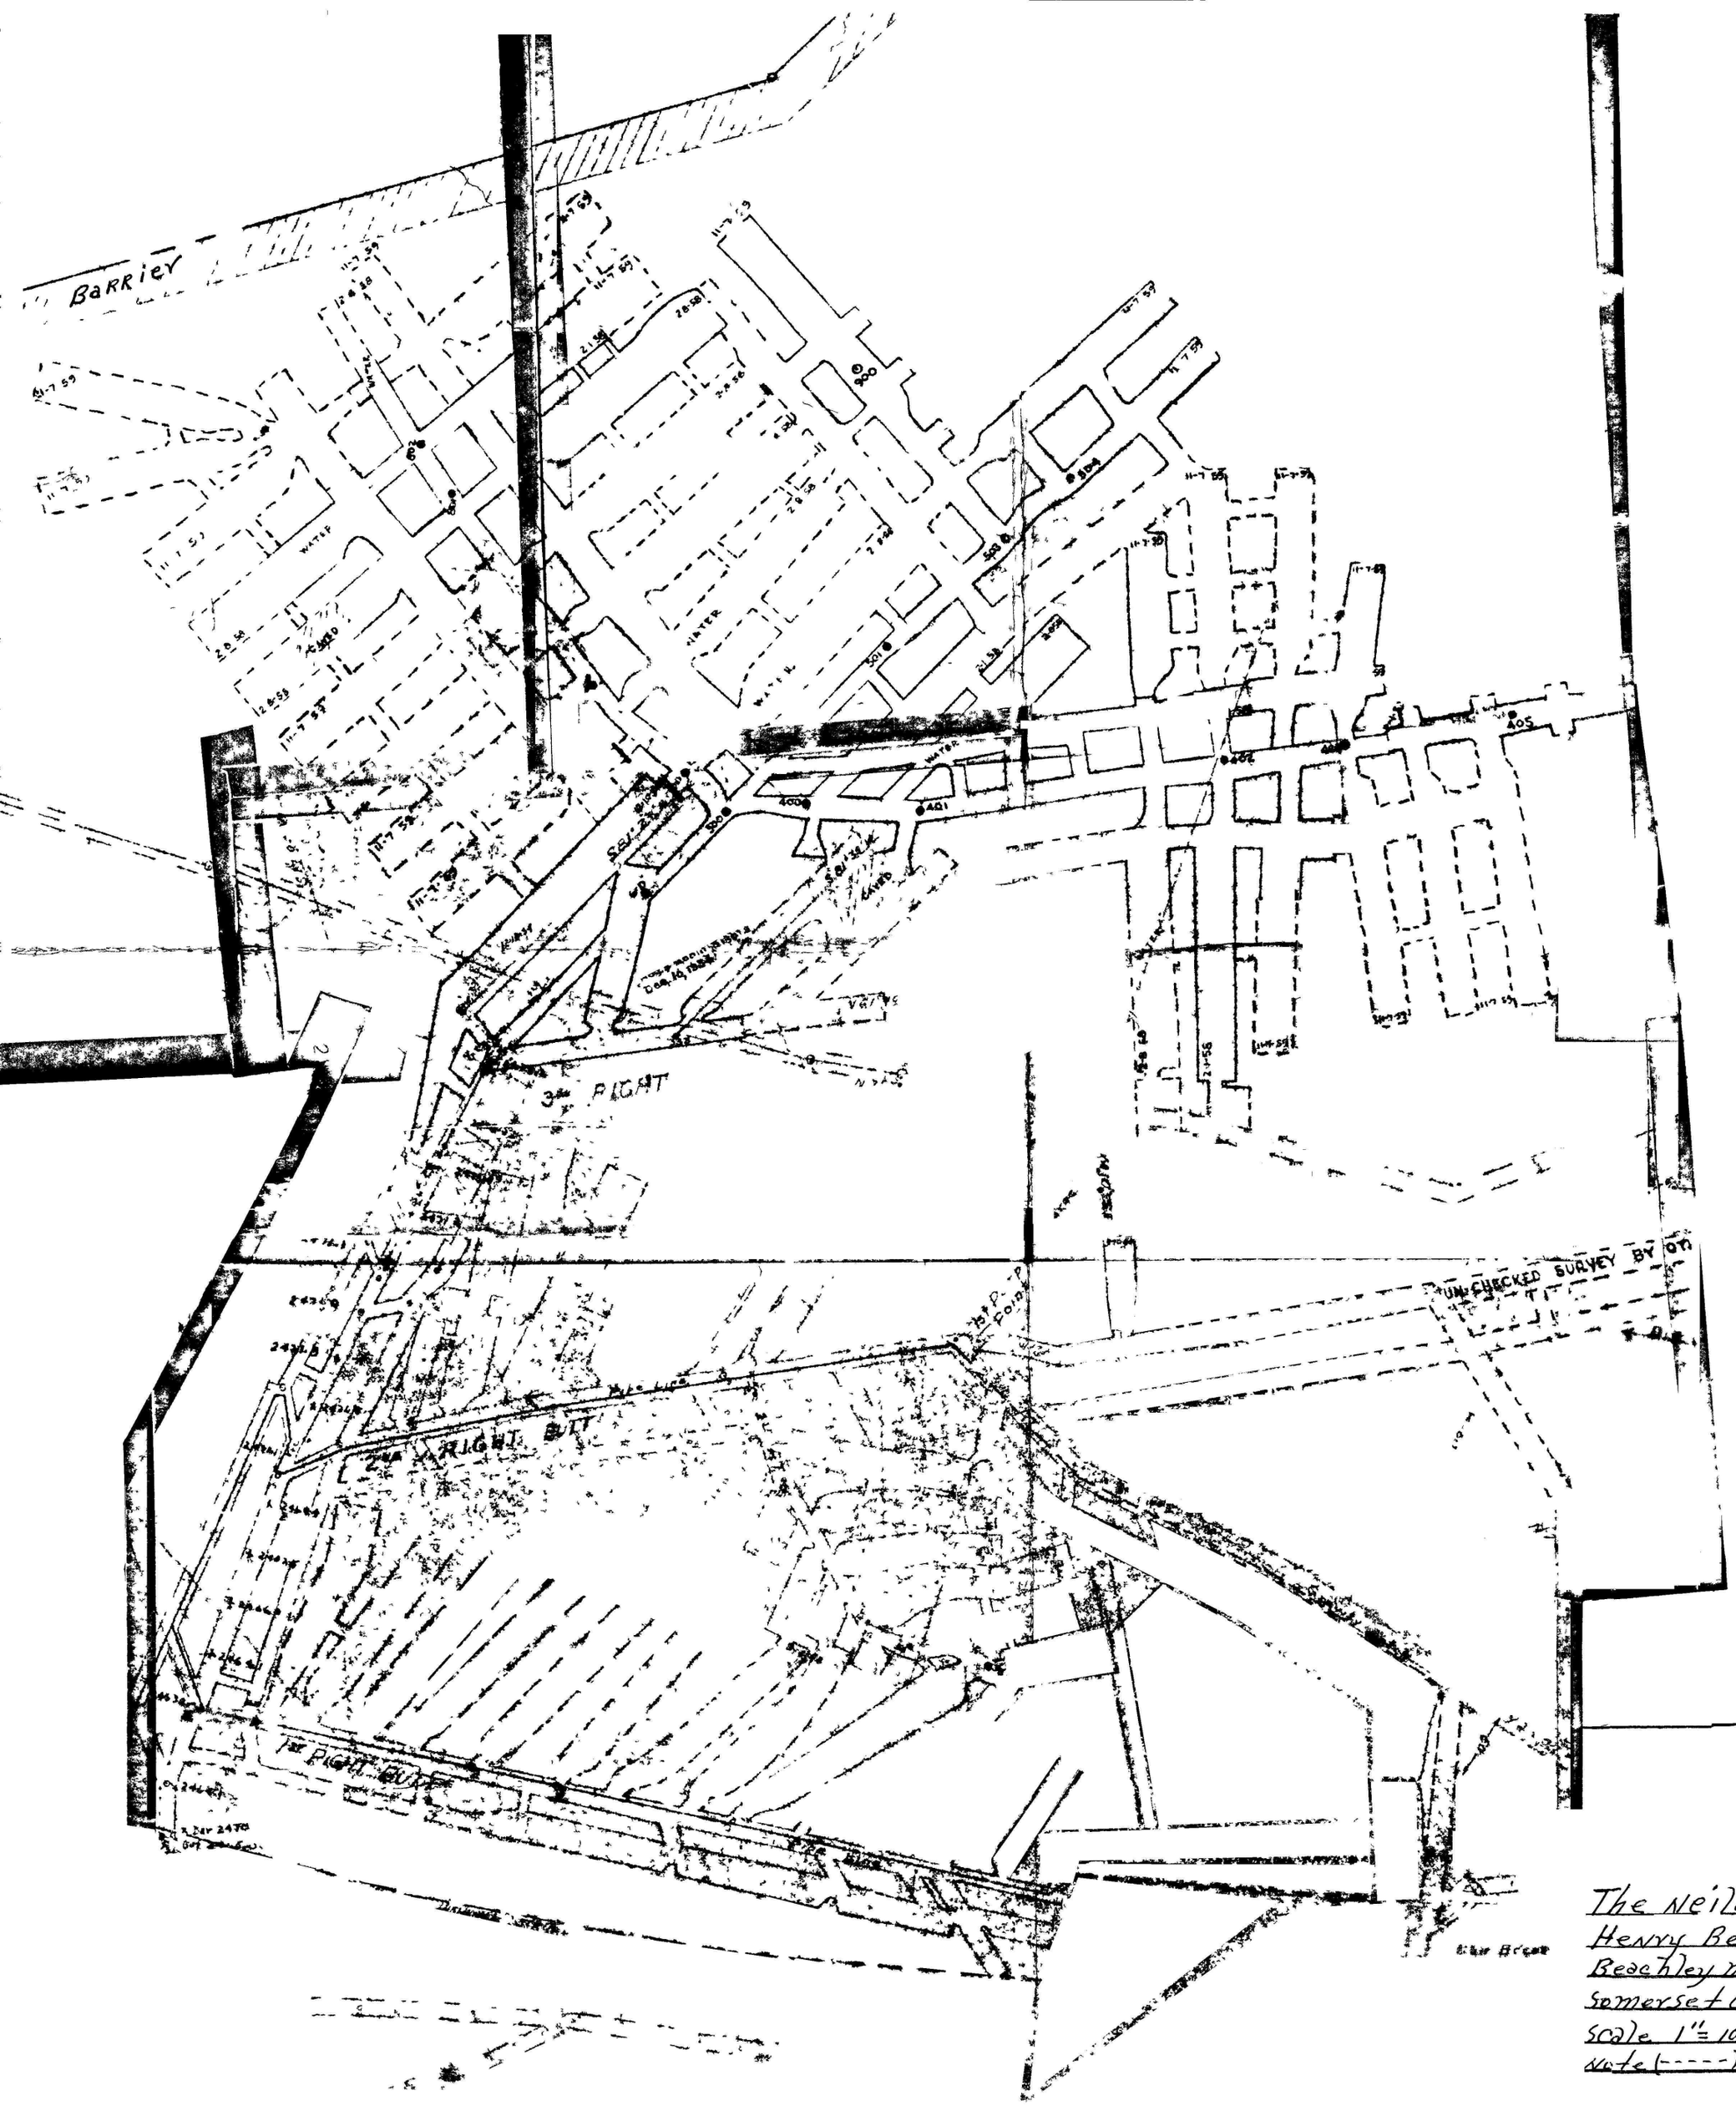

The Neilan Engineers
Henry Beam (Co) Company
Beachley Mine, Somerset Township
Somerset County Pennsylvania
Scale 1" = 100'
Note (- - - -) lines [illegible]