


MATTERN COAL CO.

"E" SEAM - MINE

STONYCREEK TWP, CAMBRIA Co.

PENNSYLVANIA

SCALE 1"=100'

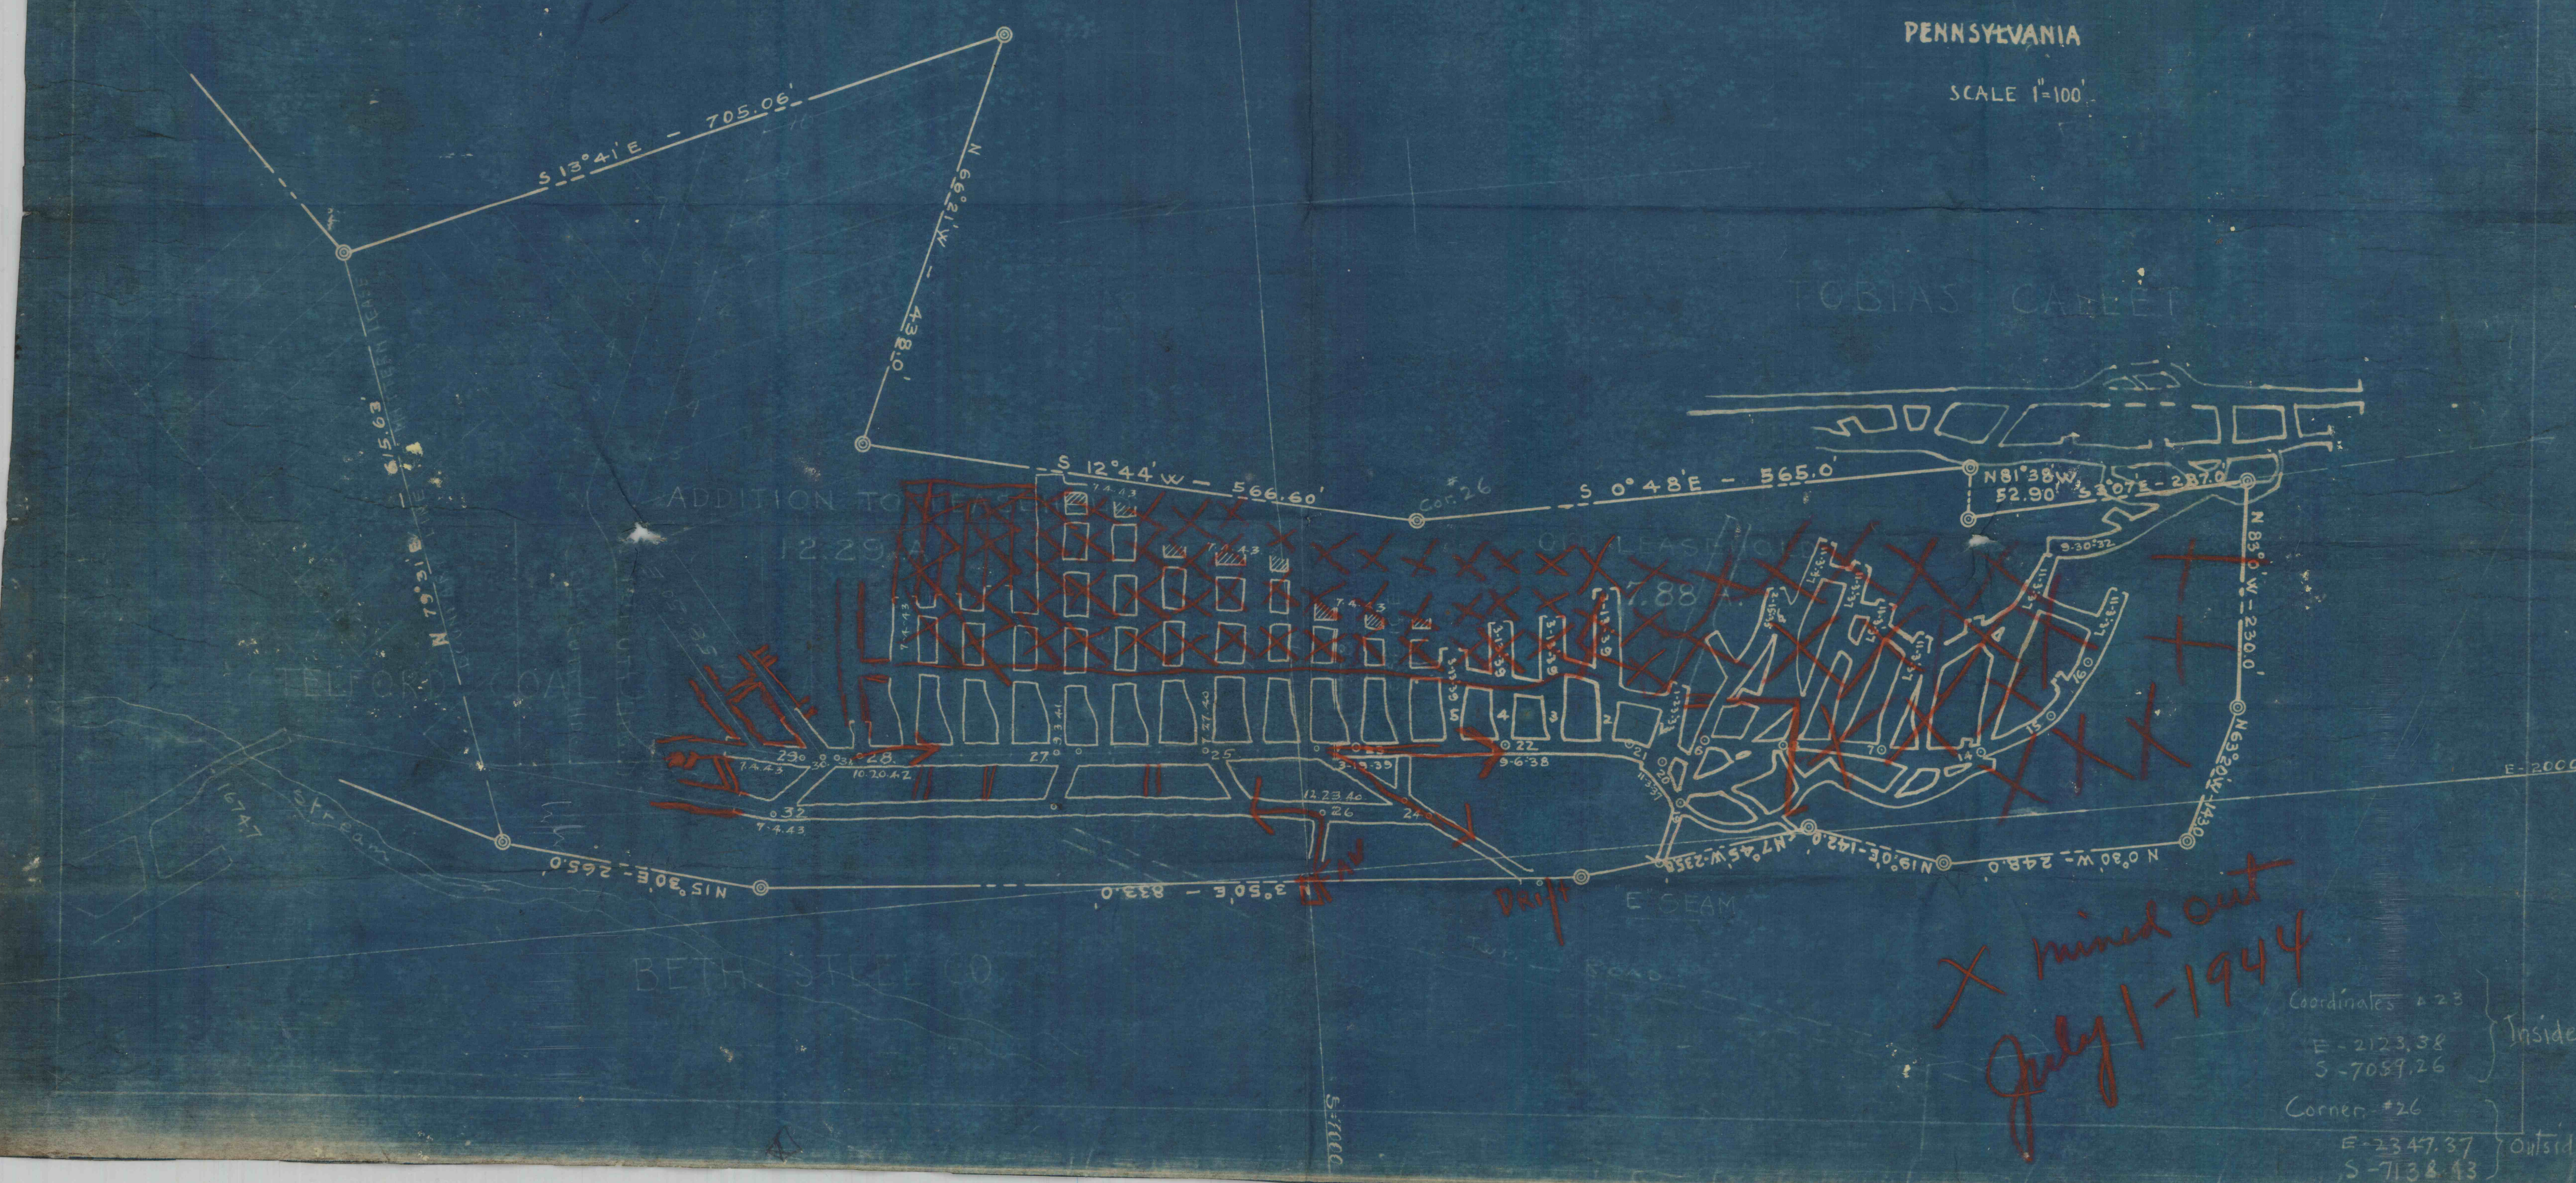

X mined out
July 1-1944

Coordinates #23
E - 2123.38
S - 7089.26
Corner #26
E - 2347.87
S - 7136.43

Inside
Outside