


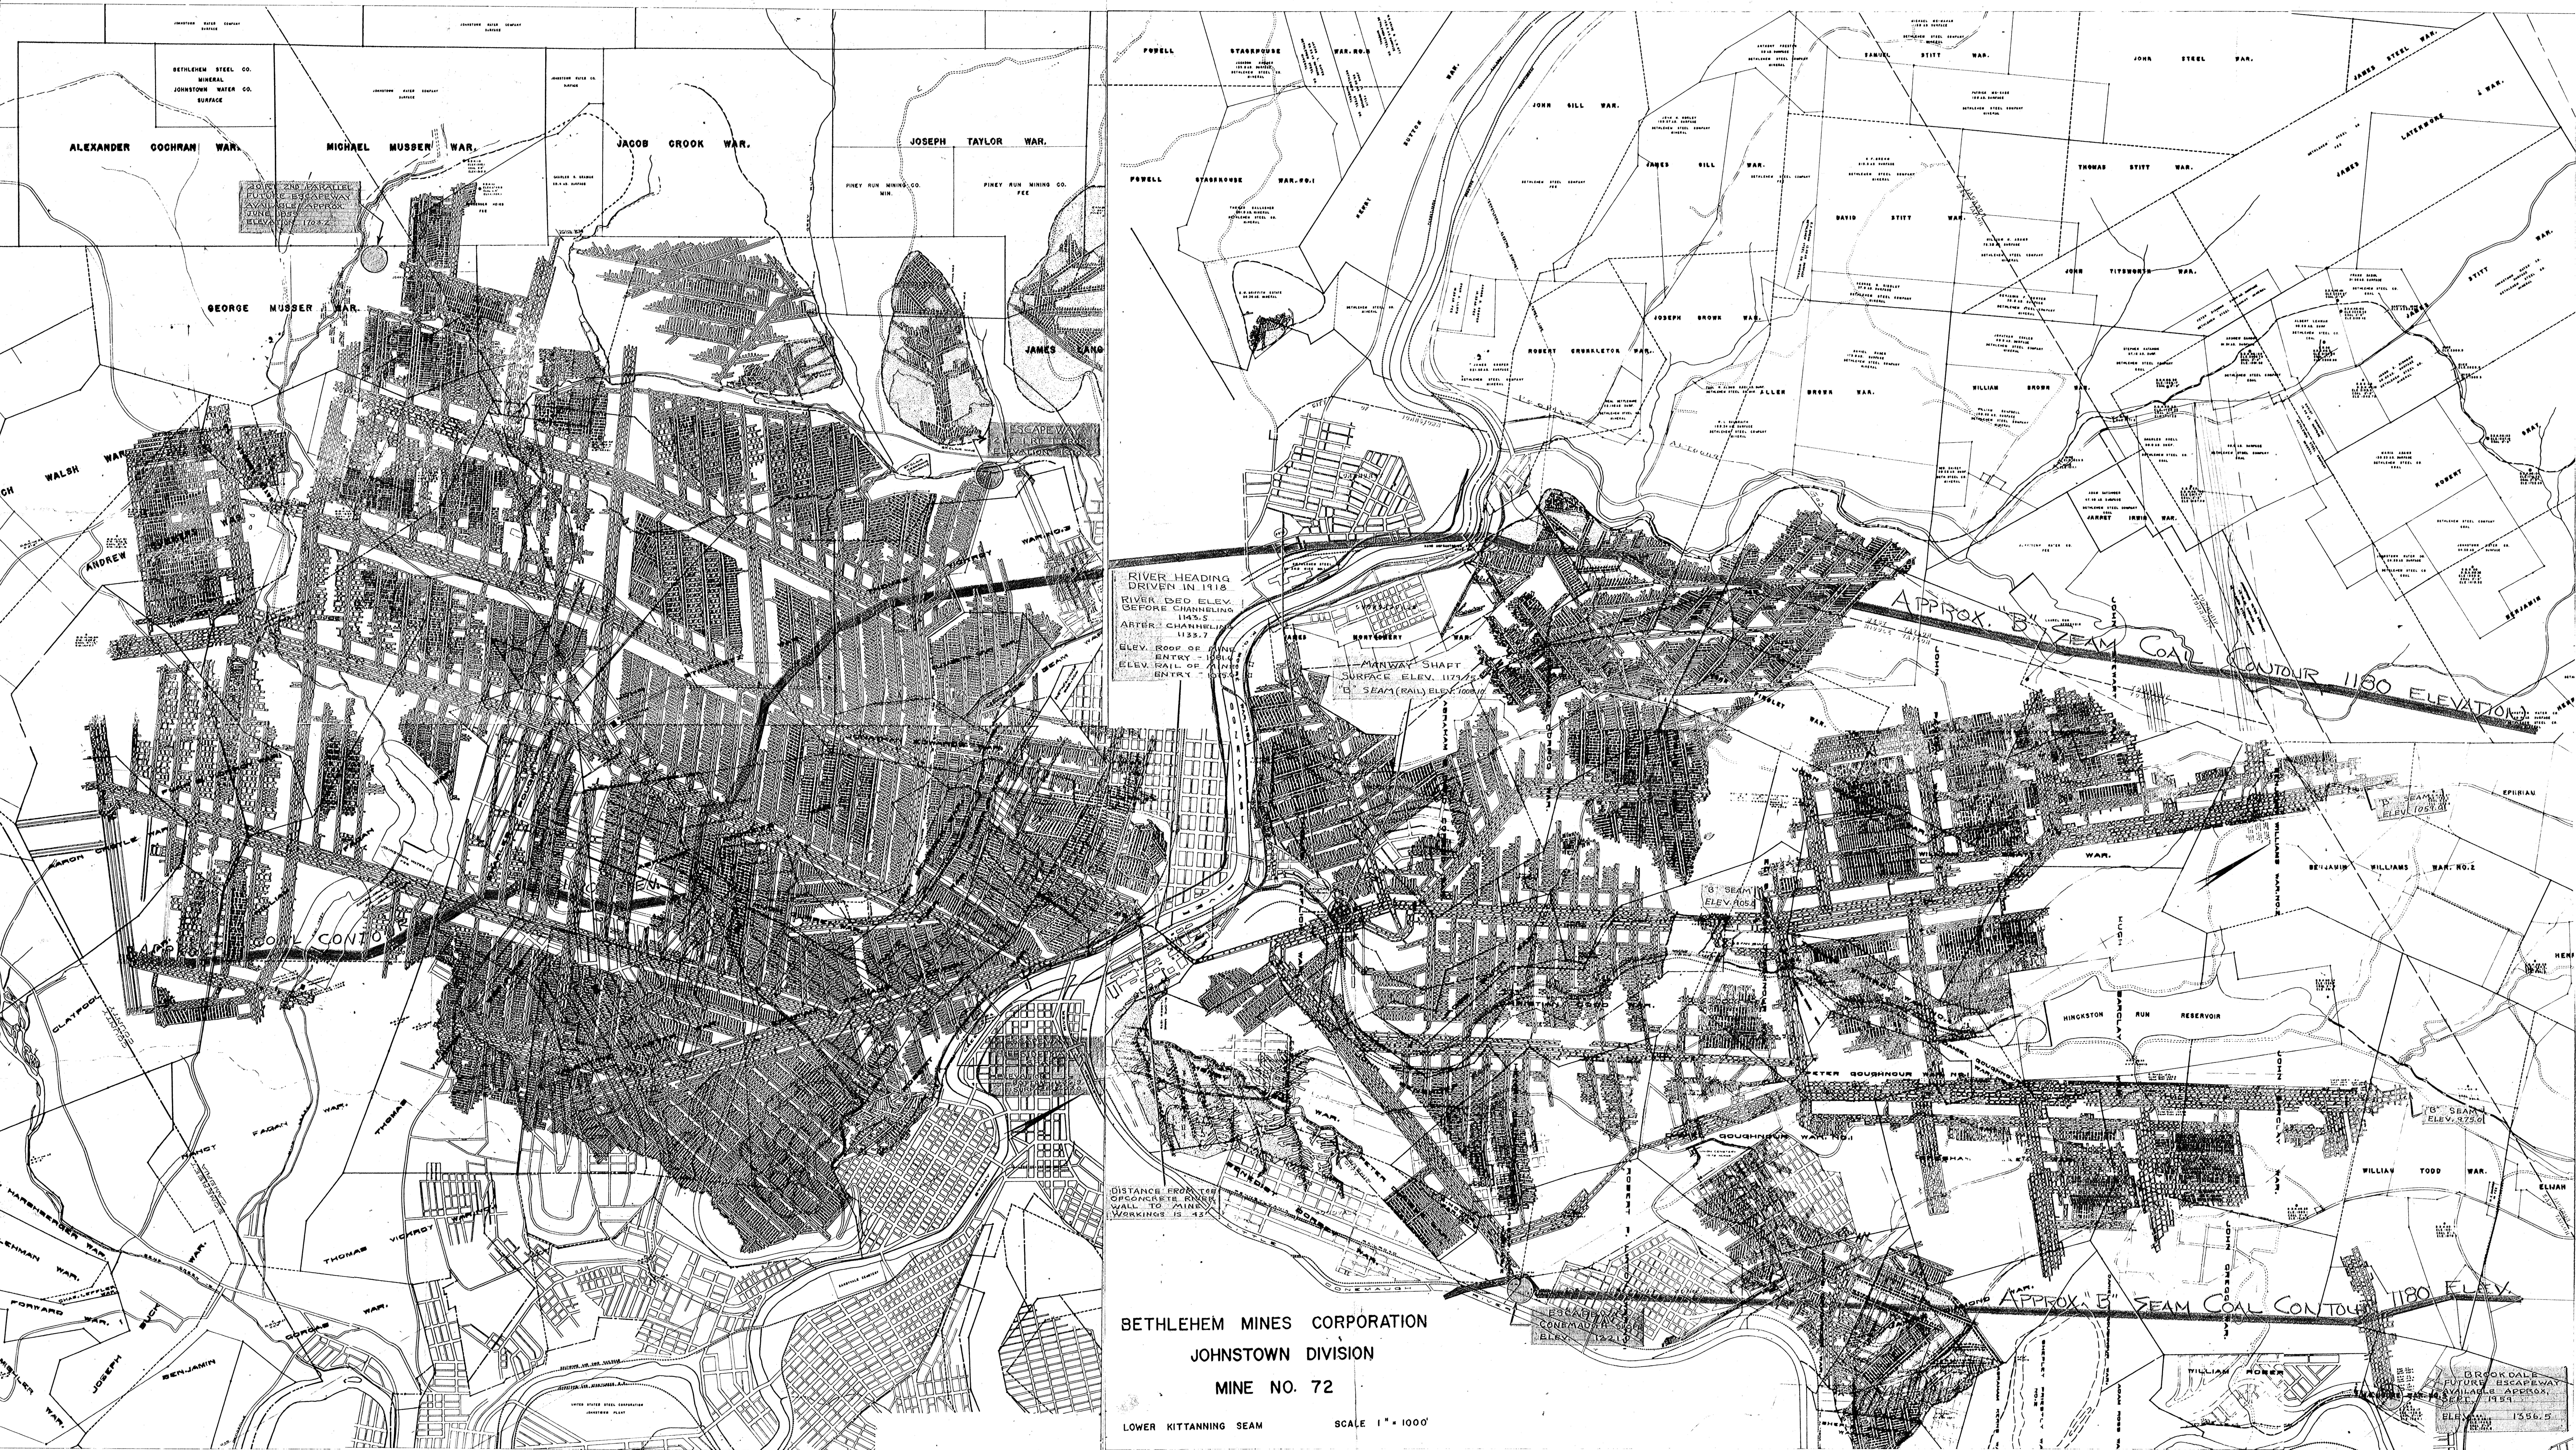

BETHLEHEM MINES CORPORATION
JOHNSTOWN DIVISION
MINE NO. 72

LOWER KITTANNING SEAM SCALE 1" = 1000'