
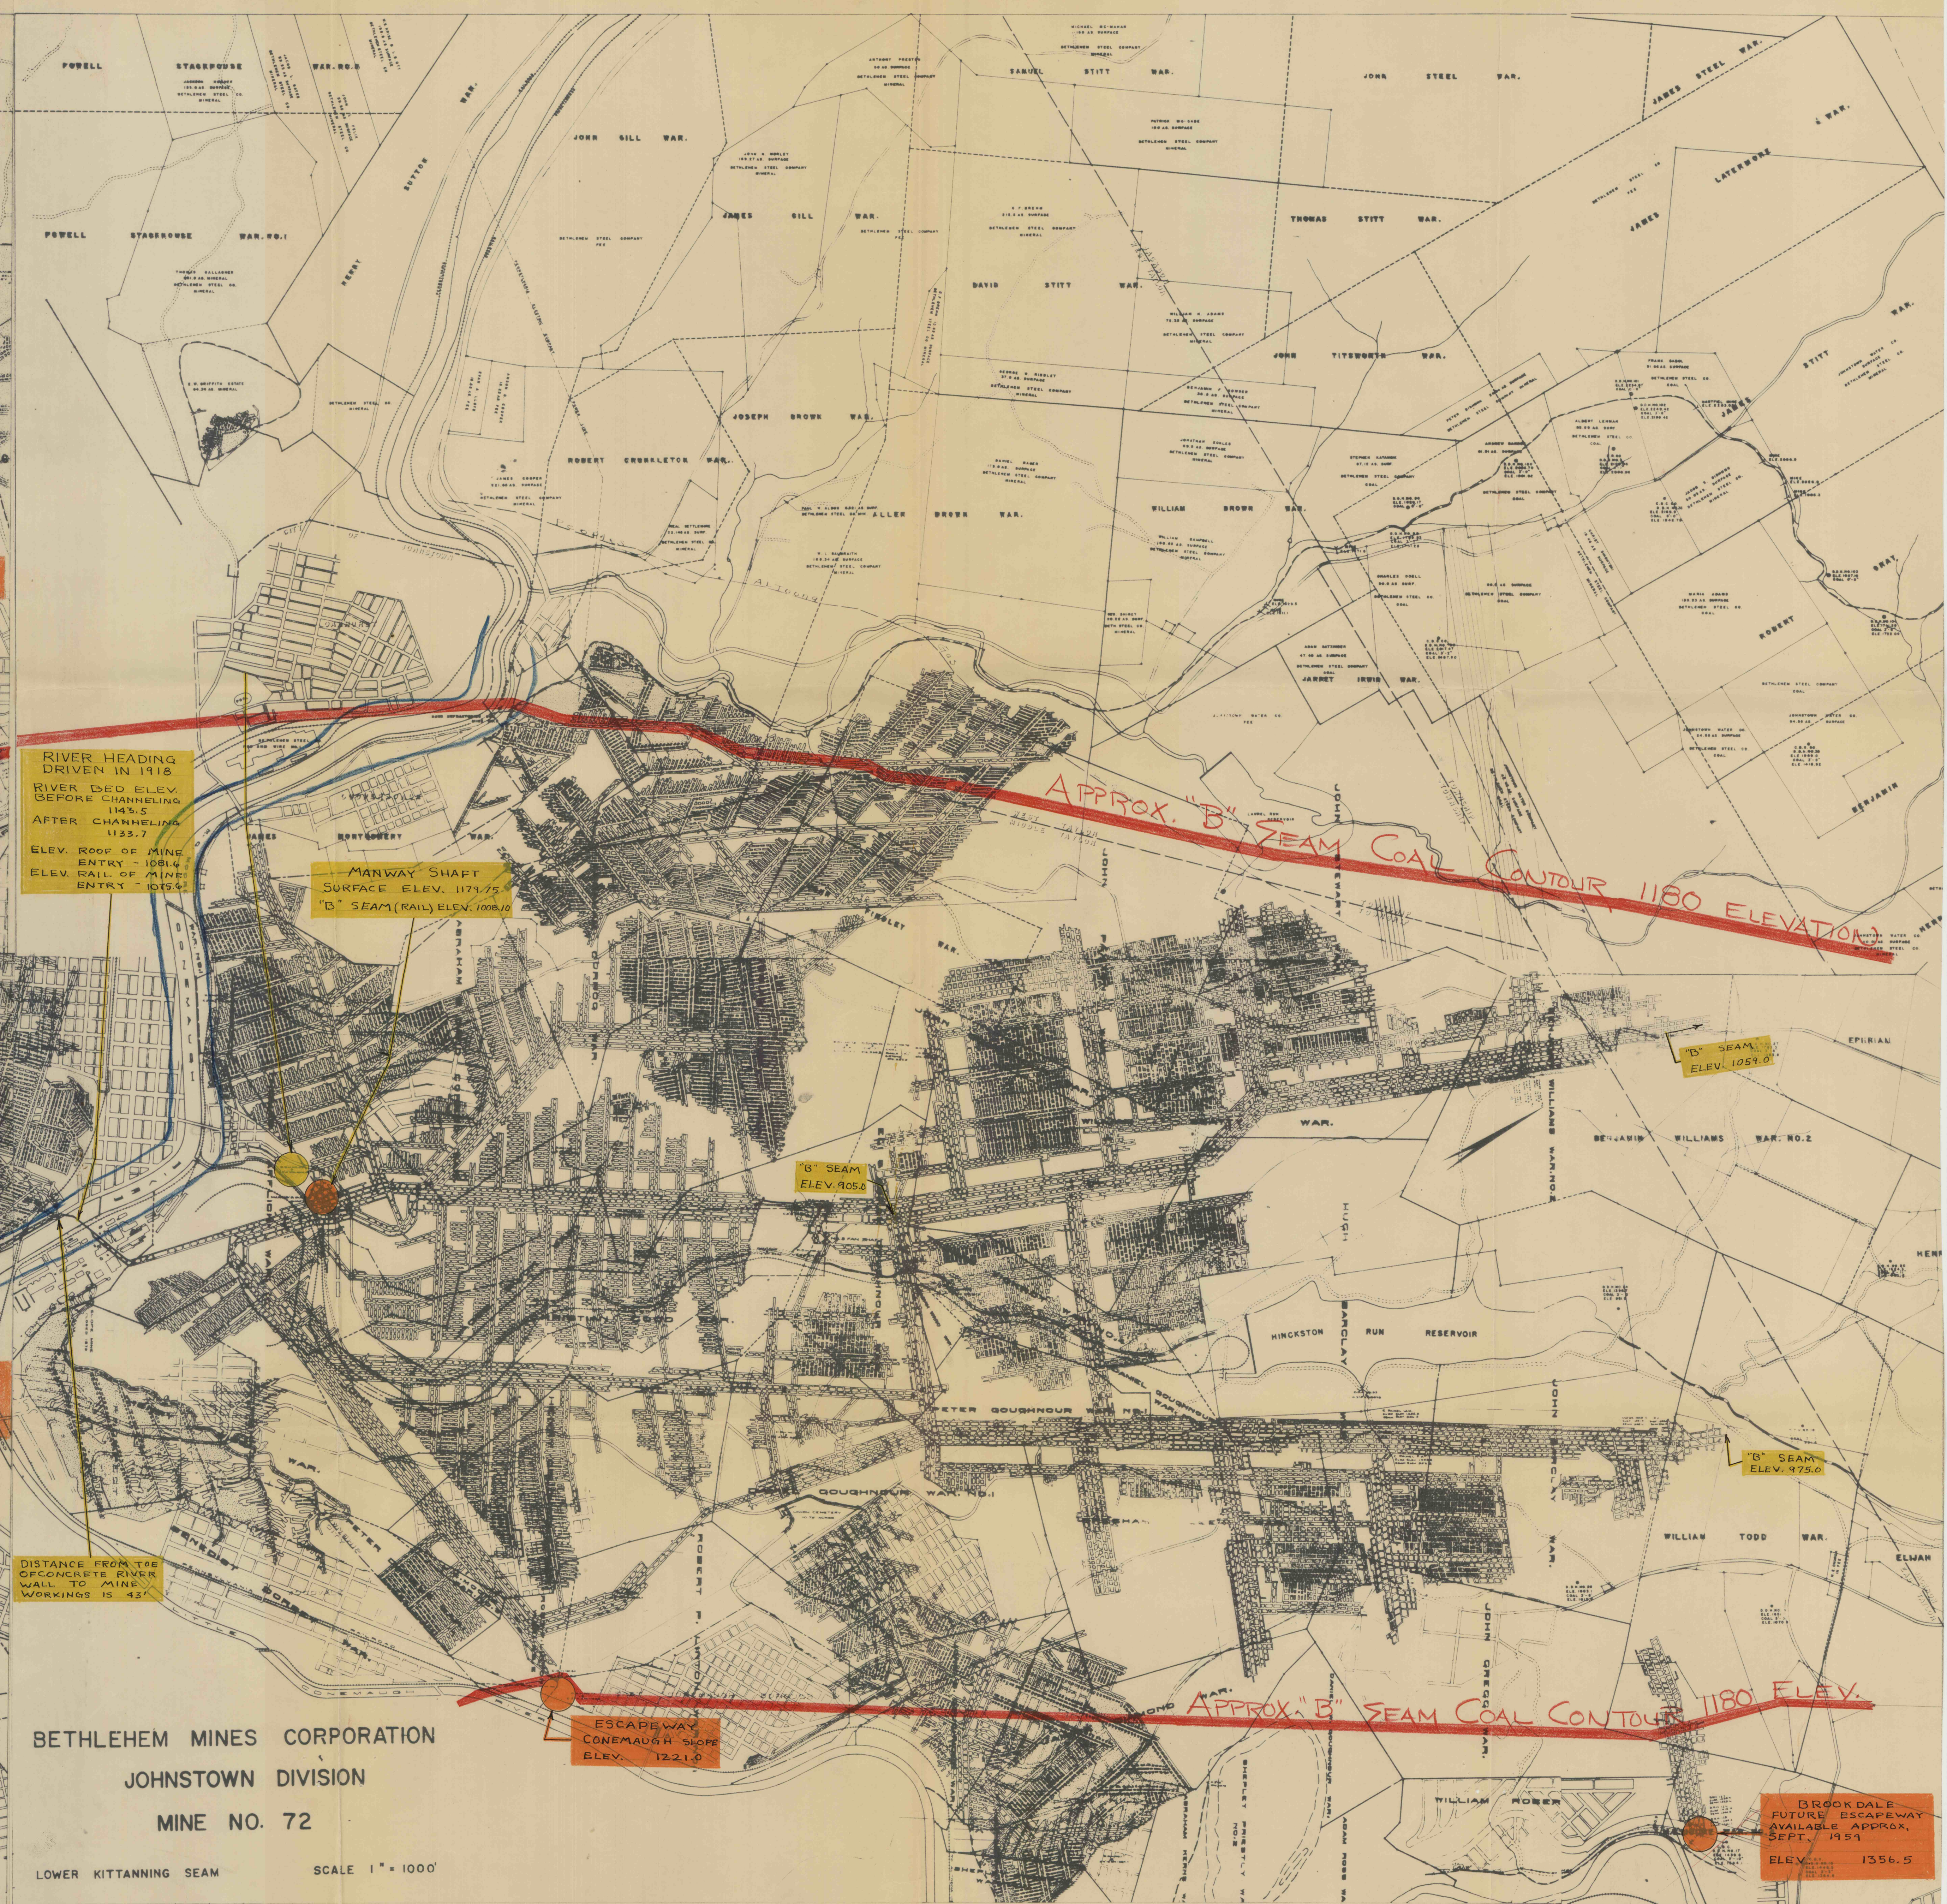


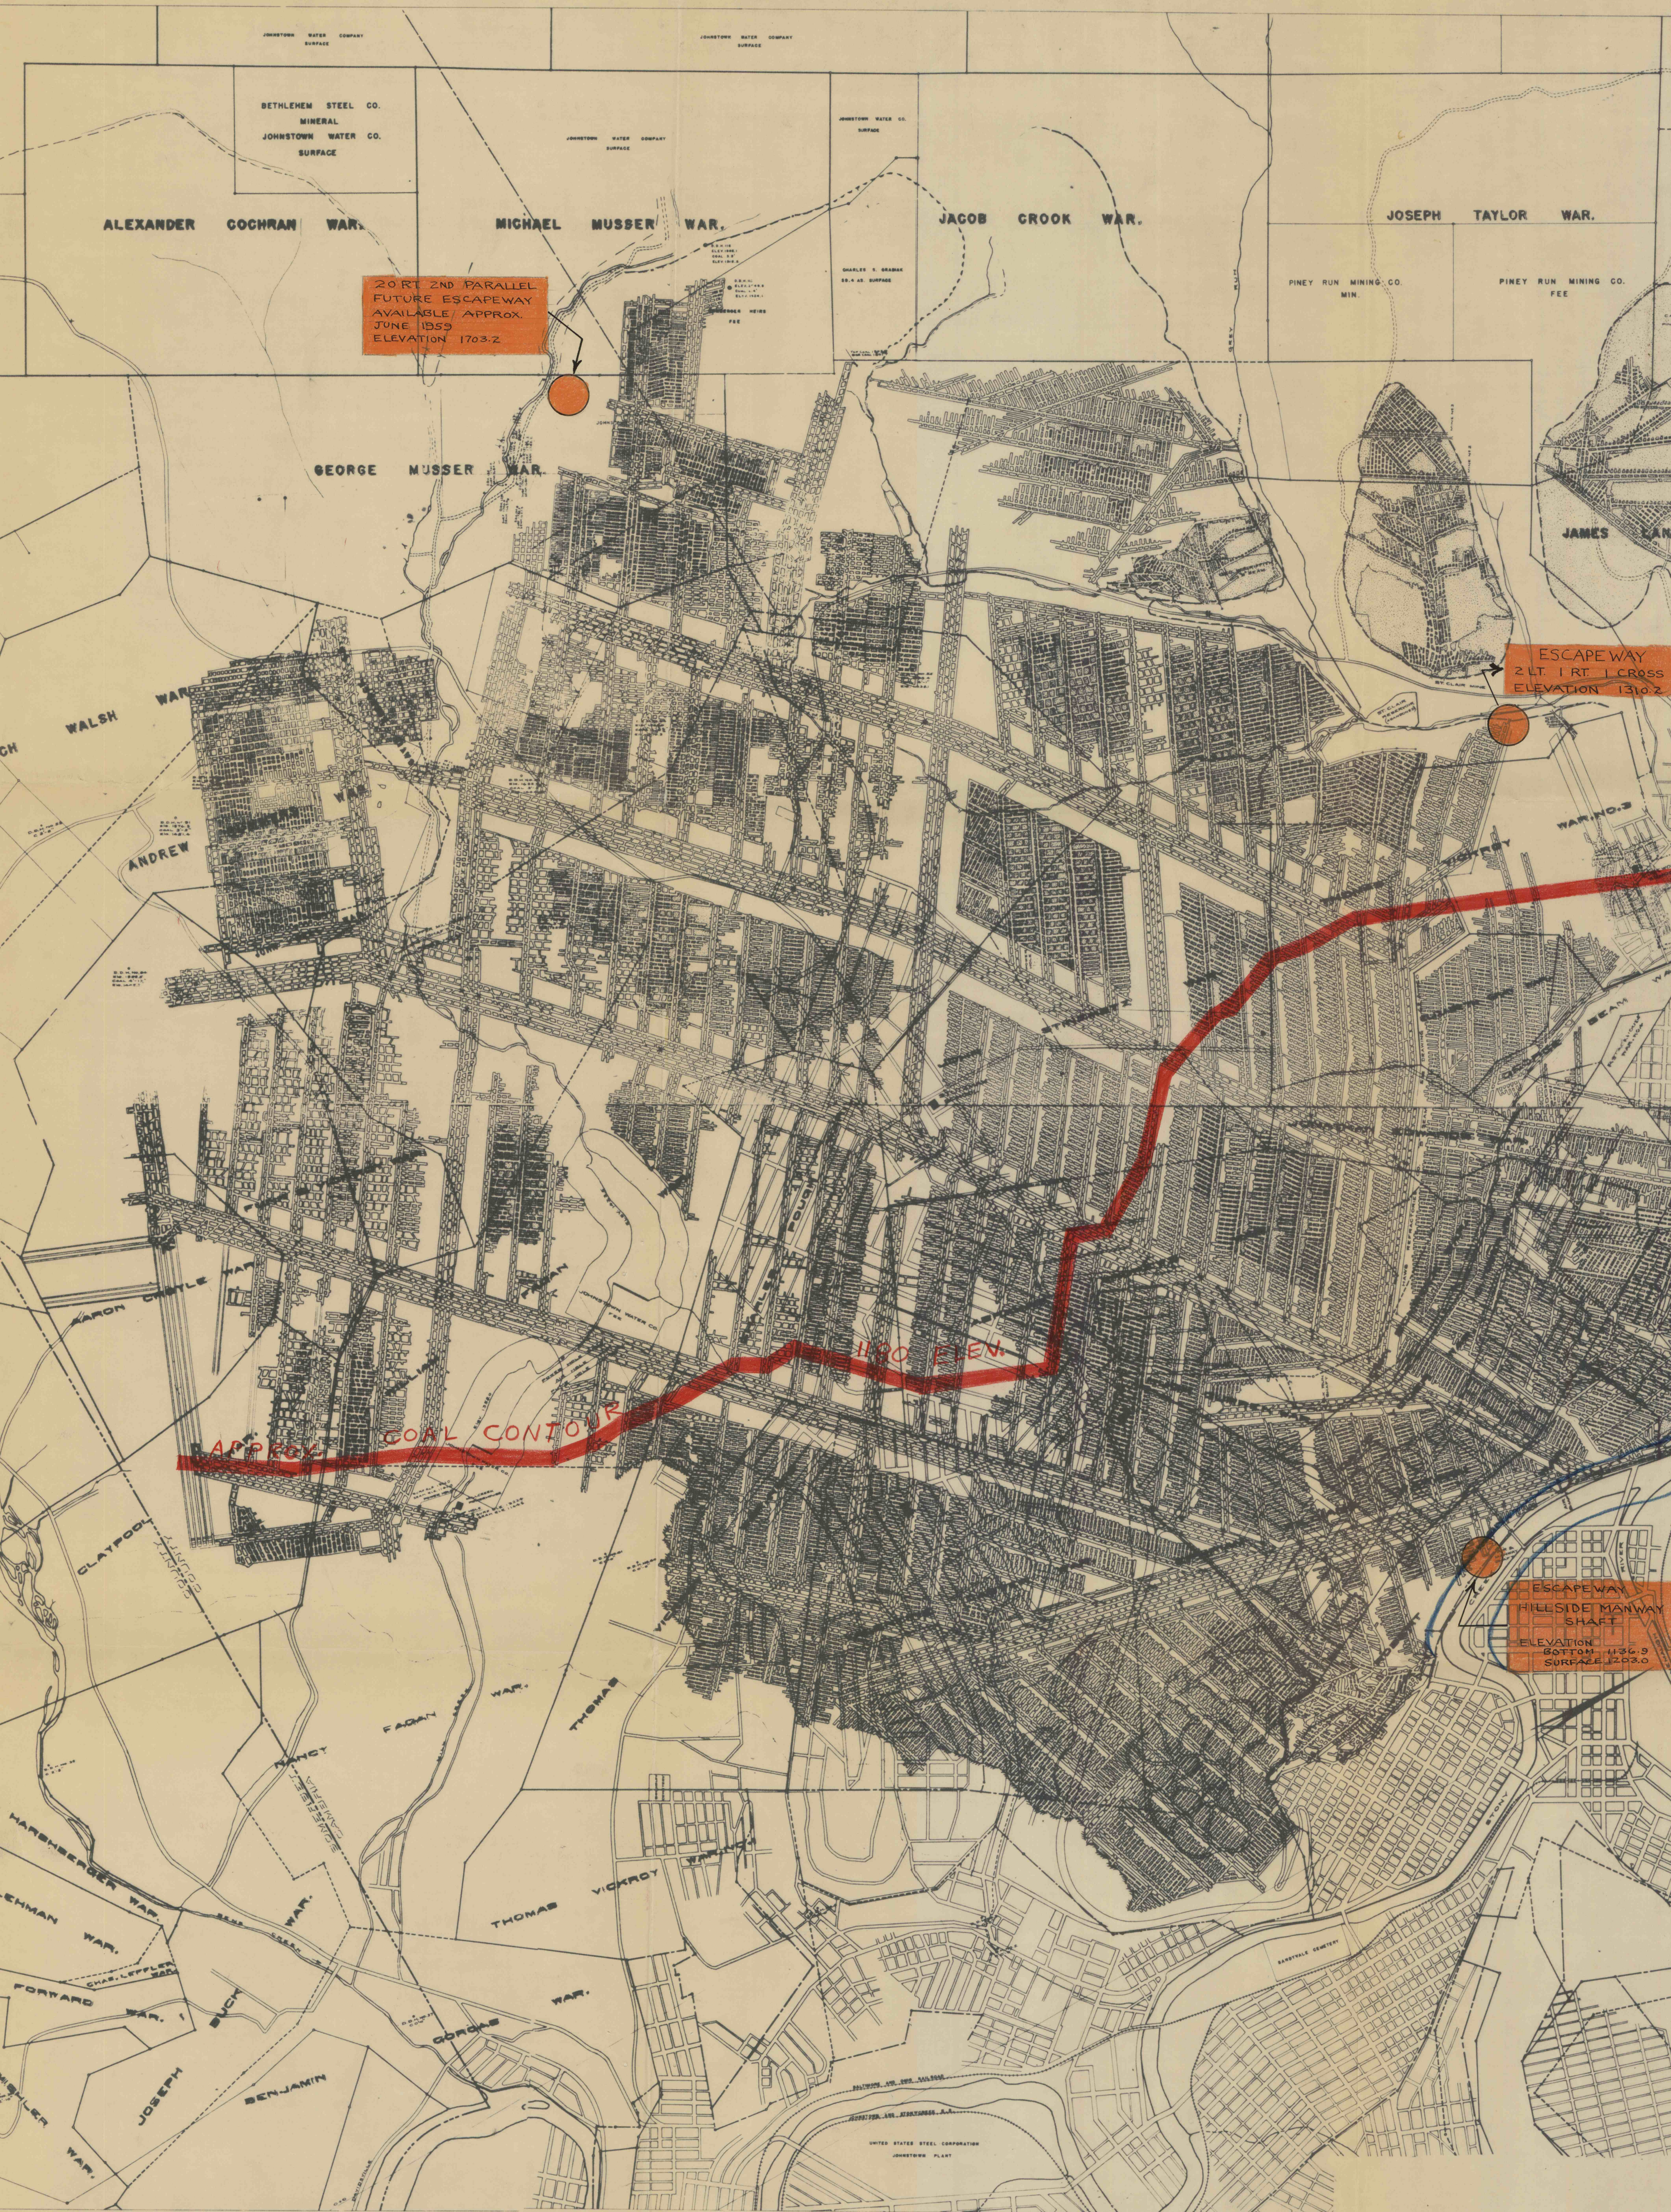

BETHLEHEM MINES CORPORATION
JOHNSTOWN DIVISION
MINE NO. 72
LOWER KITTANNING SEAM
SCALE 1" = 1000'