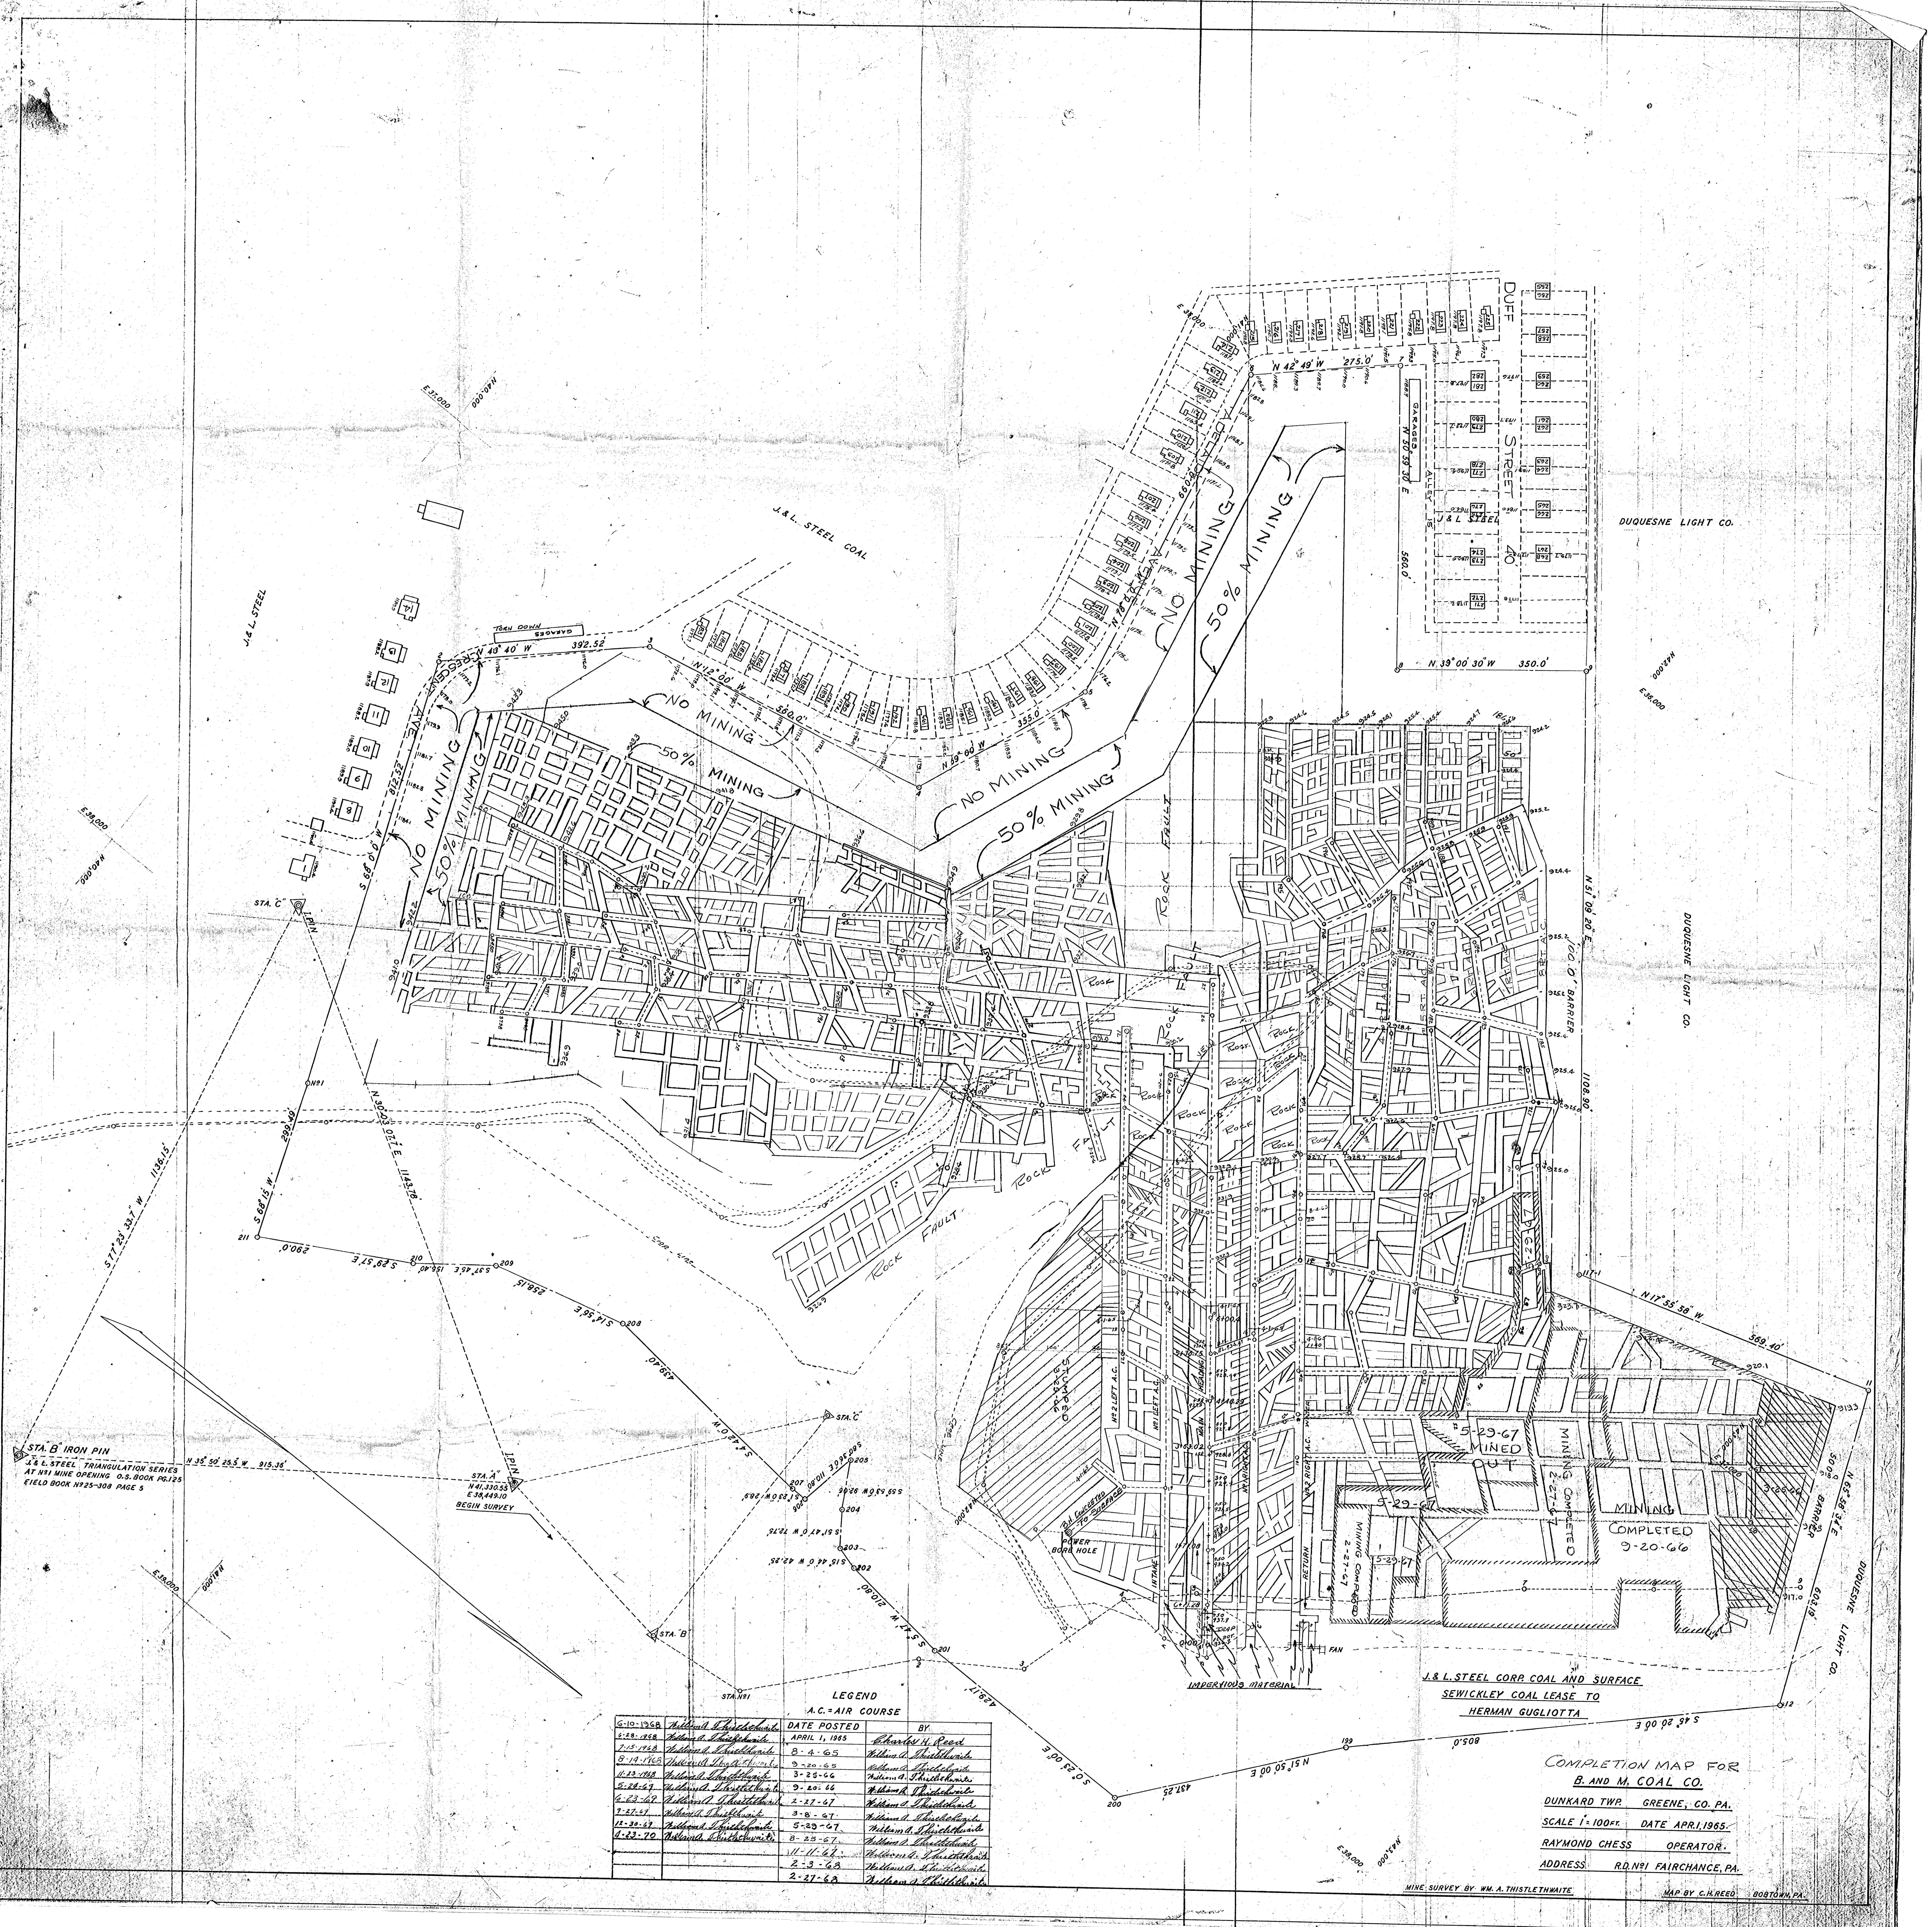

LEGEND

A.C. = AIR COURSE

6-10-1968	William A. Thistlethwaite	DATE POSTED	BY
6-28-1968	William A. Thistlethwaite	APRIL 1, 1965	Charles H. Reed
7-15-1968	William A. Thistlethwaite	8-4-65	William A. Thistlethwaite
8-14-1968	William A. Thistlethwaite	9-20-65	William A. Thistlethwaite
11-23-1968	William A. Thistlethwaite	3-25-66	William A. Thistlethwaite
5-24-69	William A. Thistlethwaite	9-20-66	William A. Thistlethwaite
6-23-69	William A. Thistlethwaite	2-27-67	William A. Thistlethwaite
9-27-69	William A. Thistlethwaite	3-8-67	William A. Thistlethwaite
12-30-69	William A. Thistlethwaite	5-29-67	William A. Thistlethwaite
4-23-70	William A. Thistlethwaite	8-25-67	William A. Thistlethwaite
		11-11-67	William A. Thistlethwaite
		2-3-68	William A. Thistlethwaite
		2-27-68	William A. Thistlethwaite

J.& L. STEEL CORP. COAL AND SURFACE
SEWICKLEY COAL LEASE TO
HERMAN GUGLIOTTA

COMPLETION MAP FOR
B. AND M. COAL CO.

DUNKARD TWP. GREENE, CO. PA.
SCALE 1" = 100 FT. DATE APR. 1, 1965.
RAYMOND CHESS OPERATOR.
ADDRESS R.D. Nº1 FAIRCHANCE, PA.

MINE SURVEY BY WM. A. THISTLETHWAITE

MAP BY C.H. REED BOBTOWN, PA.