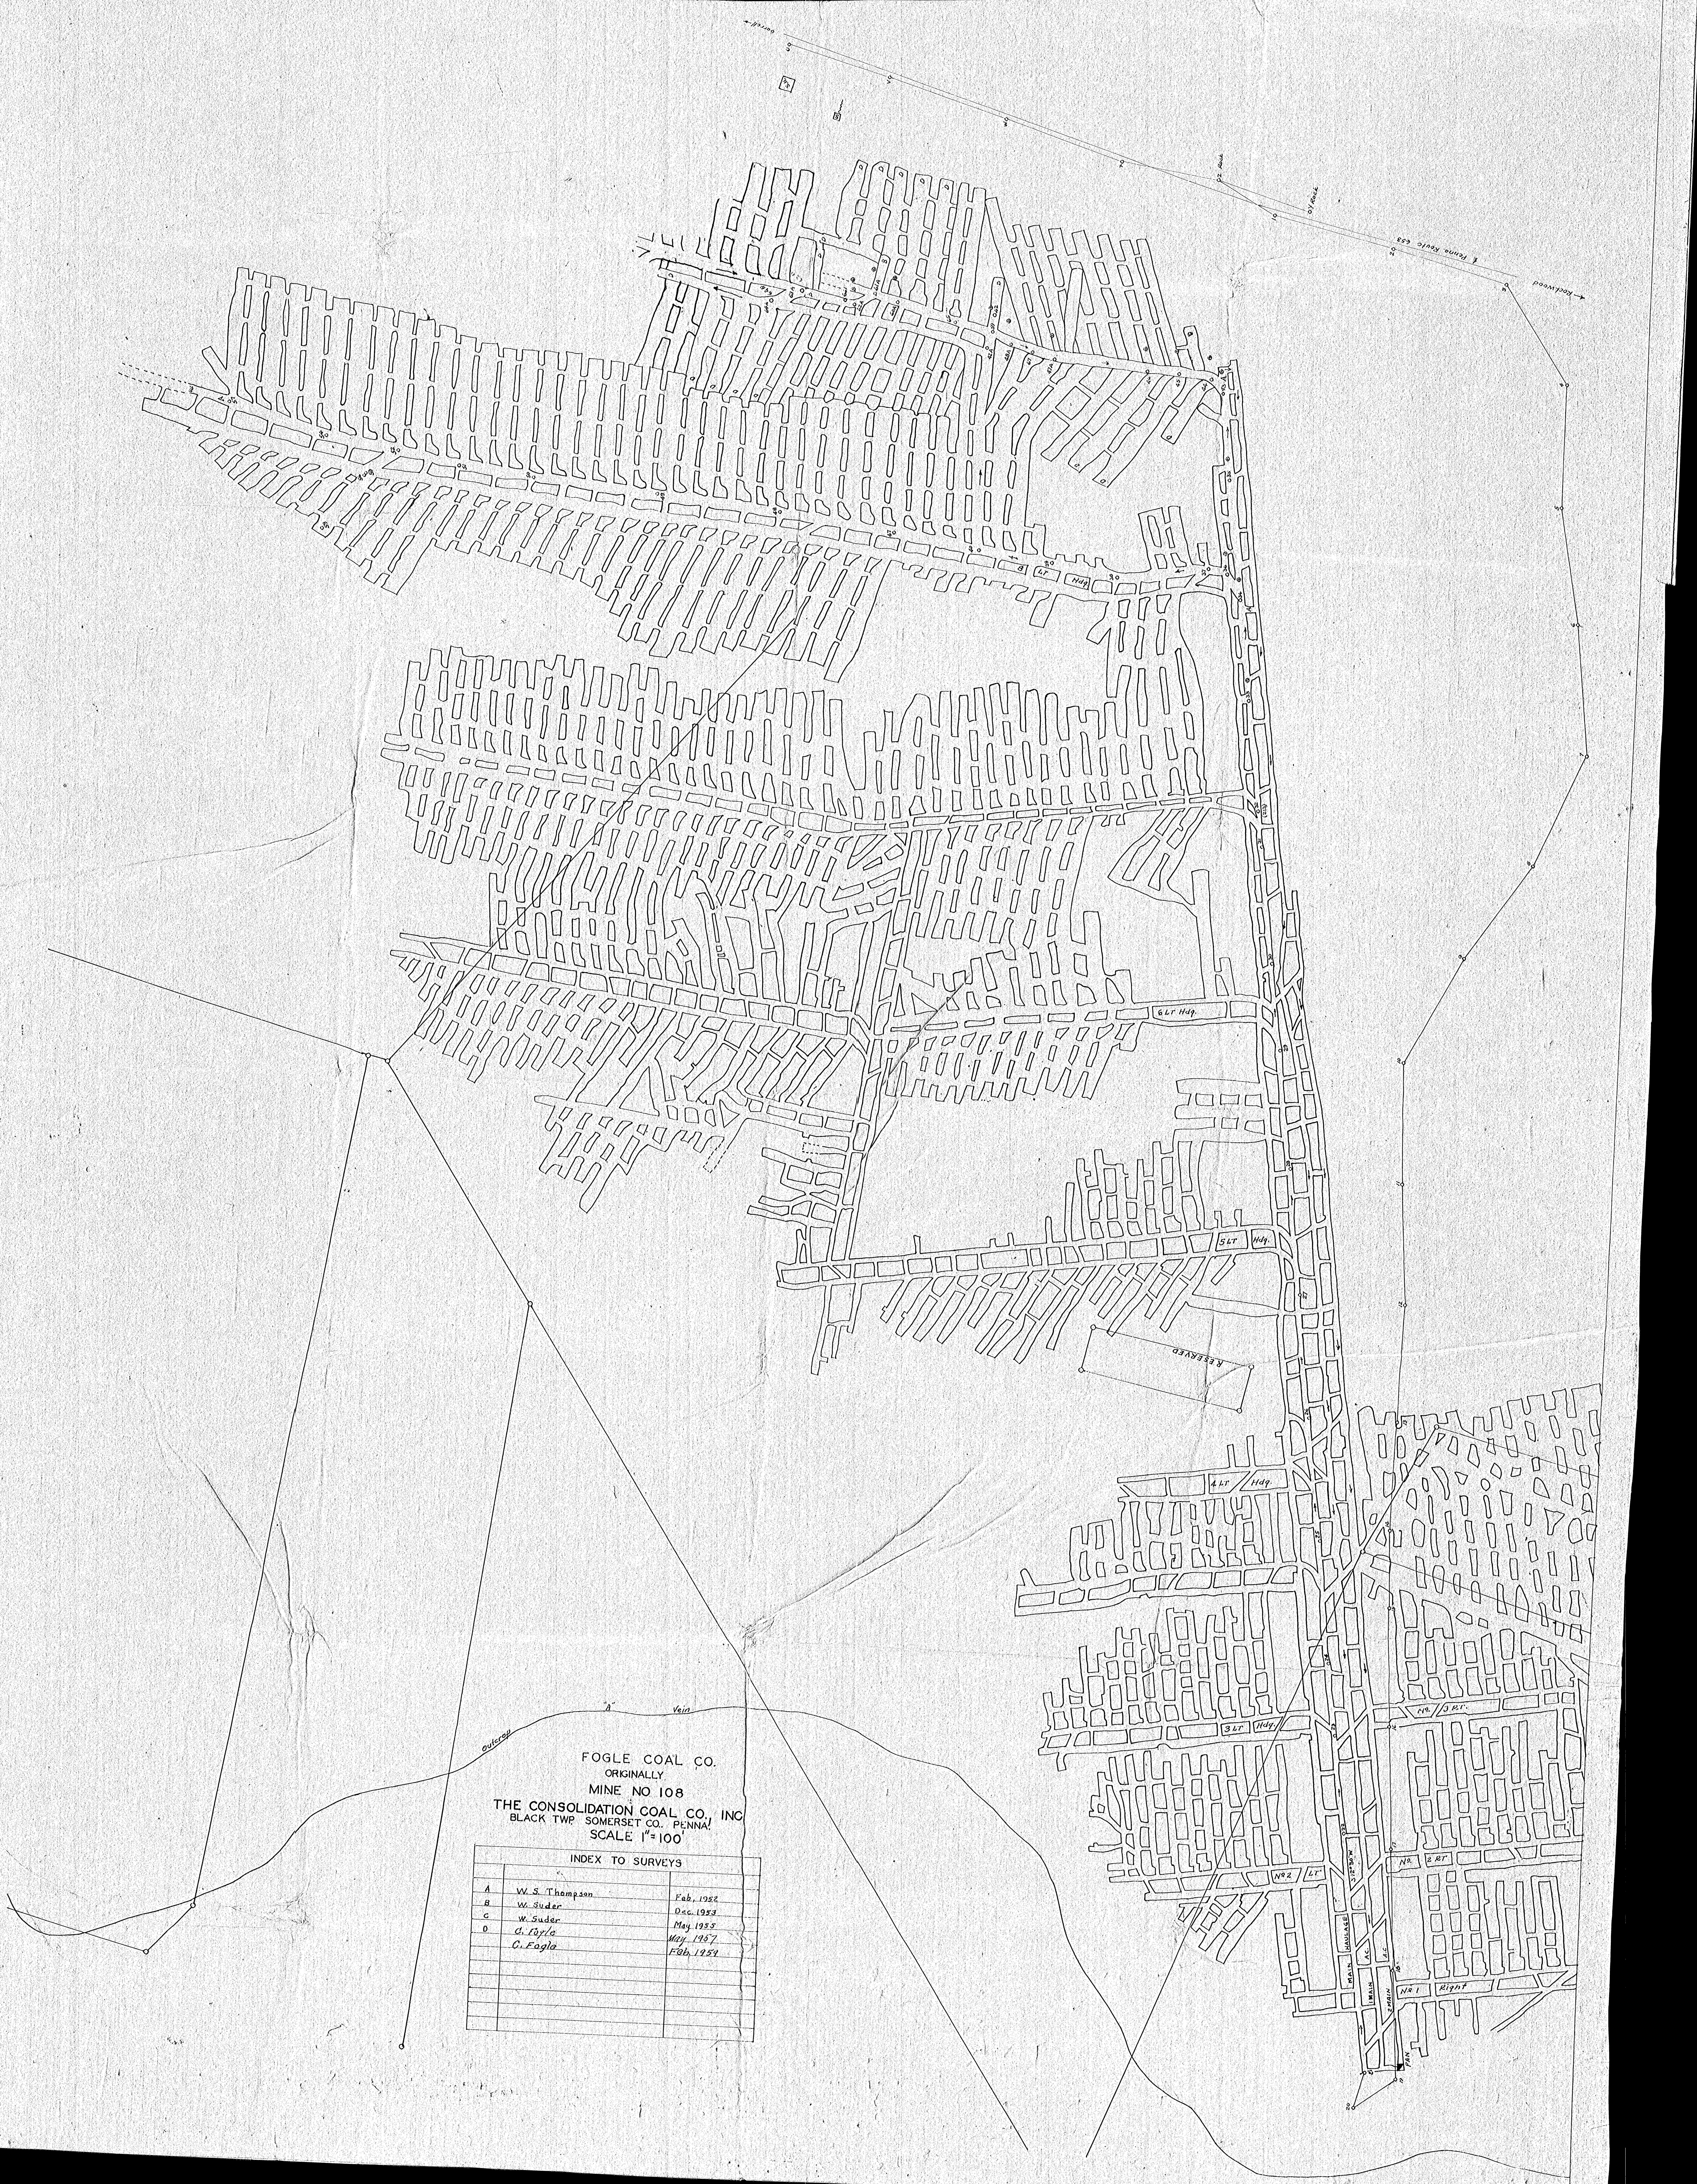
← Garrett
℄ Penna. Route 653
2 Rock
01 Rock
Rockwood →
8 LT Hdq
6 LT Hdq
5 LT Hdq
RESERVED
4 LT Hdq
3 LT Hdq
No 3 RT.
No 2 RT
No 2 LT
No 1 Right
MAIN HAULAGE
A.C.
A.C
1 MAIN
2 MAIN
S 12°30' W
FAN
Outcrop "A" Vein

FOGLE COAL CO.
ORIGINALLY
MINE NO 108
THE CONSOLIDATION COAL CO., INC
BLACK TWP SOMERSET CO., PENNA.
SCALE 1"=100'

INDEX TO SURVEYS		
A	W. S. Thompson	Feb, 1952
B	W. Suder	Dec. 1953
C	W. Suder	May 1955
D	C. Fogle	May 1957
	C. Fogle	Feb. 1959