


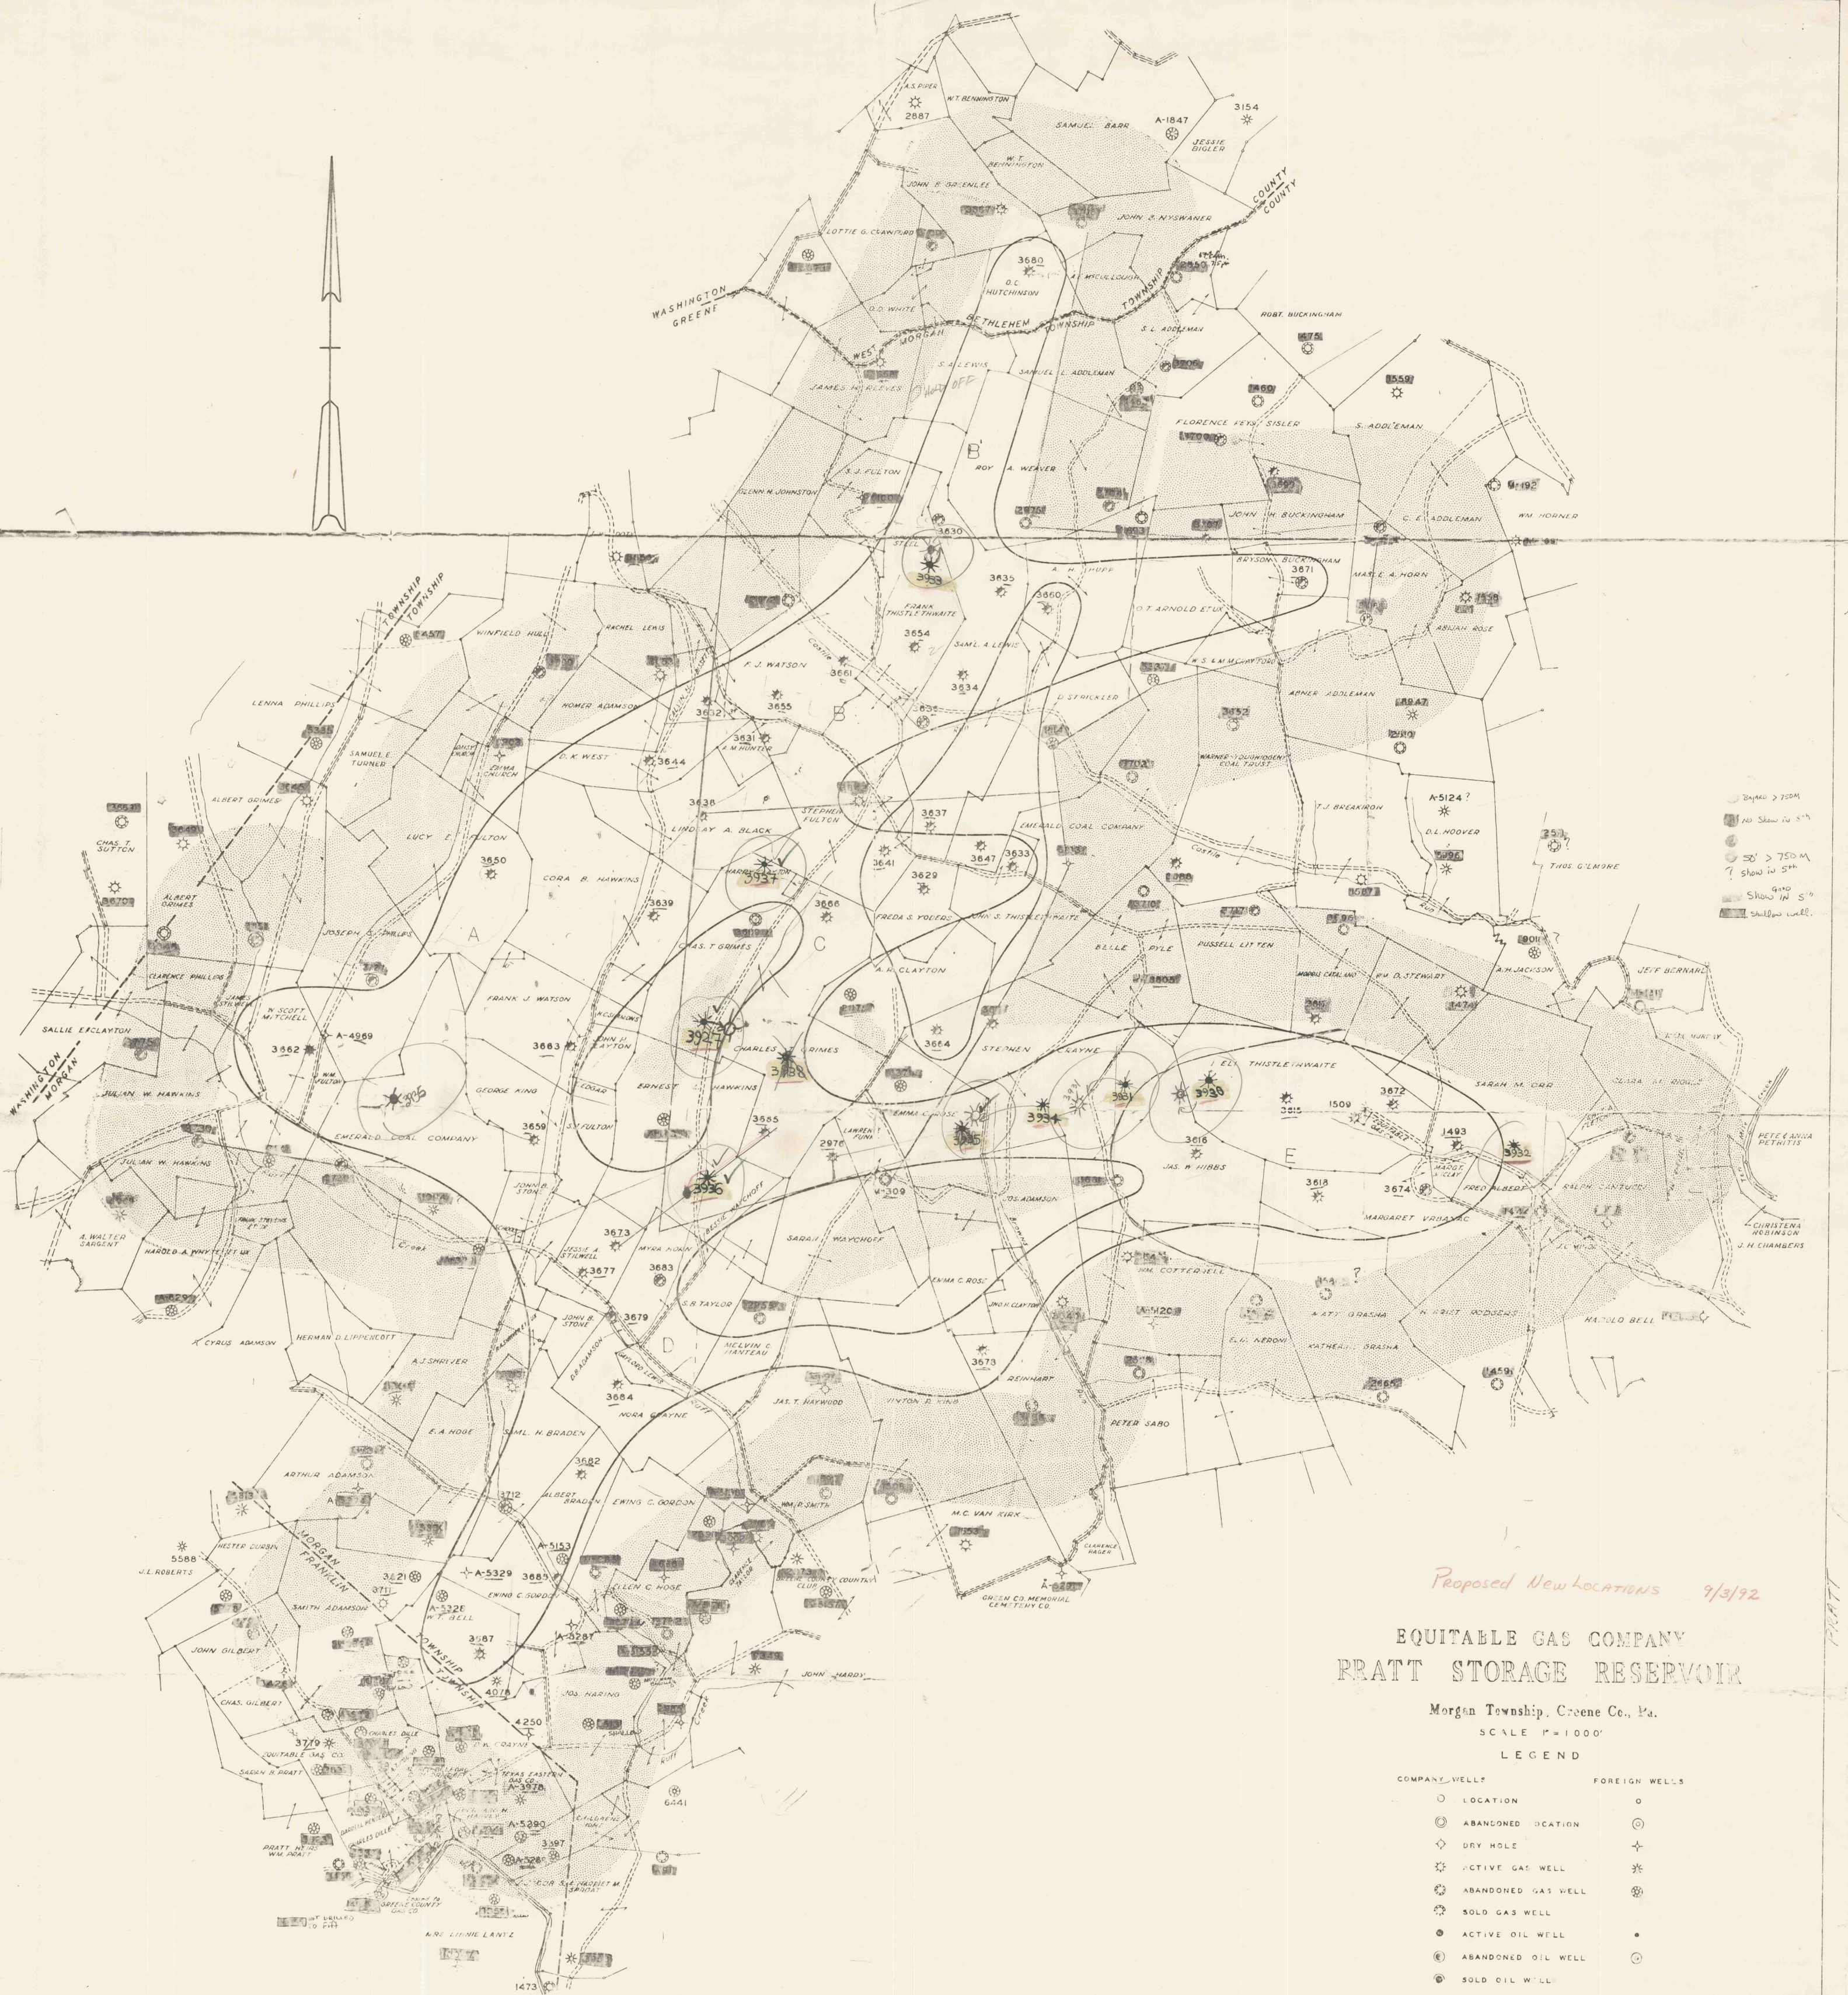

Shaded > 750M
No Show in 5th
Show in 5th
Show in 5th
Show in 5th

EQUITABLE GAS COMPANY PRATT STORAGE RESERVOIR

Morgan Township, Greene Co., Pa.
SCALE 1"=1000'

LEGEND

- | COMPANY WELLS | FOREIGN WELLS |
|---|---------------|
| ○ LOCATION | ○ |
| ⊙ ABANDONED LOCATION | ⊙ |
| ◇ DRY HOLE | + |
| ⊛ ACTIVE GAS WELL | ⊛ |
| ⊙ ABANDONED GAS WELL | ⊙ |
| ⊙ SOLD GAS WELL | ⊙ |
| ⊙ ACTIVE OIL WELL | ⊙ |
| ⊙ ABANDONED OIL WELL | ⊙ |
| ⊙ SOLD OIL WELL | ⊙ |
| ⊙ COMBINATION OIL AND GAS WELL | ⊙ |
| ⊙ GAS STORAGE WELL | ⊙ |
| ⊙ ABANDONED GAS STORAGE WELL | ⊙ |
| ⊙ STORAGE RESERVOIR - FIFTH SAND & FIFTY FOOT SAND (DRY HOLE PERIMETER) | |
| ⊙ RESERVOIR PROTECTIVE AREA | |
| ⊙ OPERATING EXPERIENCE PERIMETER | |

REV. APRIL 1, 1962
REV. OCT. 1, 1960