


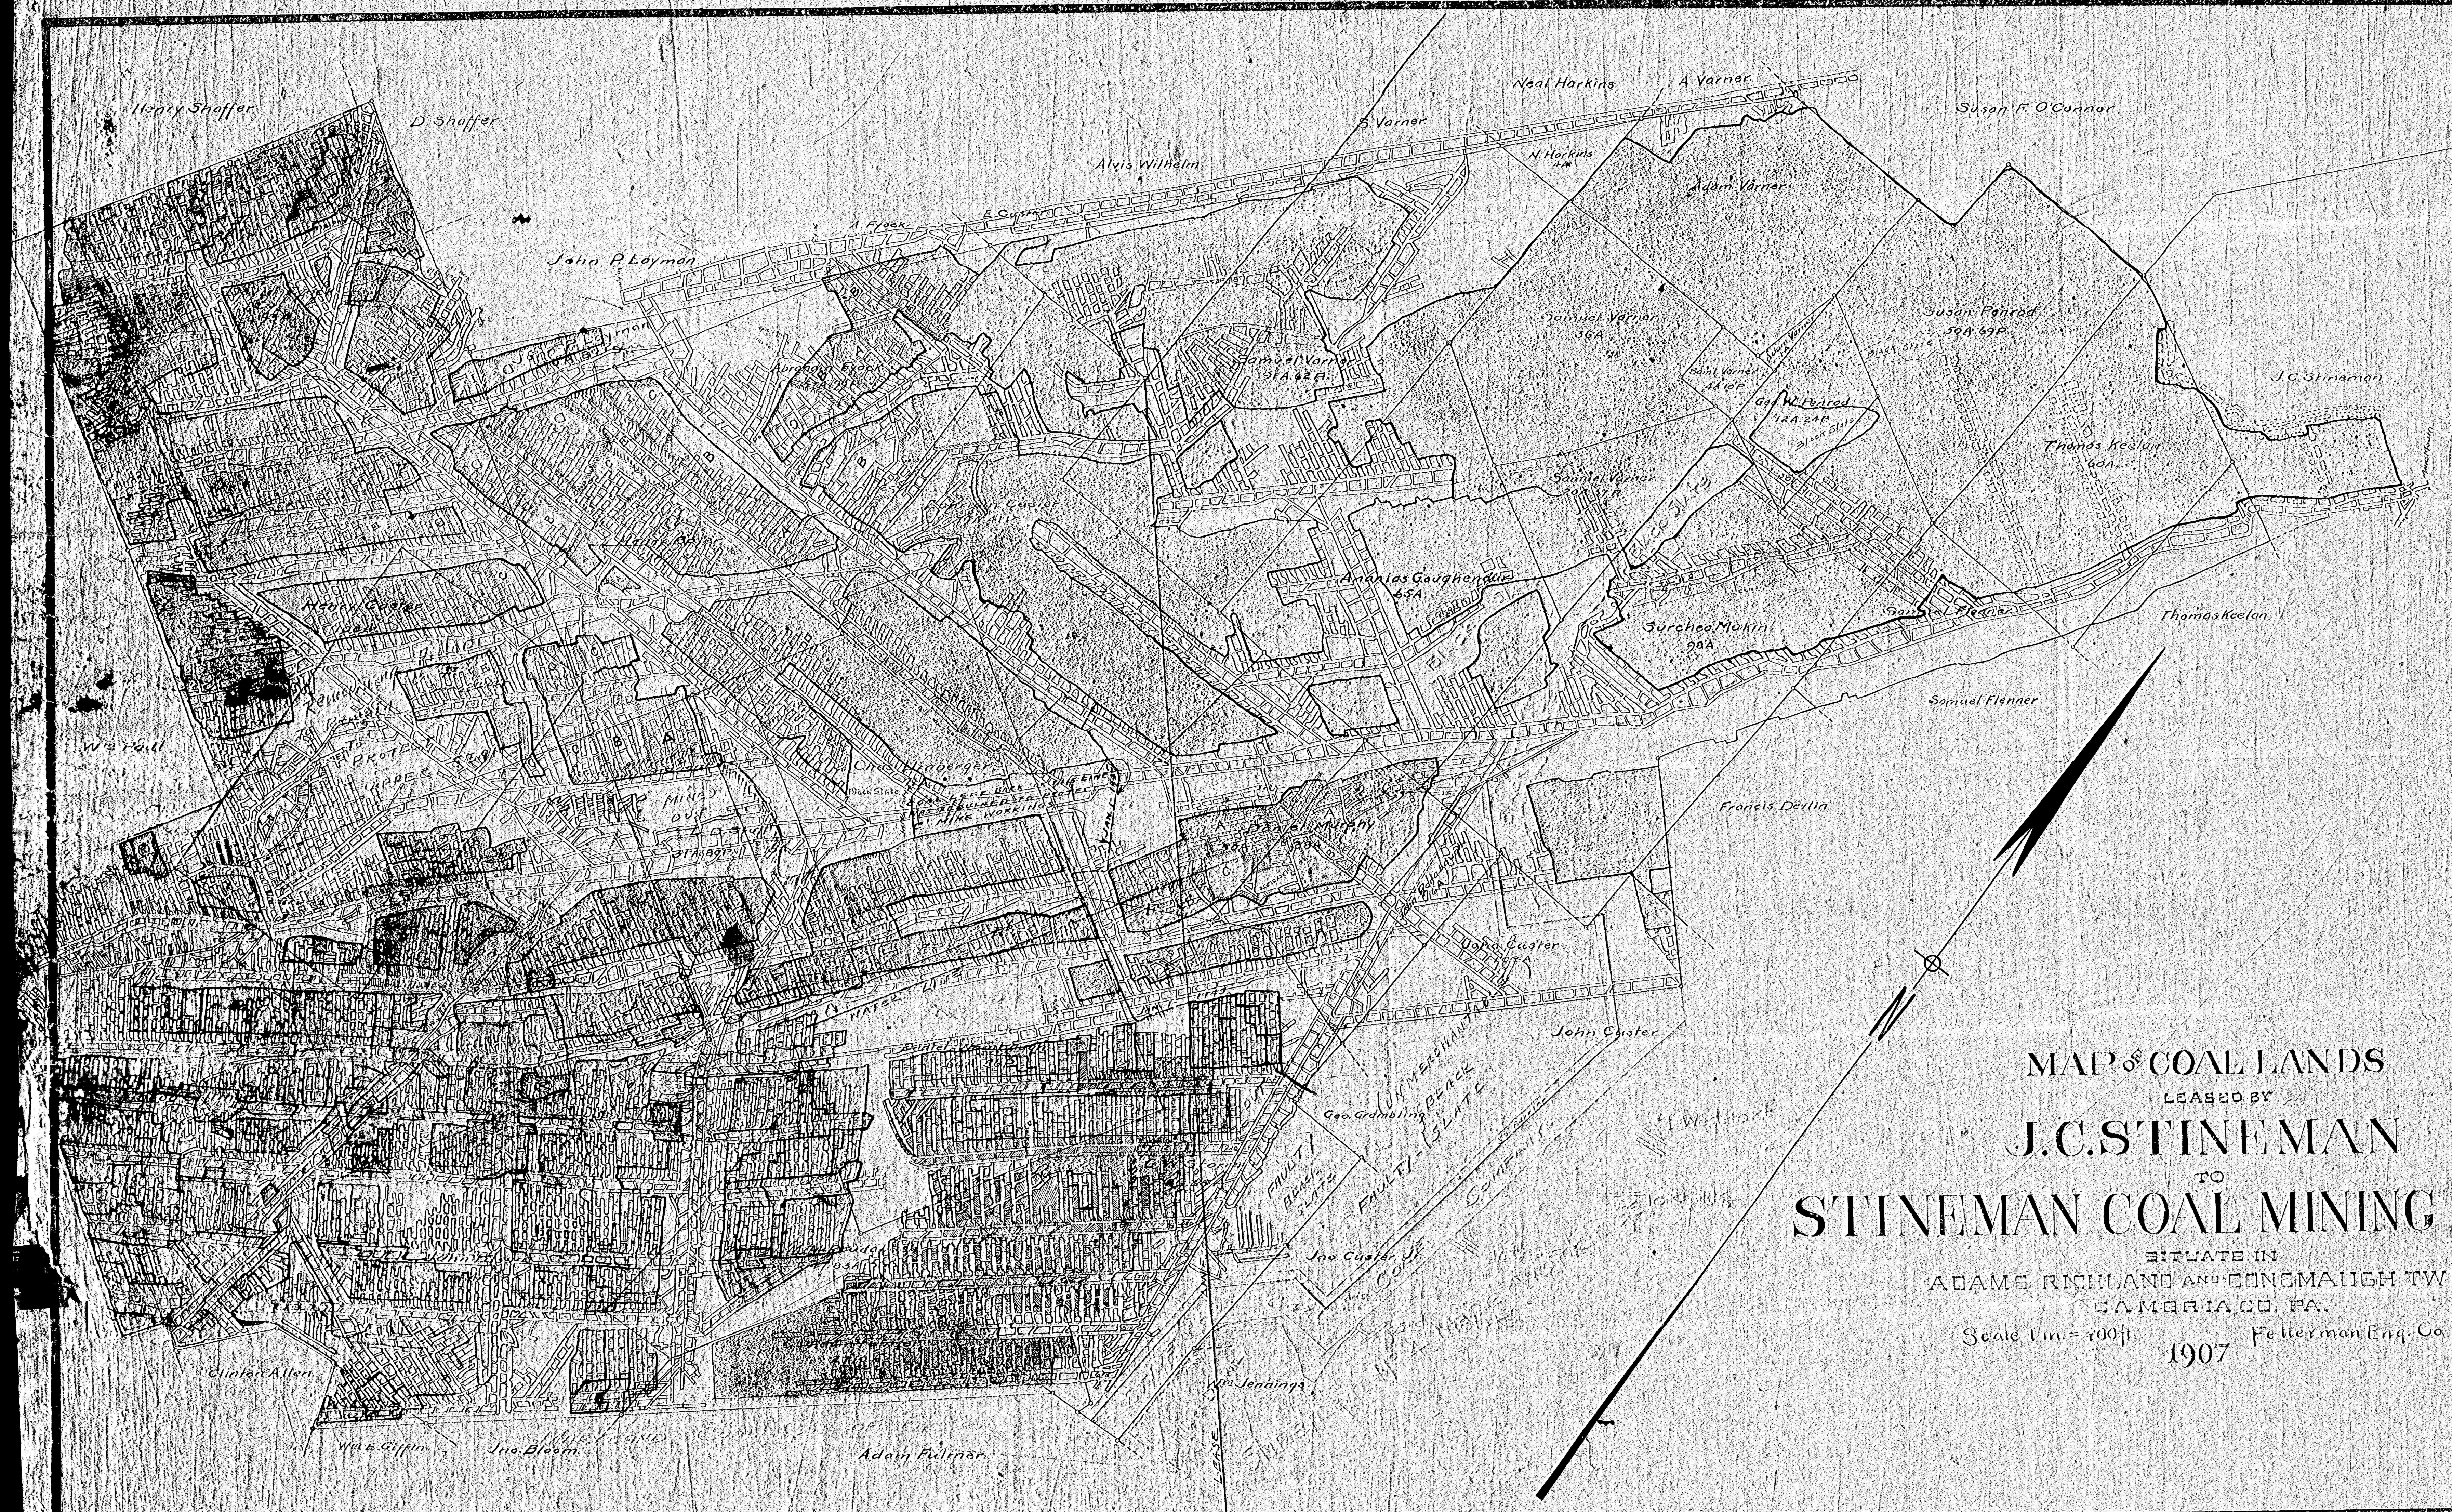

MAP OF COAL LANDS
LEASED BY
J.C. STINEMAN
TO
STINEMAN COAL MINING CO. NO. 1
SITUATE IN
ADAMS RICHLAND AND CONEMAUGH TWP
CAMBRIA CO., PA.
