




BARNES & TUCKER CO.
LANCASHIRE NO. 26
GREENWICH COLLIERIES

GREEN TWP. INDIANA COUNTY, PA.
SCALE: 1"=100' SURVEY DATE: 8-19-69

Ronald Shiff

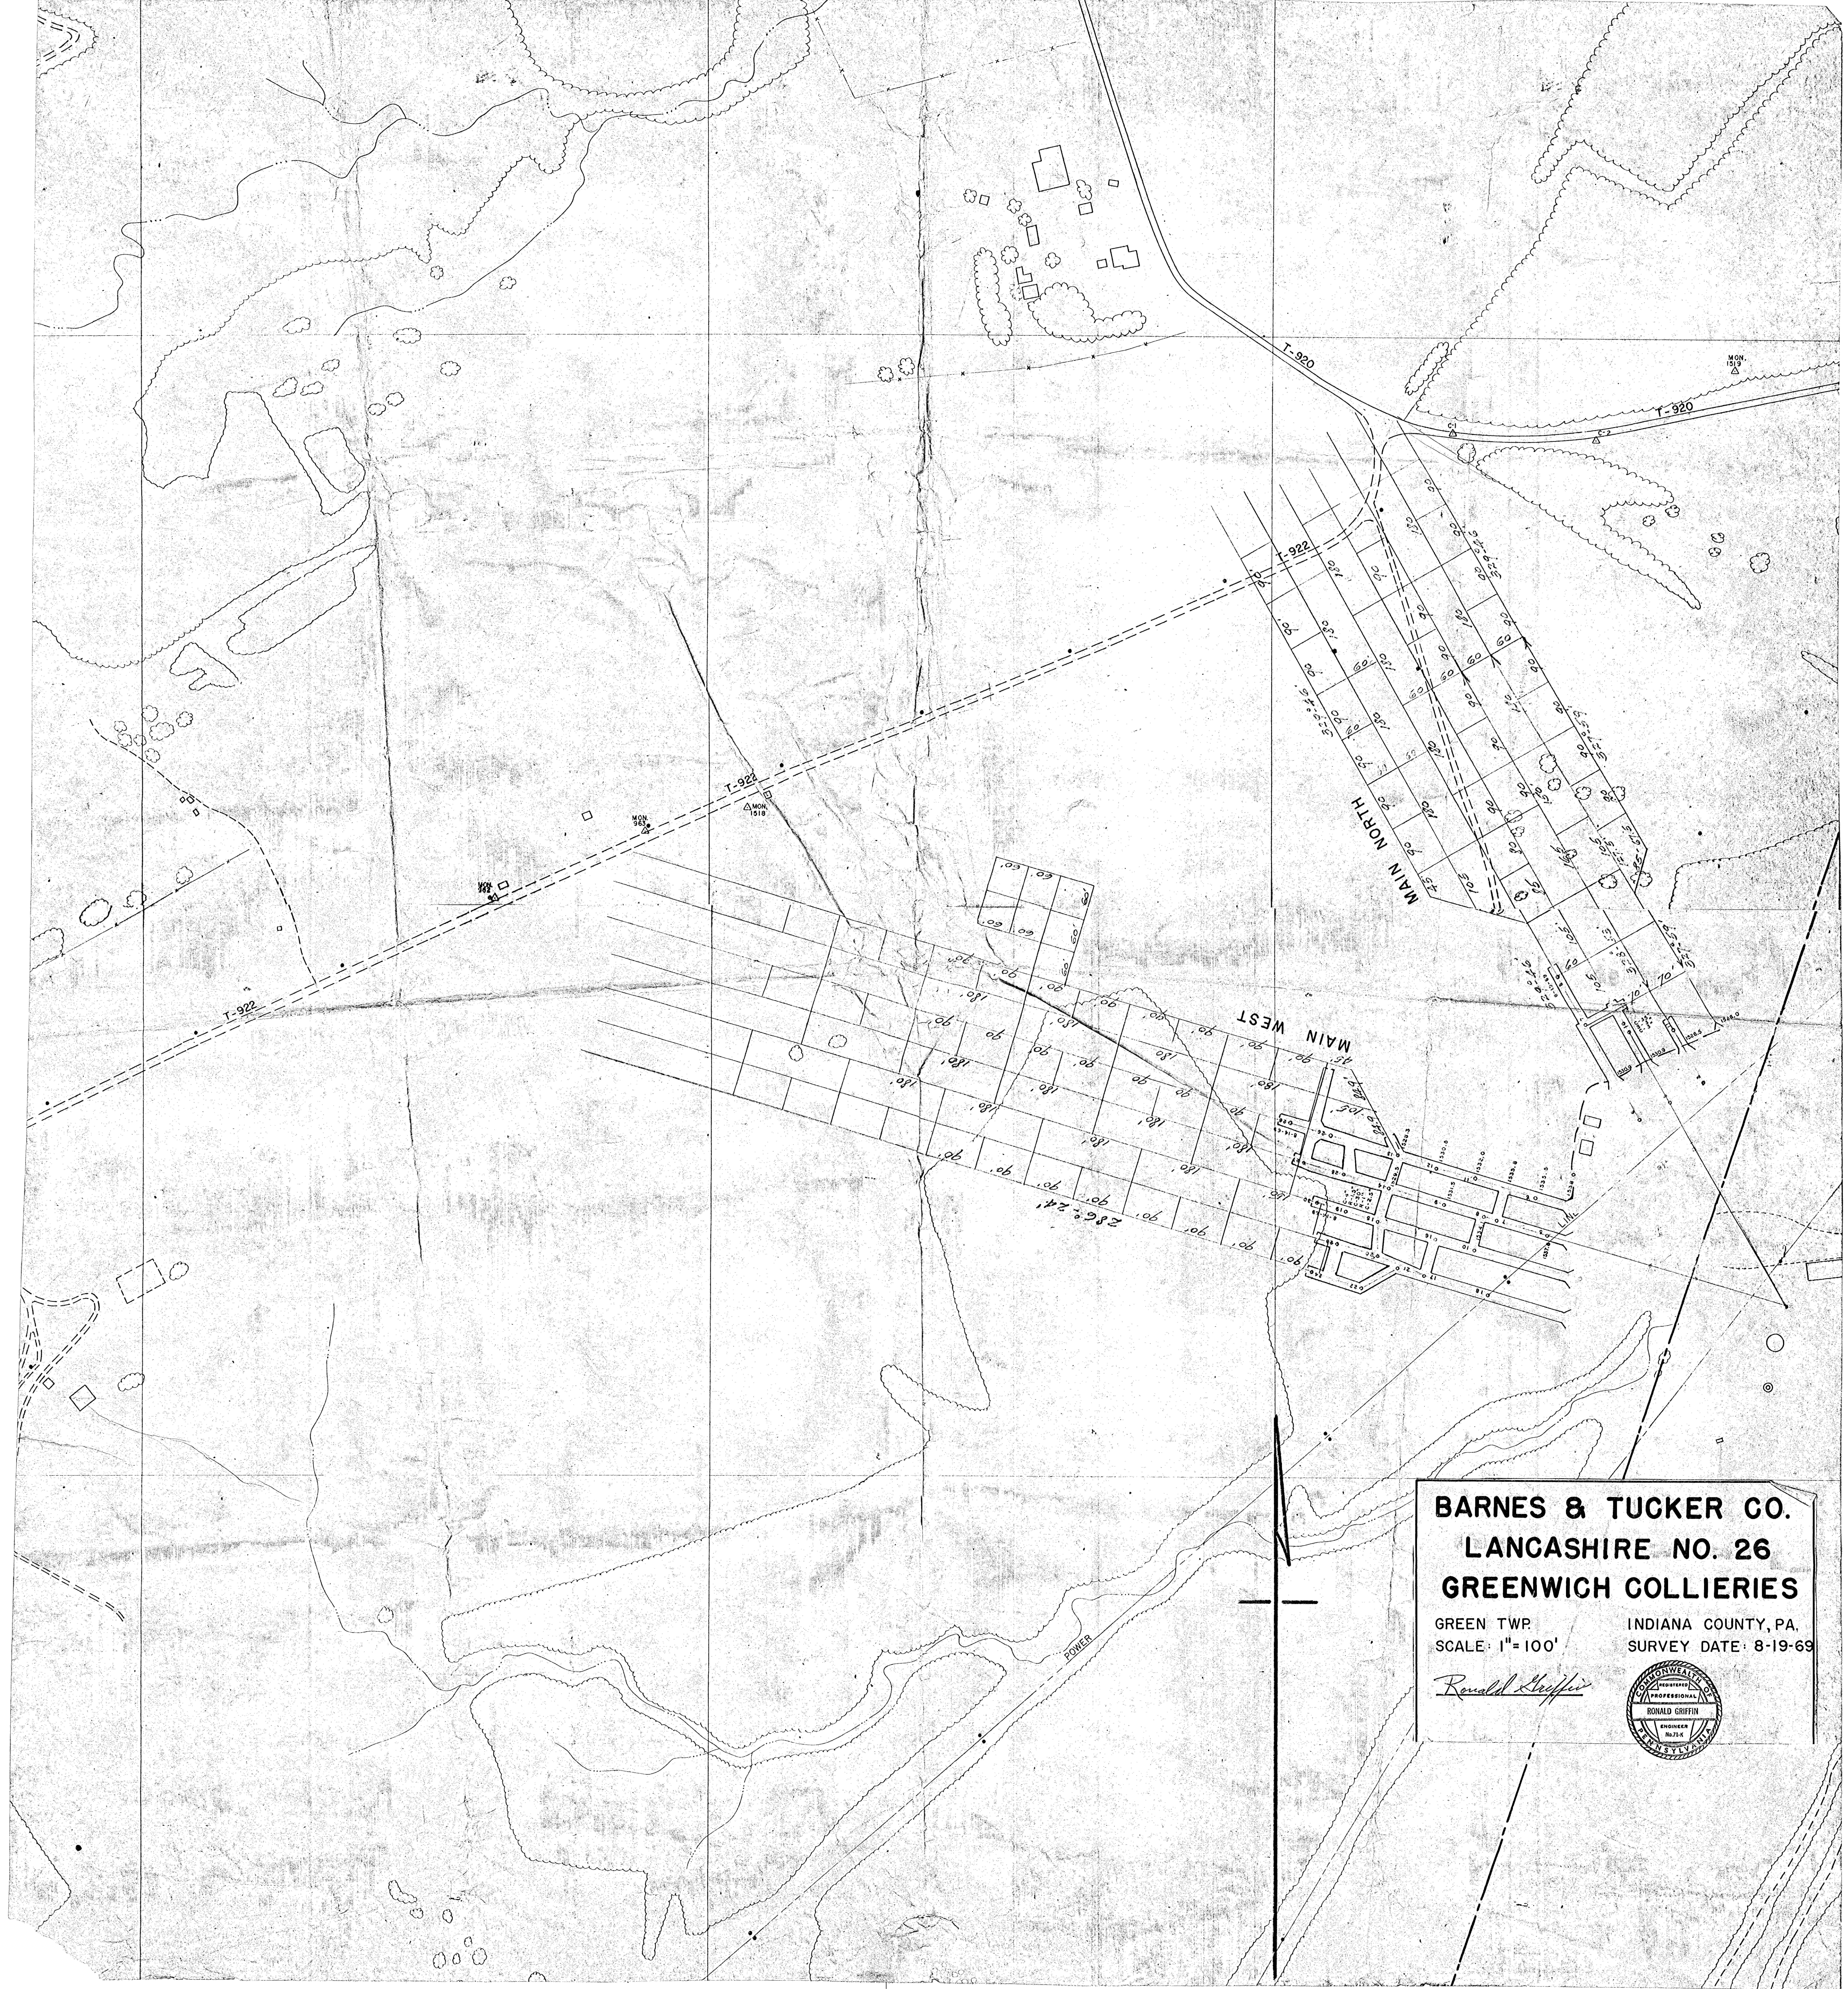