


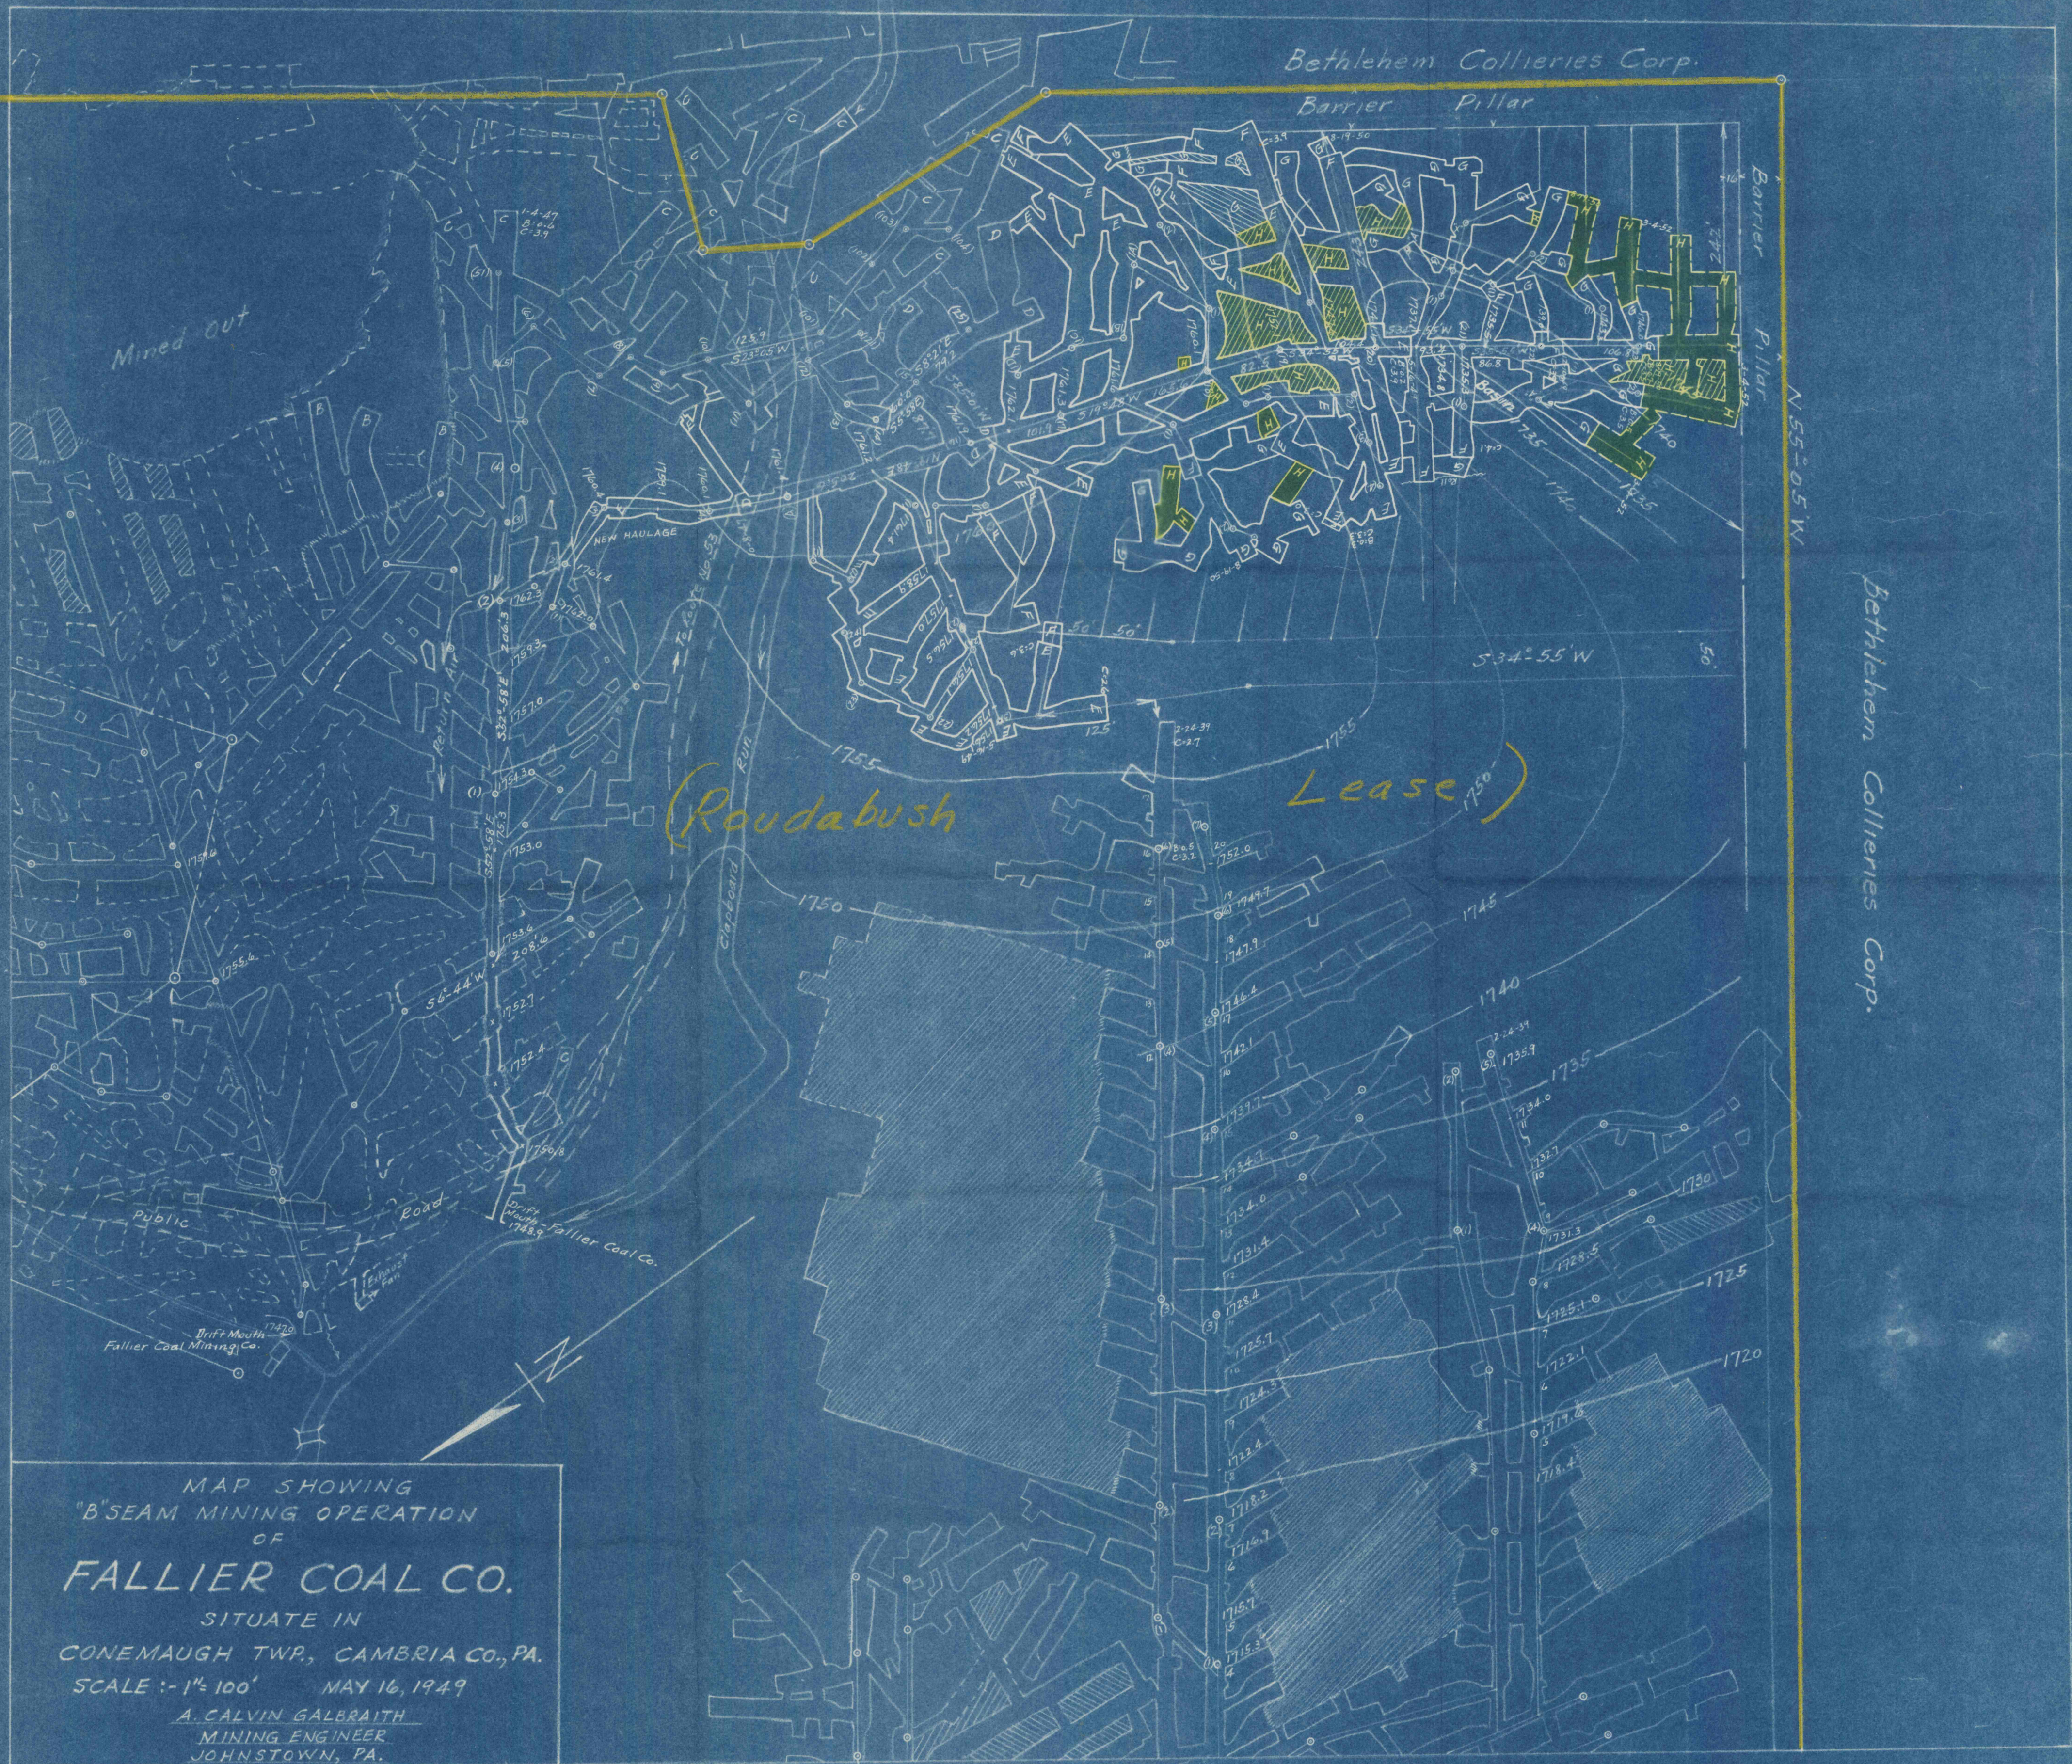

MAP SHOWING
"B" SEAM MINING OPERATION
OF
FALLIER COAL CO.
SITUATE IN
CONEMAUGH TWP., CAMBRIA CO., PA.
SCALE :- 1" = 100' MAY 16, 1949
A. CALVIN GALBRAITH
MINING ENGINEER
JOHNSTOWN, PA.

Map Posted to March 4, 1952