


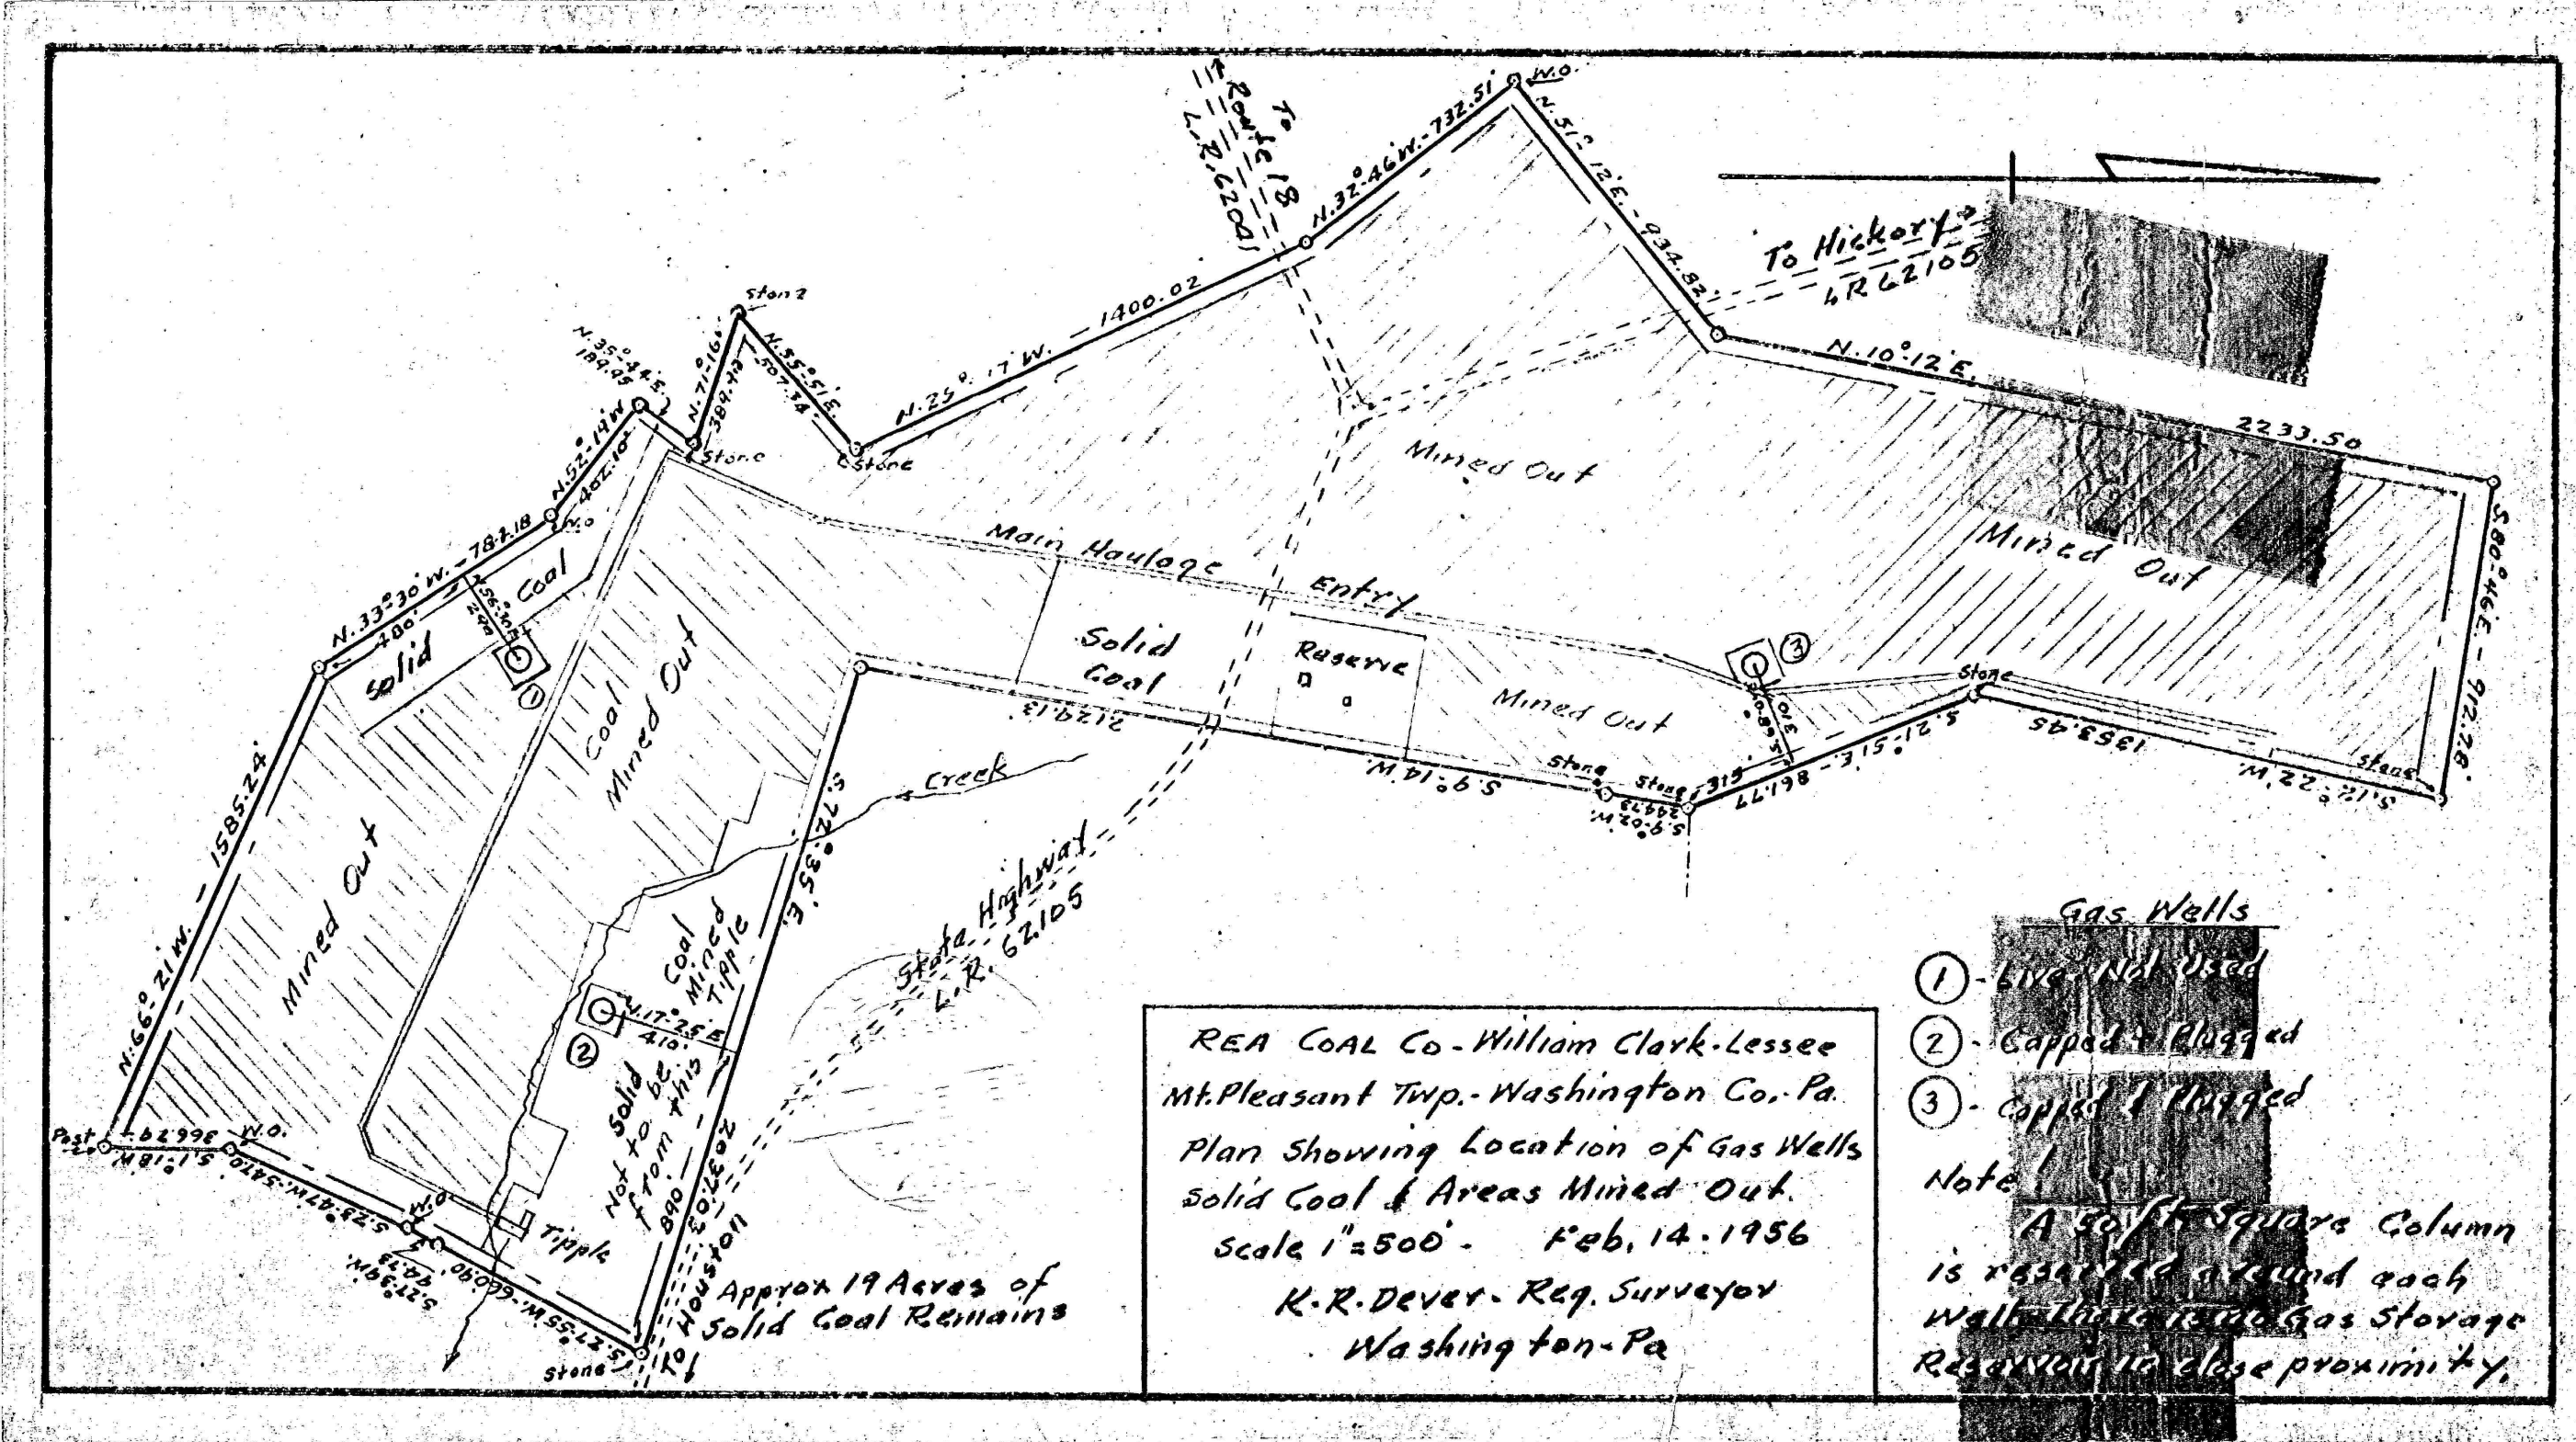

REA COAL Co - William Clark - Lessee  
Mt. Pleasant Twp. - Washington Co. Pa.  
Plan Showing Location of Gas Wells  
Solid Coal & Areas Mined Out.  
Scale 1"=500' - Feb. 14, 1956  
K. R. Dever - Reg. Surveyor  
Washington - Pa.

**Gas Wells**  
① - Live - Not Used  
② - Capped & Plugged  
③ - Capped & Plugged  
**Note:**  
A 50 ft. square column  
is reserved around each  
well there is no Gas Storage  
Reservoir in close proximity.