


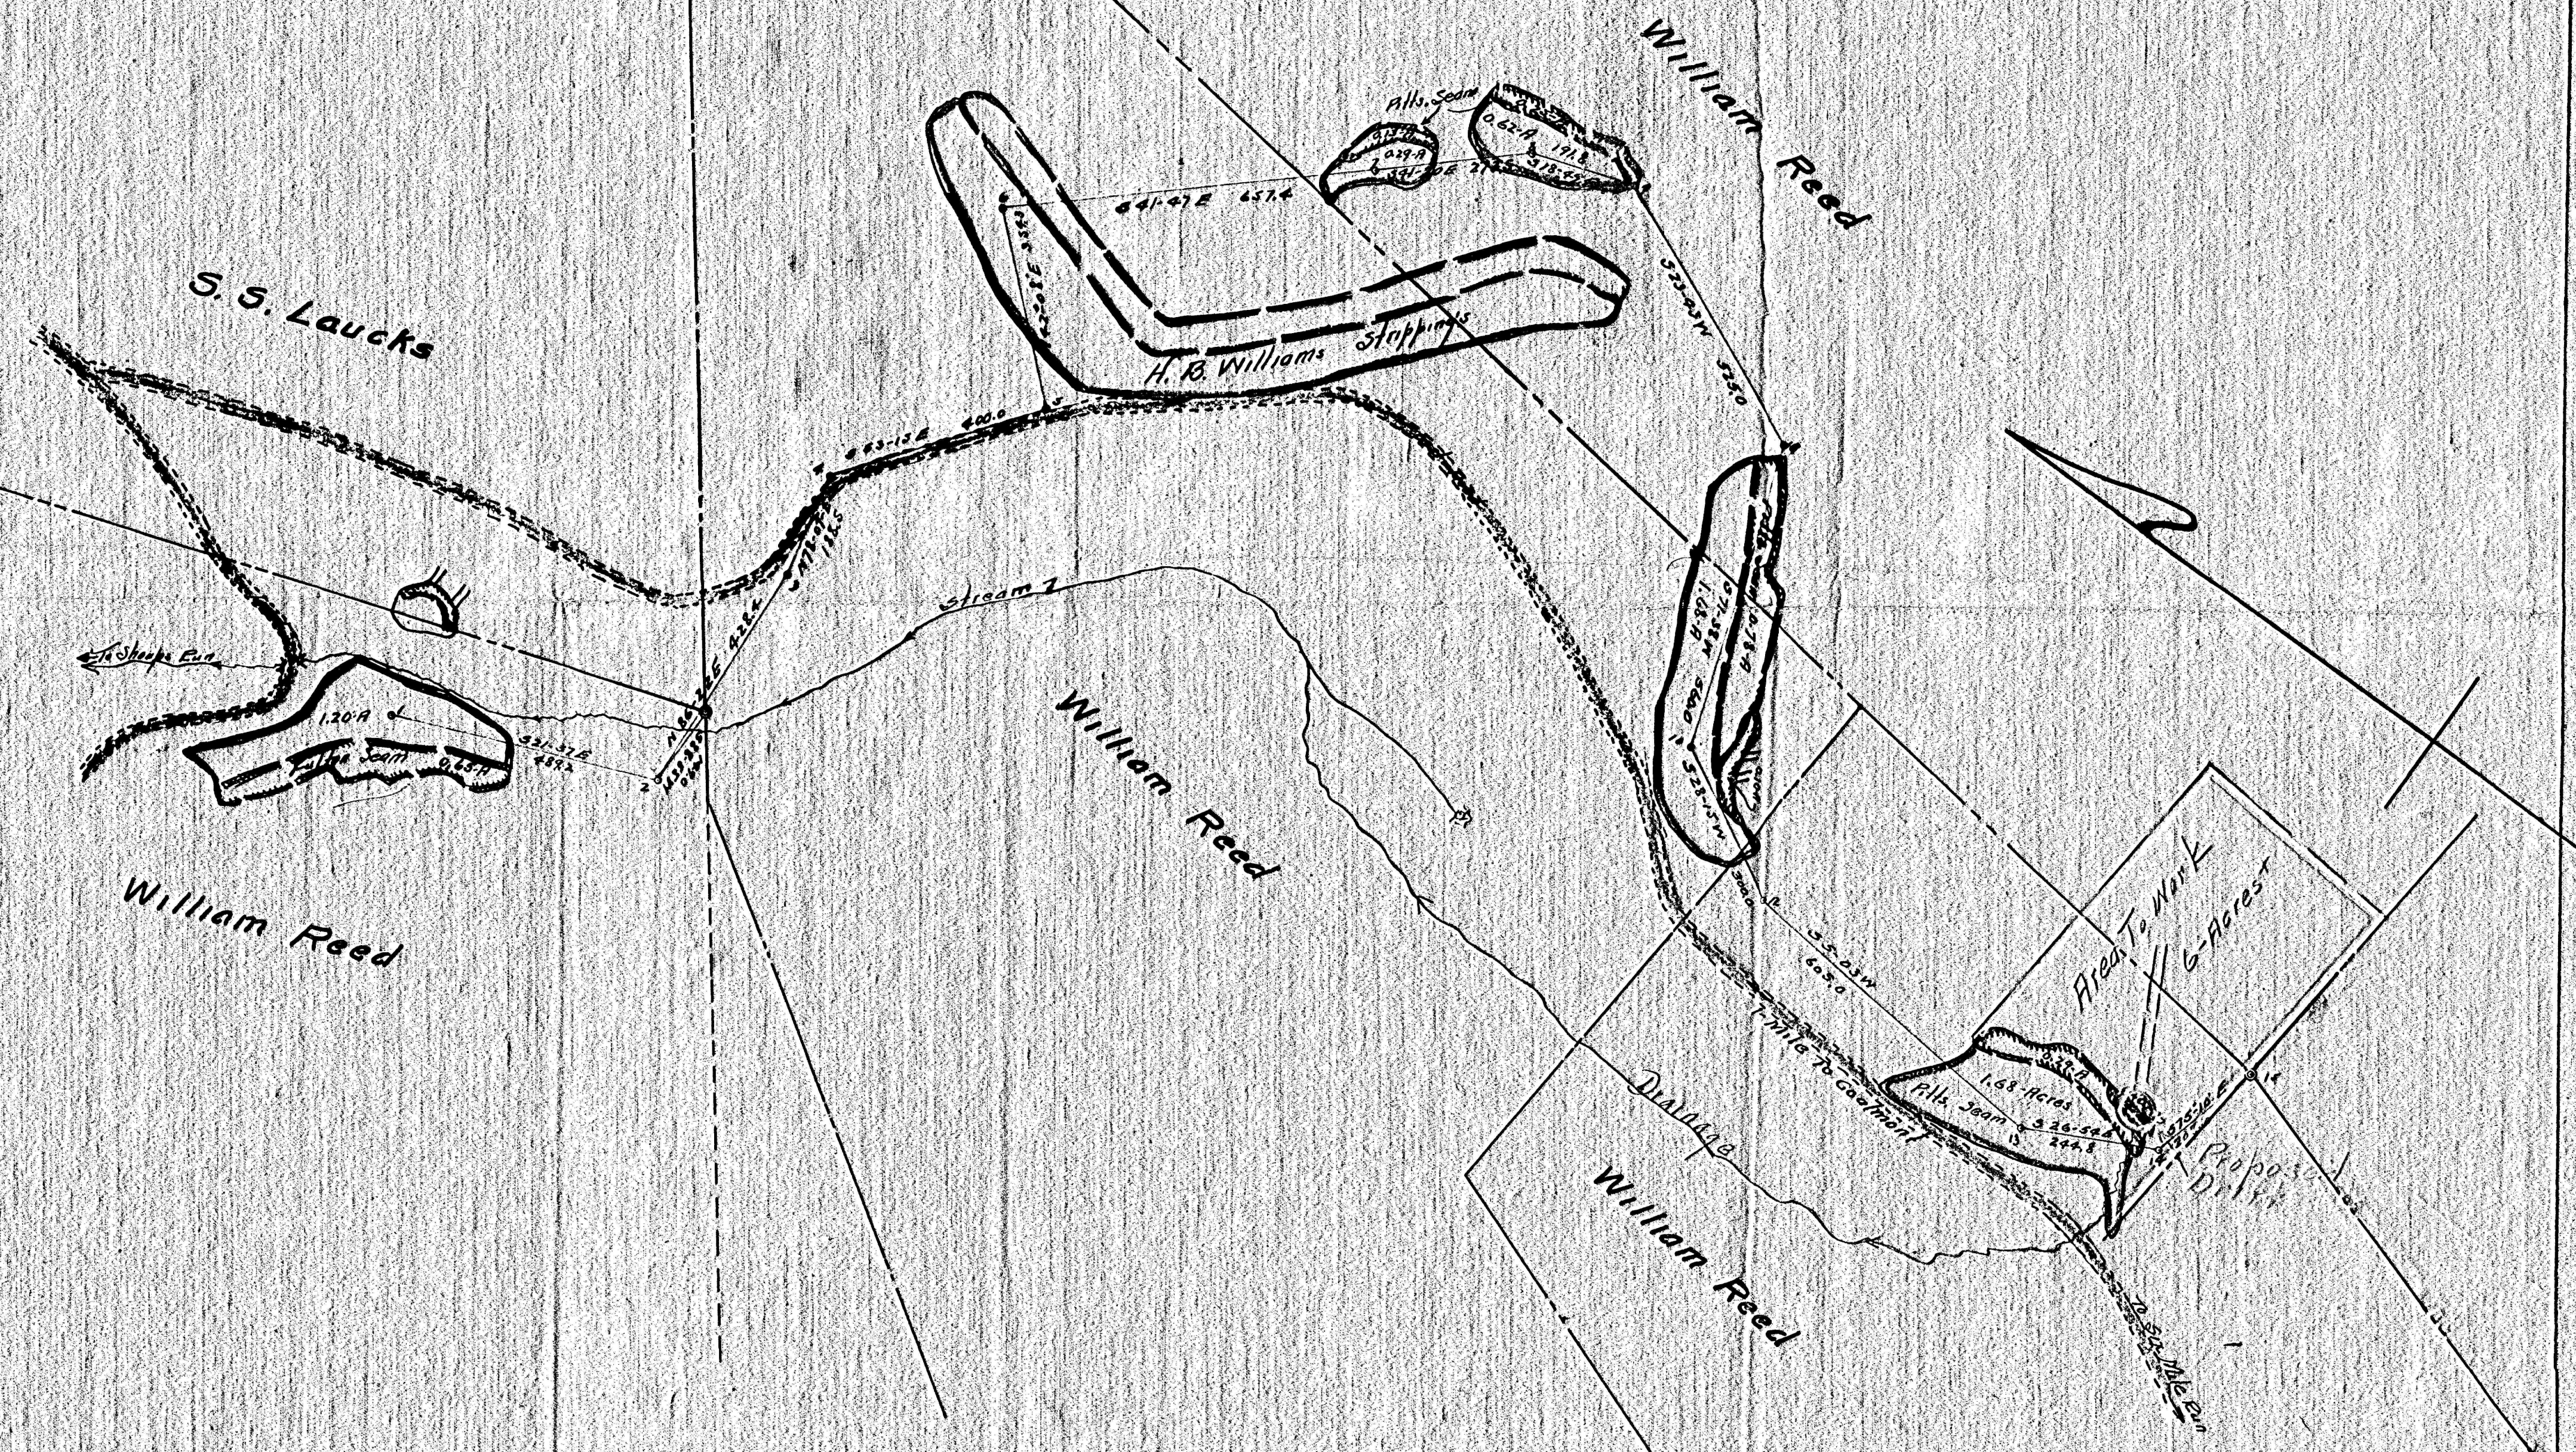

Map To Accompany Report Relative To Coal Mine Drainage Filled With The Sanitary Water Board 1" = 200'
Dept of Health Harrisburg Pennsylvania Situated in Carbon Twp Huntingdon County Penna Dec, 1957 E. Corrie Engr.