


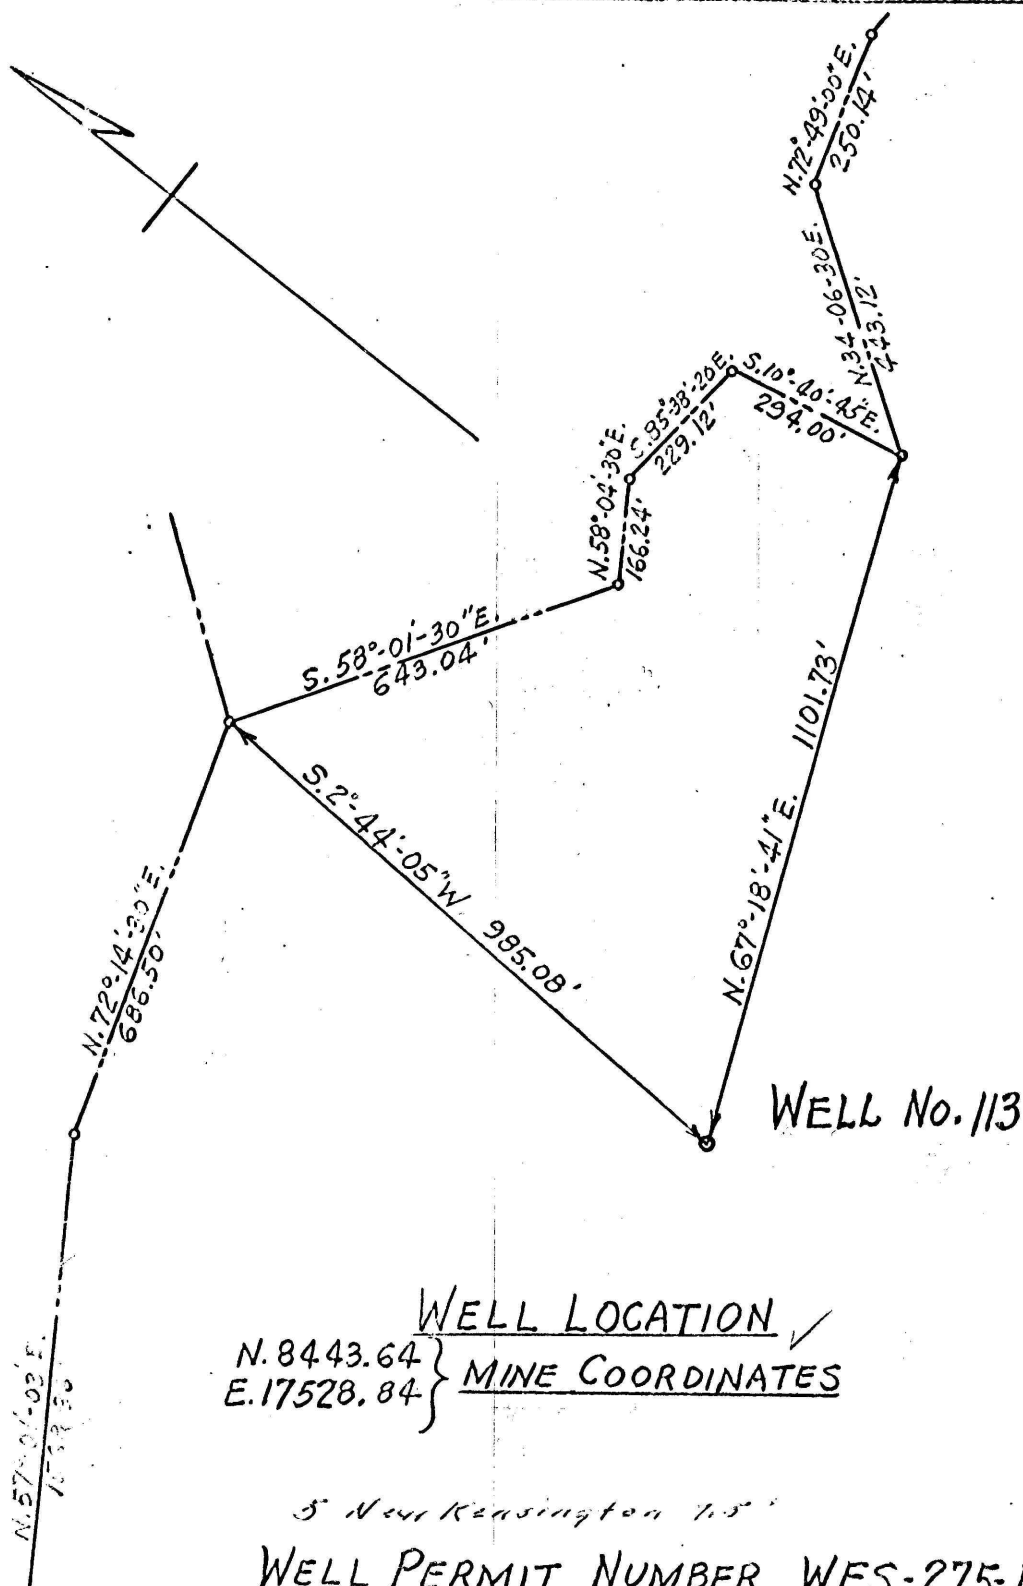

WELL LOCATION ✓
 N. 8443.64 }
 E. 17528.84 } MINE COORDINATES

5' New Kensington T.S.

WELL PERMIT NUMBER WES-275-R

COAL OPERATORS PROPOSED WELL PILLAR PLAN	WELL OPERATOR
Company <u>Allegheny Pittsburgh Coal Co.</u>	Company <u>David R. Fink</u>
Address <u>Cabin Hill, Greensburg, Pa.</u>	Address <u>R.D. 1, New Kensington, Pa.</u>
Mine <u>Springdale Mine</u>	Well (Farm) No. <u>1</u> Serial No. _____
Section _____	Kind of Well (Oil or Gas) <u>Gas</u>
Surface Elev. _____ Elev. Bottom of Coal _____	Farm <u>David R. Fink</u>
Coal Seam <u>Upper Freeport</u>	County <u>Westmoreland</u>
Engineer <u>Richard J. Walter</u>	City of <u>Lower Burrell</u>
Eng. Reg. No. <u>5605-E</u> Company Well No. <u>113</u>	Well not <u>Well not</u>
Date <u>8-31-61</u> Scale <u>1 in. = 300 ft.</u>	Well Operating or Abandoned <u>completed</u>
	Department File No. _____

DEC 18 1961