


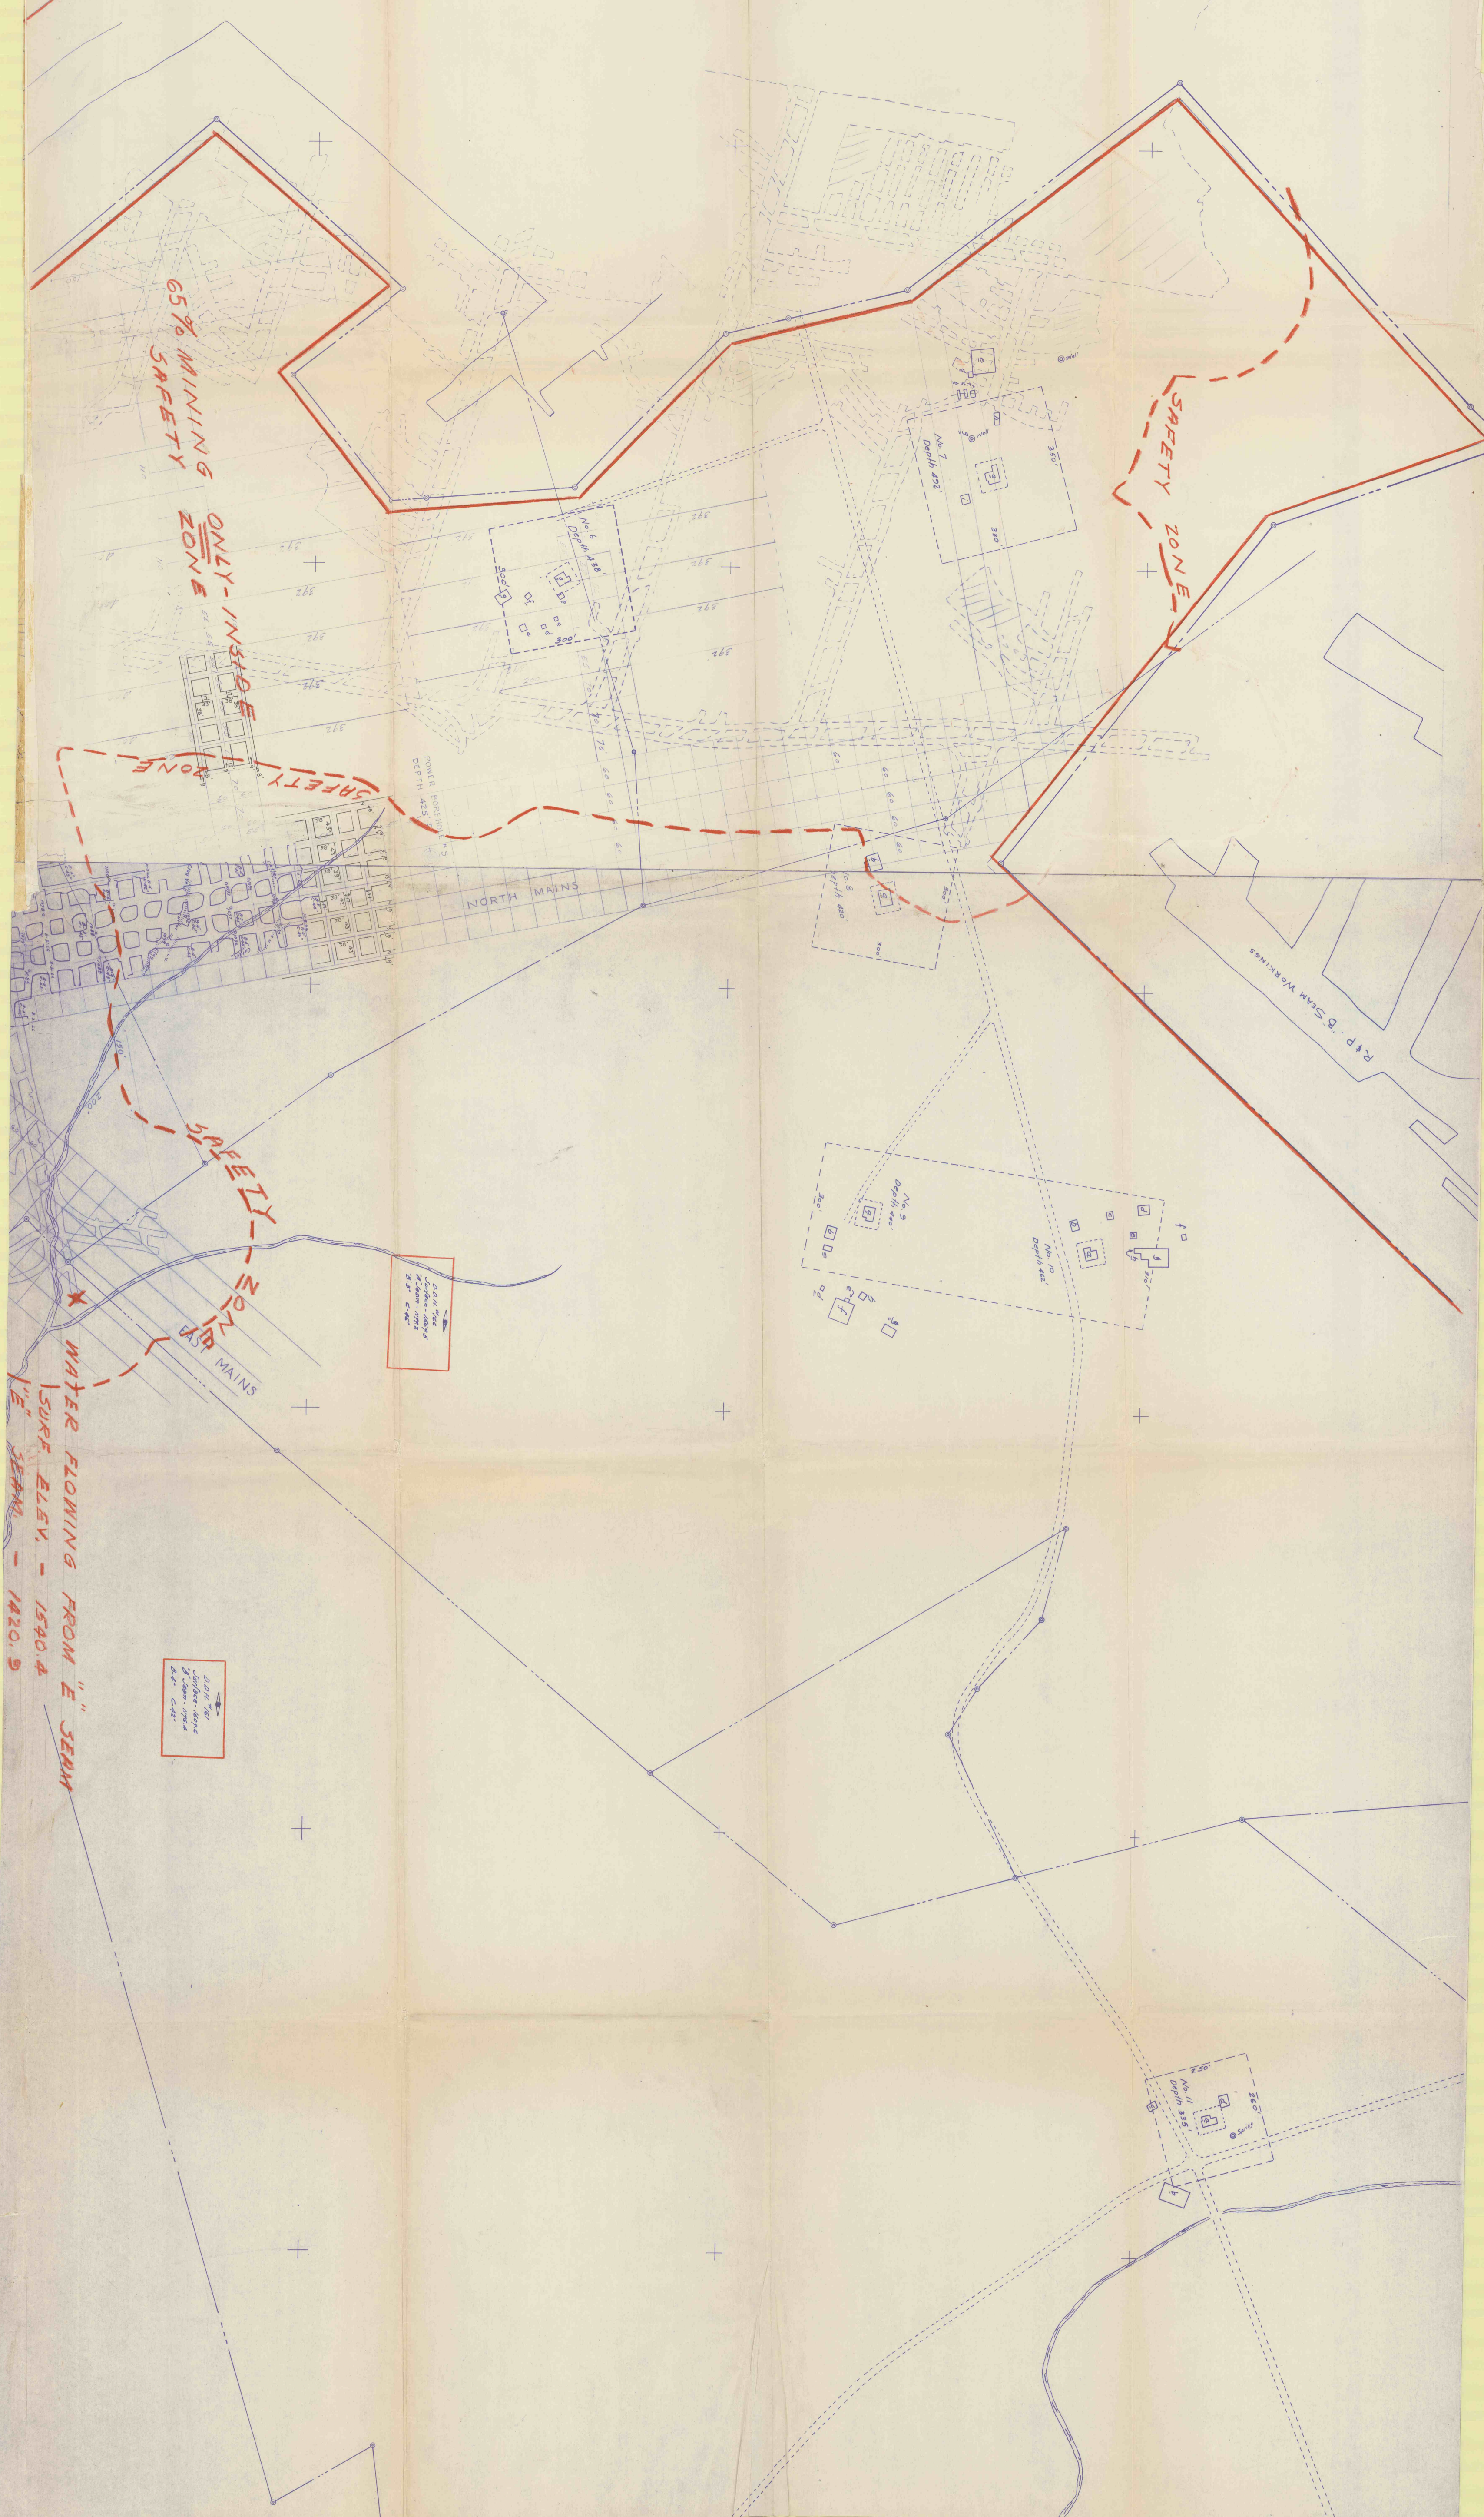



WATER FLOWING FROM "E" SEAM
SURF. ELEV. - 1540.4
"E" SEAM - 1420.9