


Fit to 102 102

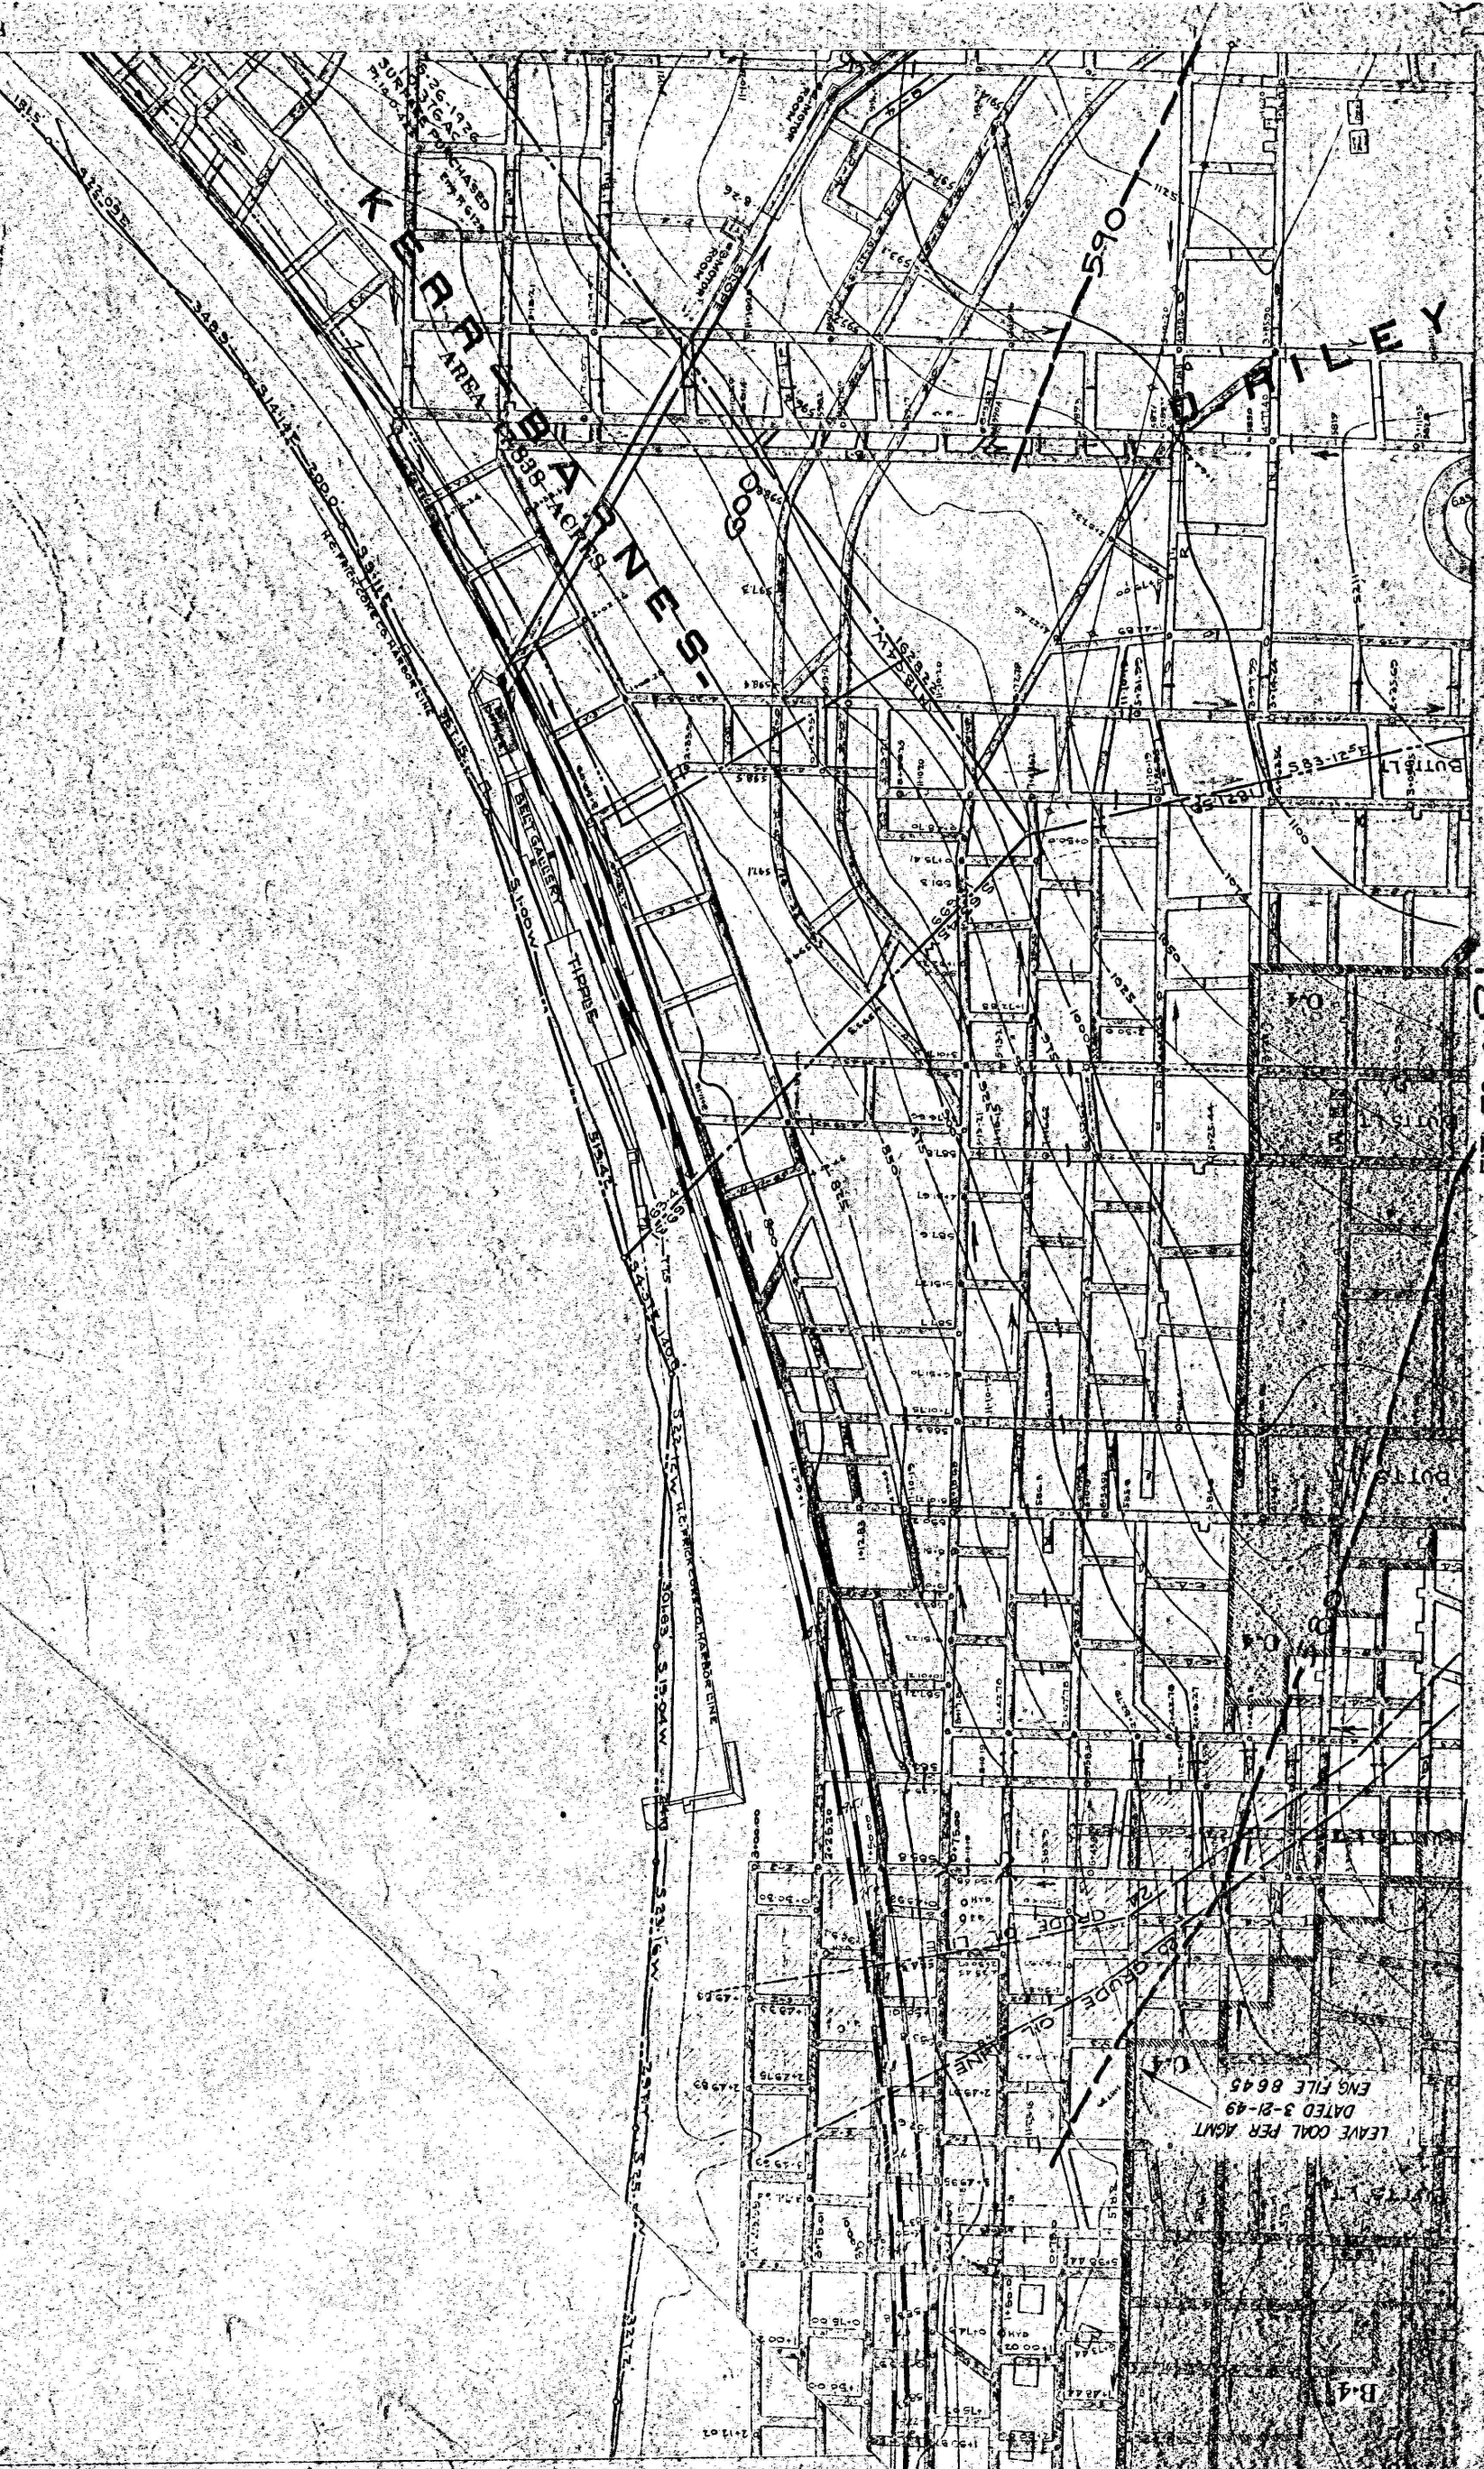

Fit to 103 103

LEAVE COAL PER AGHT
DATED 3-21-49

Fit to 104 104

PALMER 103