

PALMER MINE

UNITED STATES STEEL CORPORATION

FAYETTE COUNTY PA.

German Twp.

SCALE

1 INCH = 100 FT.

DATE OF LEVELS

U.S. GEOLOGICAL SURVEY

DATE OF LAST SURVEY

DATE	Survey Letter	Survey By	Level By	DATE	Survey Letter	Survey By	Level By

REASSIGNMENT









Sheet 105

105	101	103	102	100
33	92	91	98	97
		01	98	97
	10	93	90	91
	95	94	92	93
		95	98	91
	33	94		

M O N O G A H E L A R I V E R

SEE POOL FULL TOOTH
ELEV. HIGH WATER 1831

Fit to 105 105

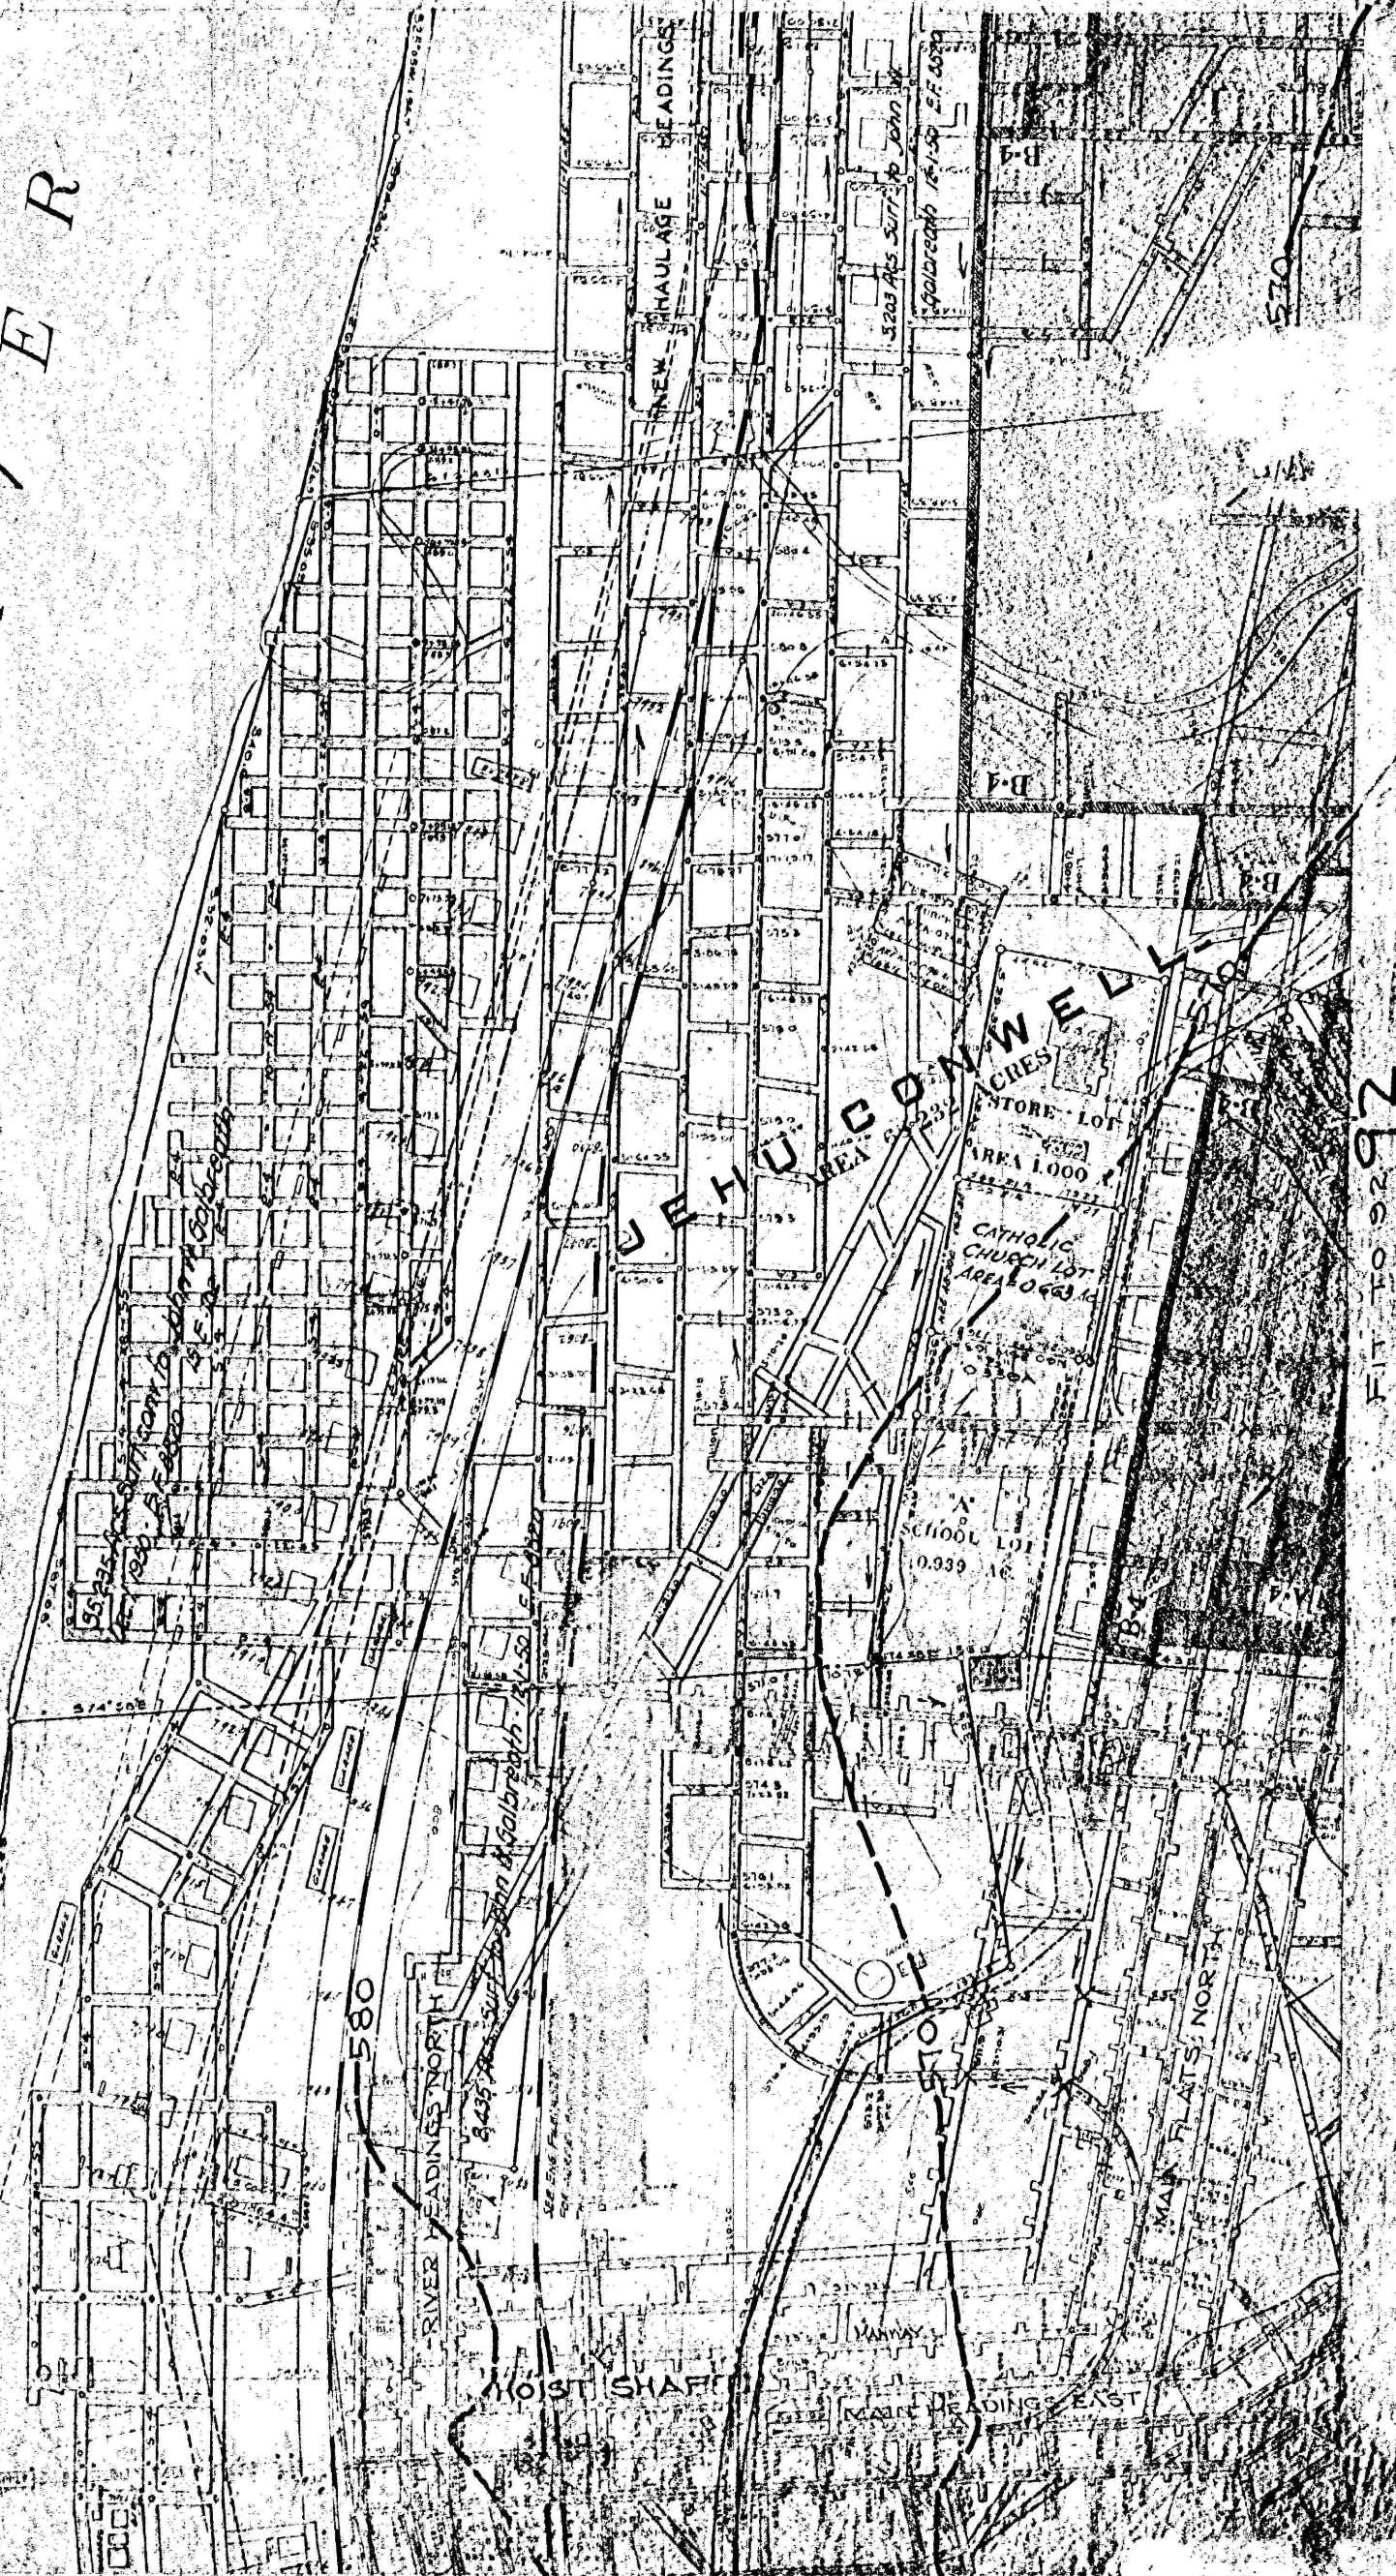

Sheet 104