


Fit to 101 101

PALMER 97
FILBERT 98

96 FIT TO 96

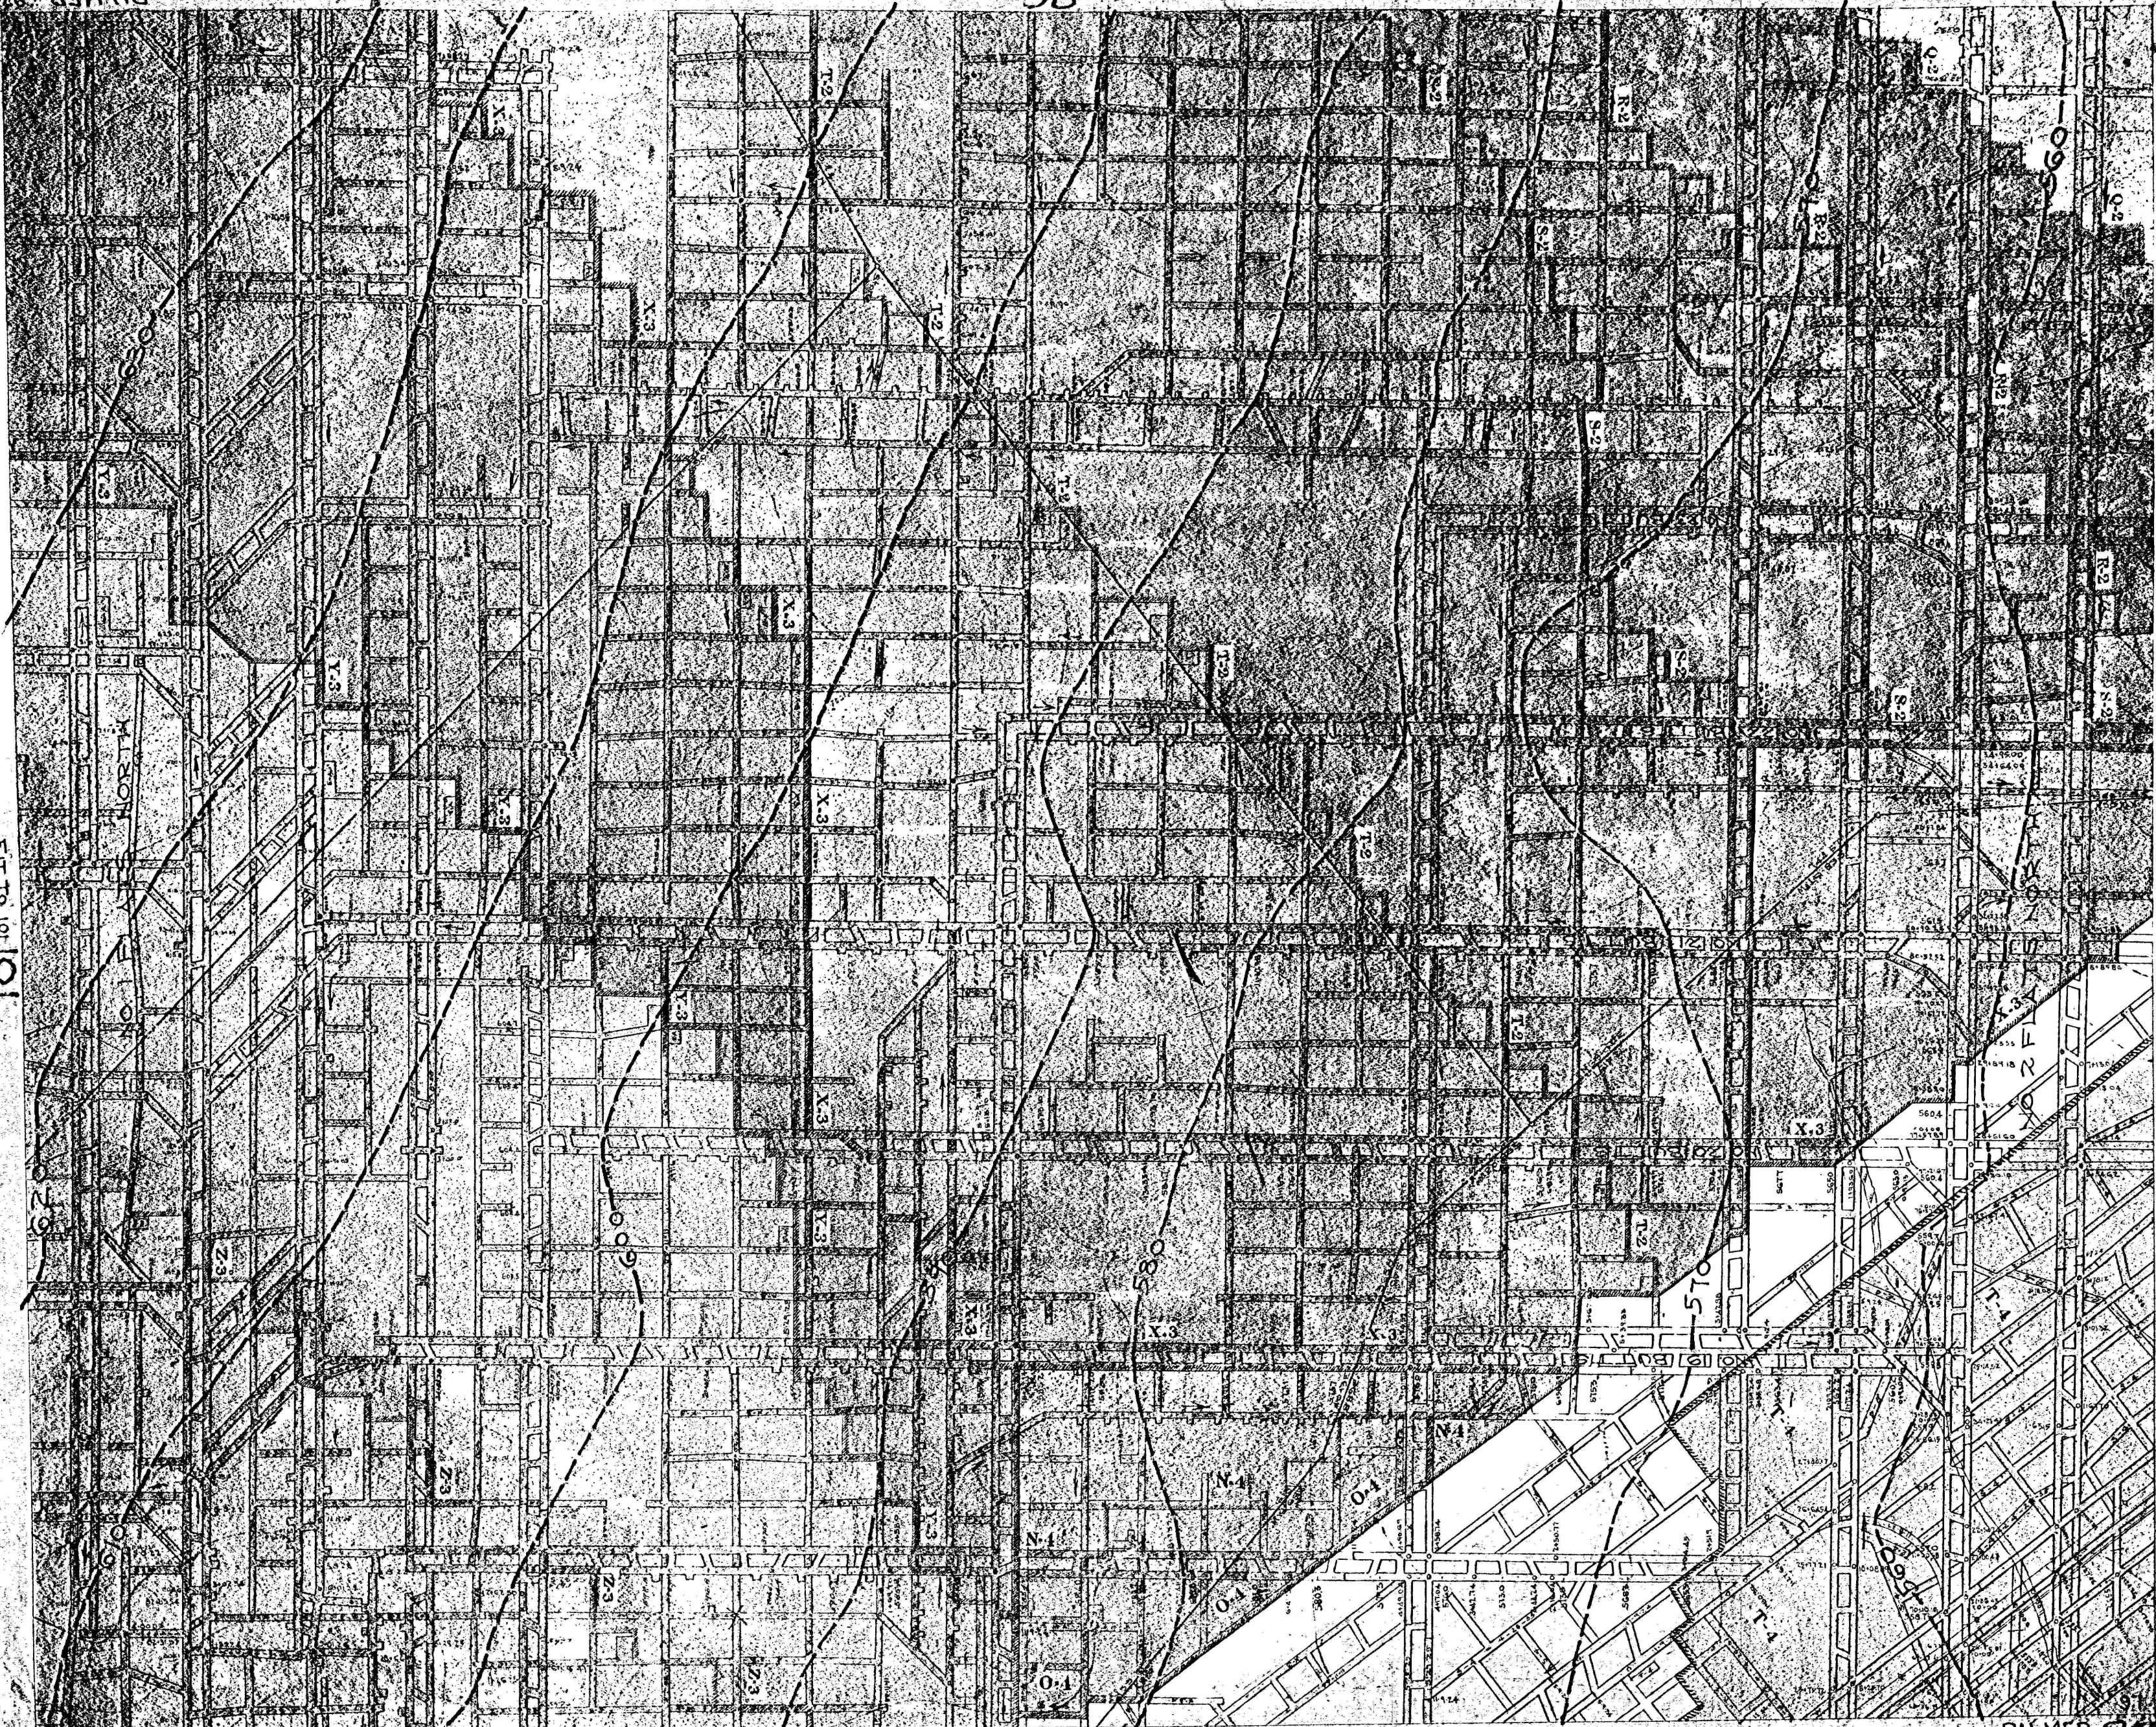

Fit to 98 98

PALMER 97
FILBERT 98

98 FIT TO 98