


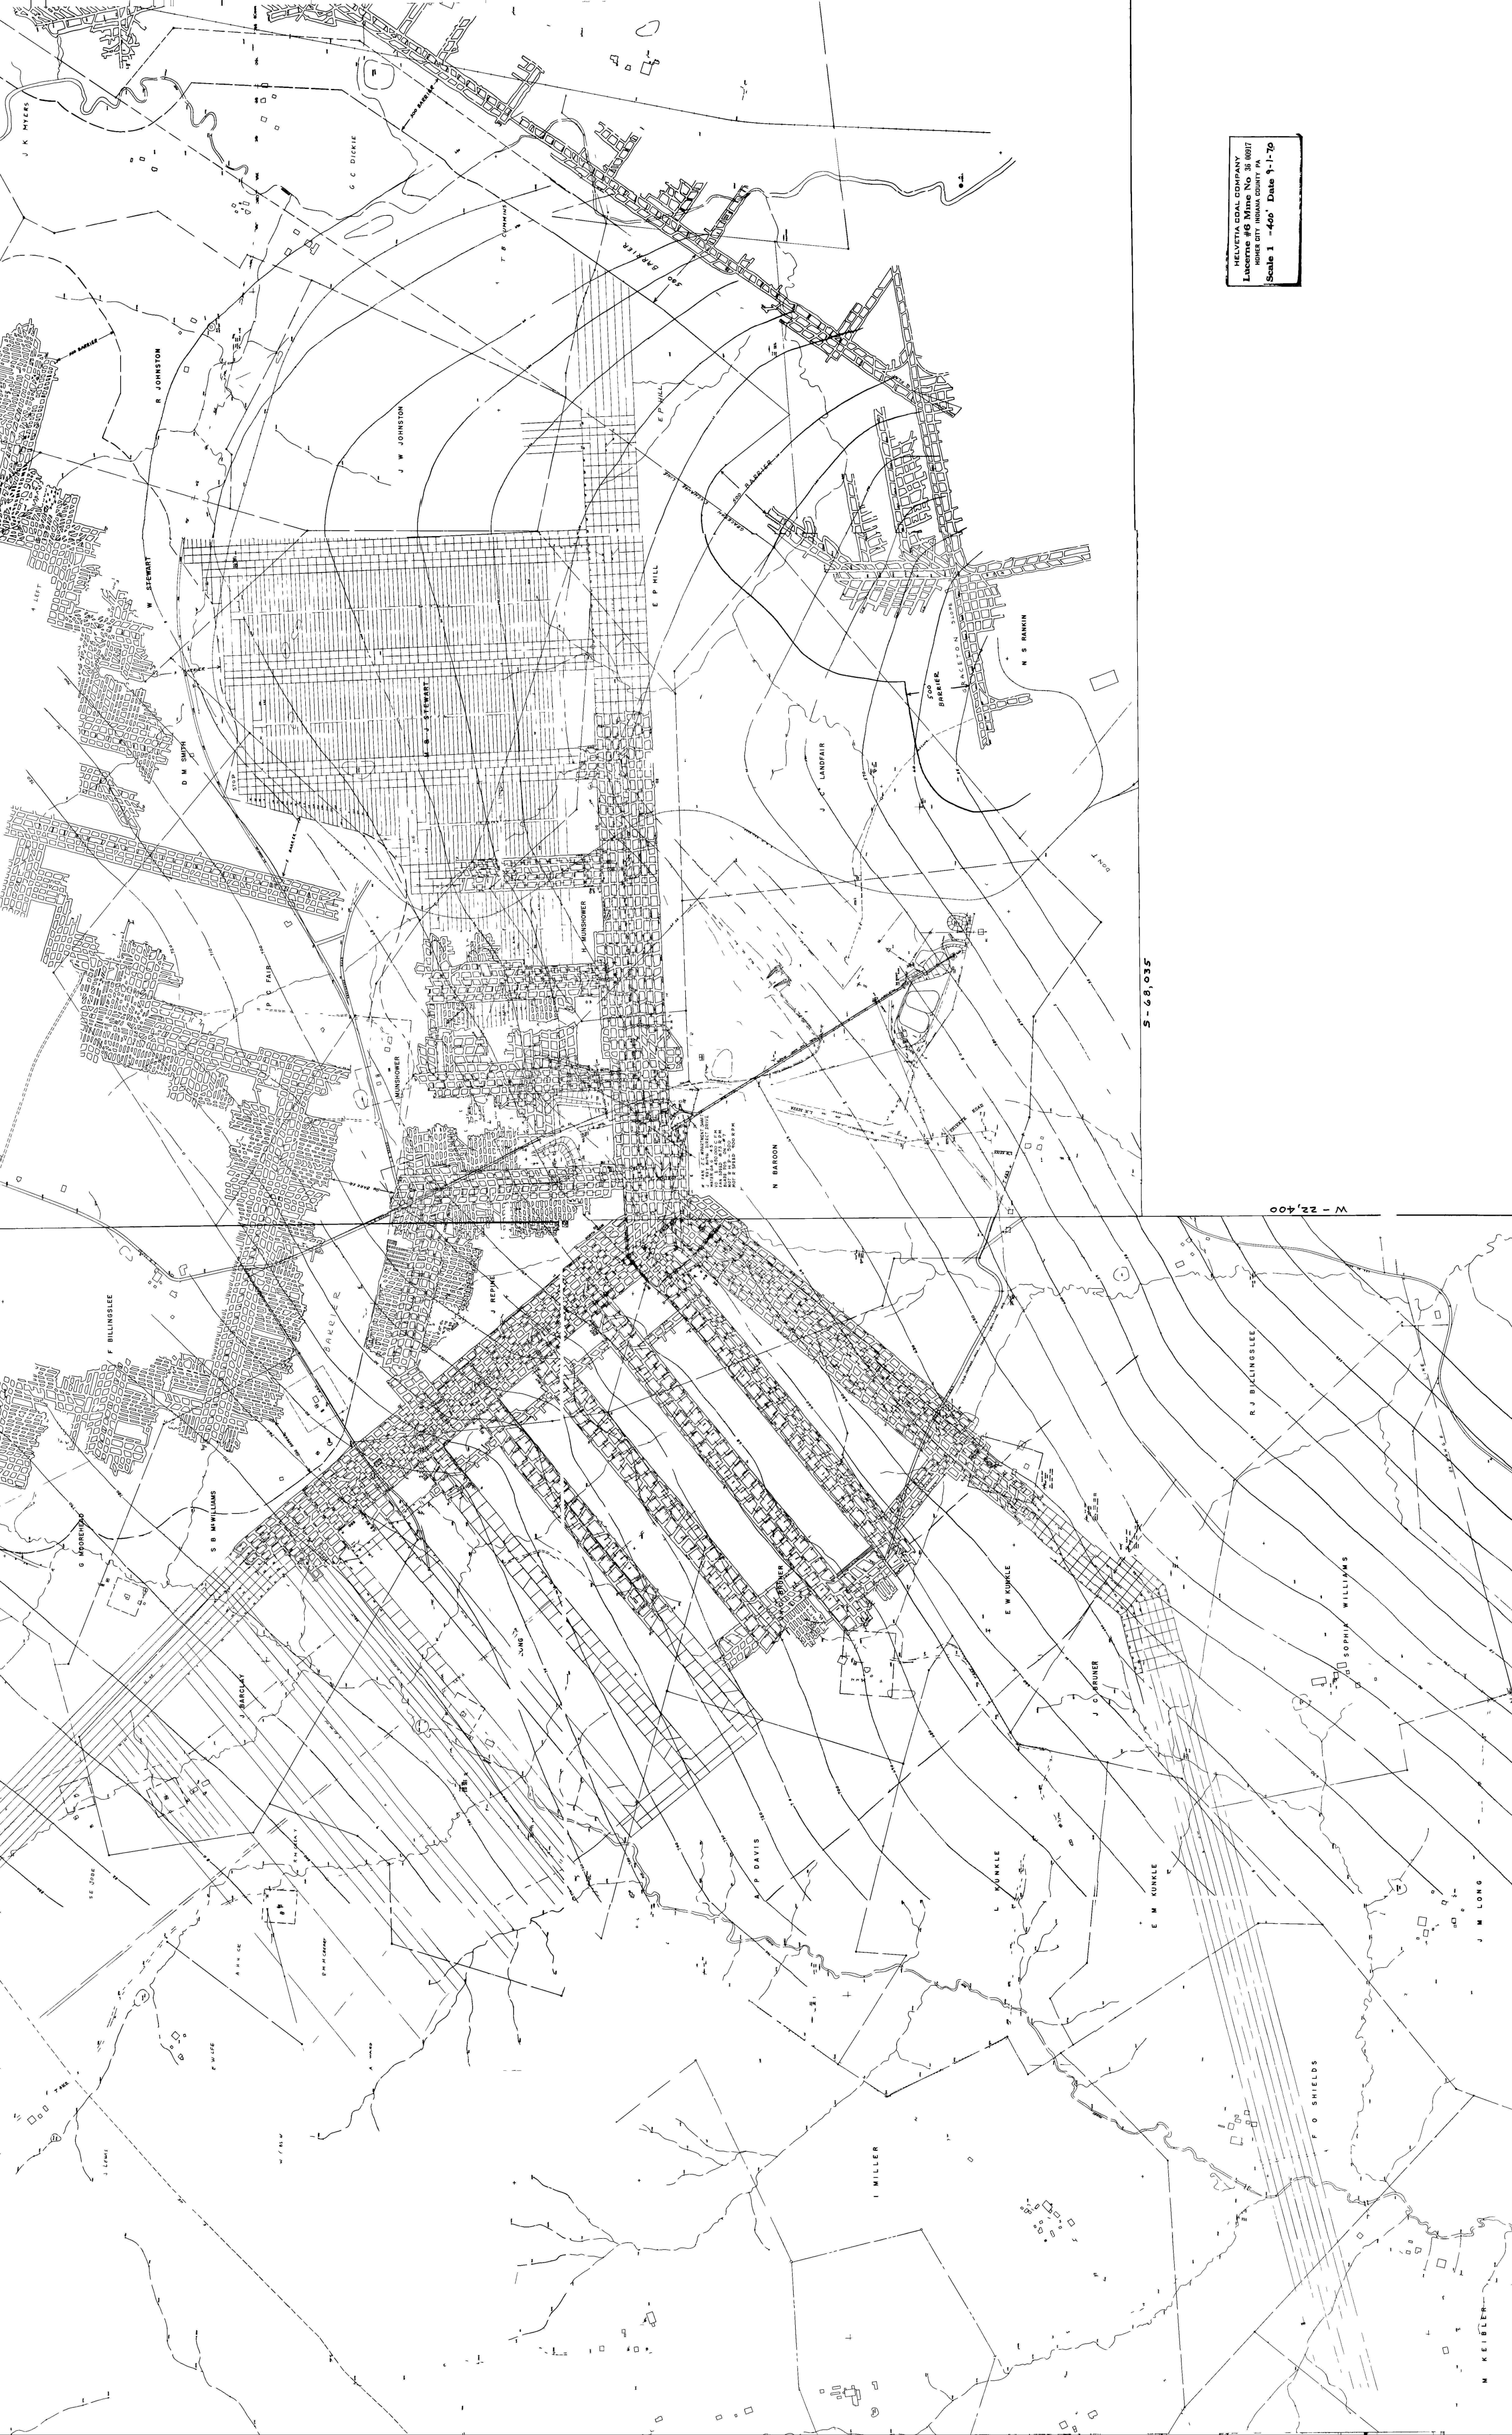

HELVETIA COAL COMPANY
Lucerne #6 Mine No. 35, 0017
HOMER CITY INDIANA COUNTY PA.
Scale 1 - 400' Date 1-1-70

W - 22,400

S - 68,035