


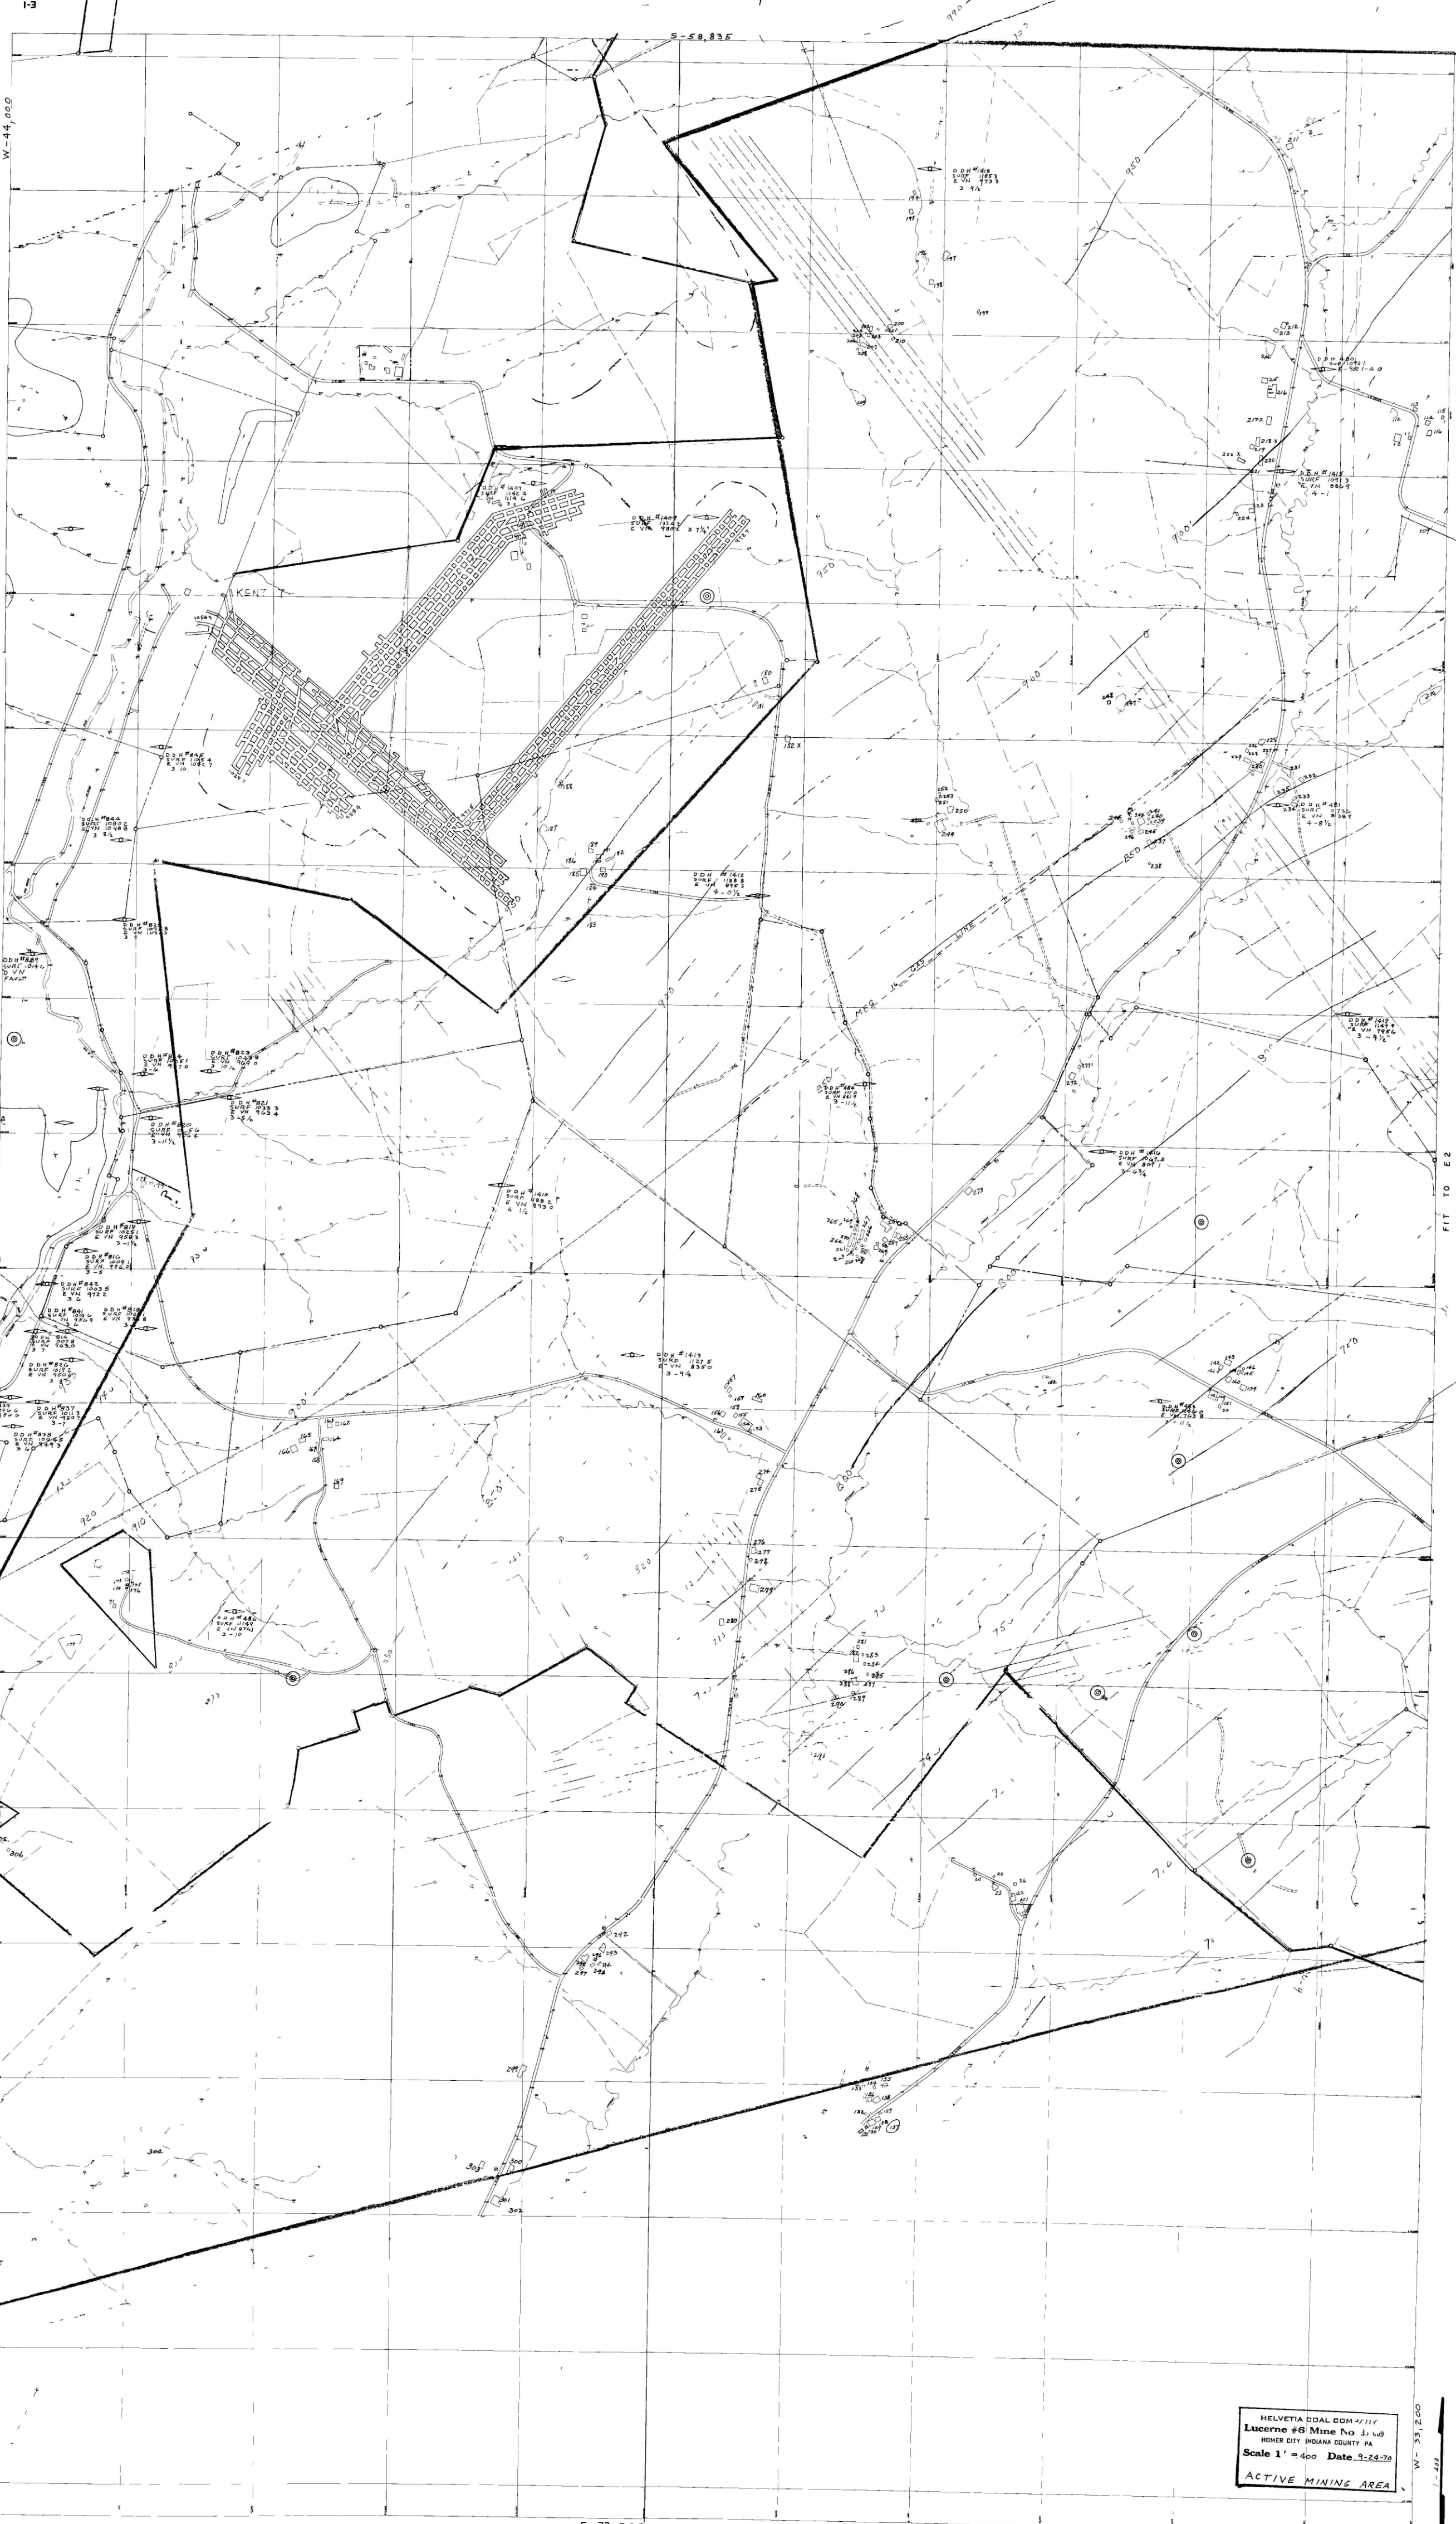

HELVETIA COAL COMPANY
Lucerne #6 Mine No. 31, 409
HOMER CITY INDIANA COUNTY, PA.
Scale 1" = 400' Date 9-24-70
ACTIVE MINING AREA

FIT TO E2

W-33,200
1-44

S-77, 235

E-1-1464