#406
6-17-99
C.C.

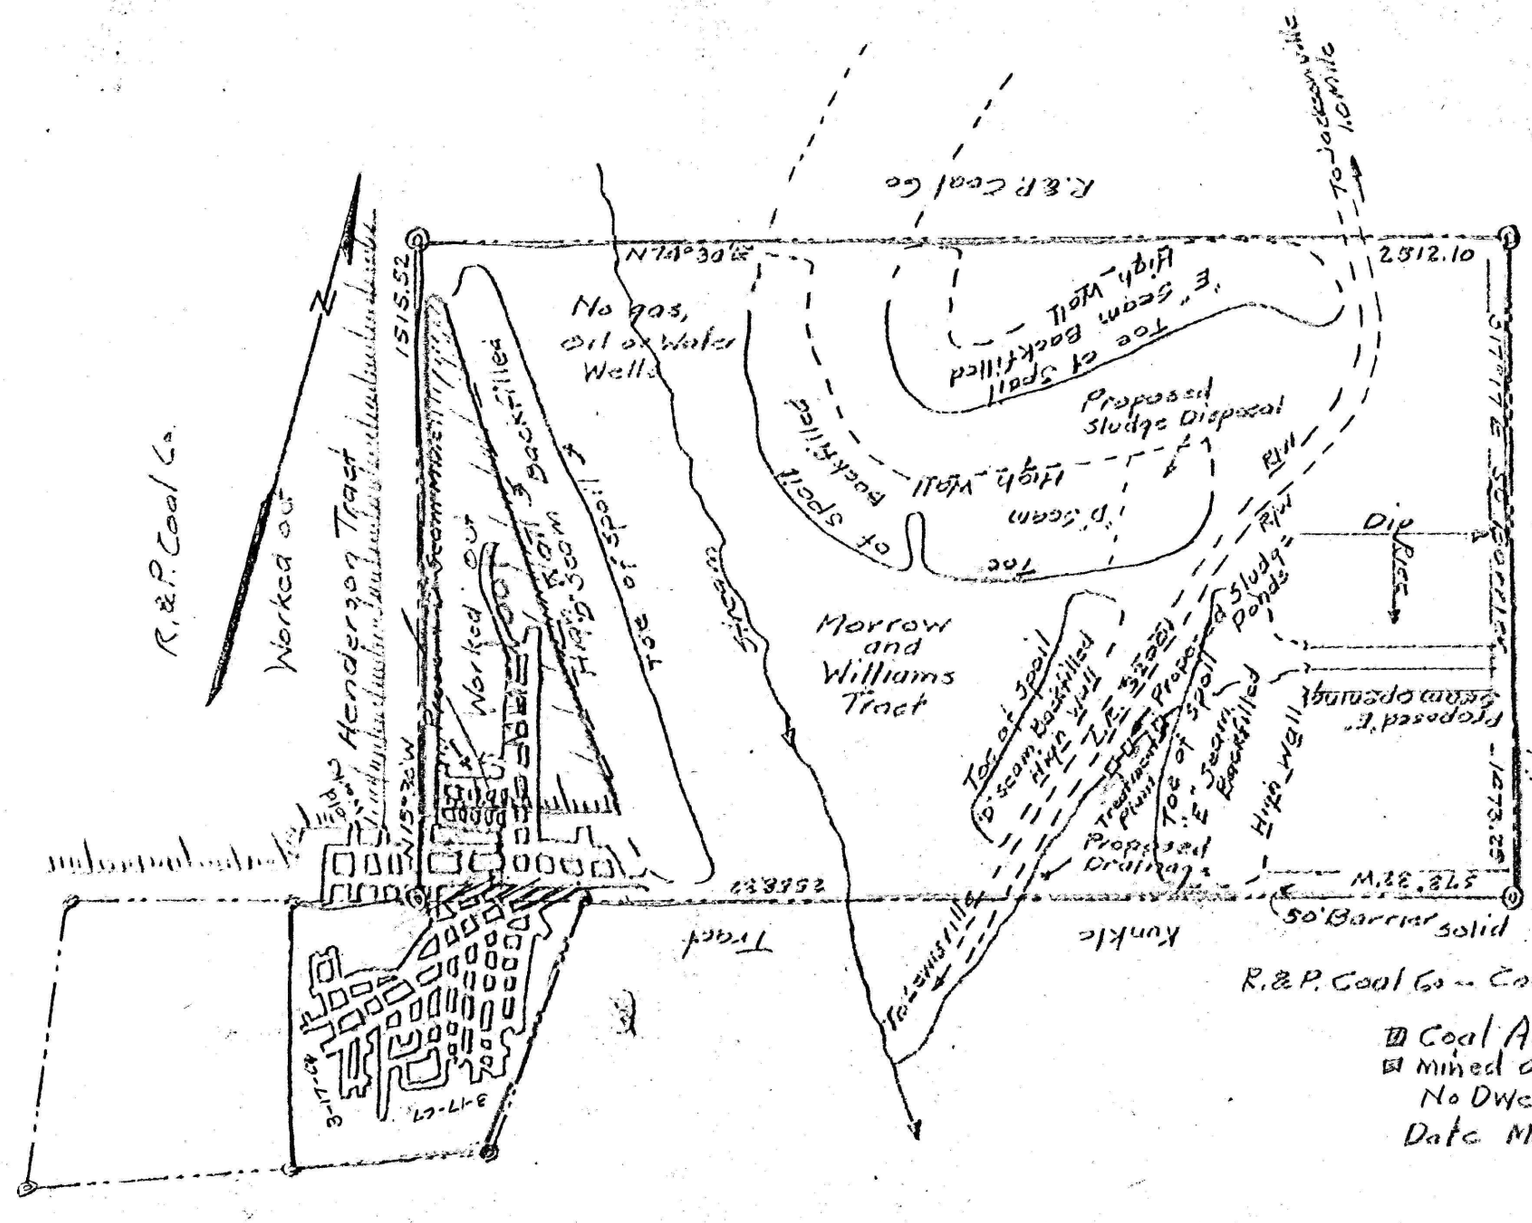

Property Plan
C.&C. Coal Company, Pa.
Young Twp. Indiana Co., Pa.
Scale: No. 400 Apr. 28, 1964
Grant Engineering Co.
Blairsville Pa.

Coal Area
Mined out - Mining Completed
No Dwellings
Date Mar. 27, 1967