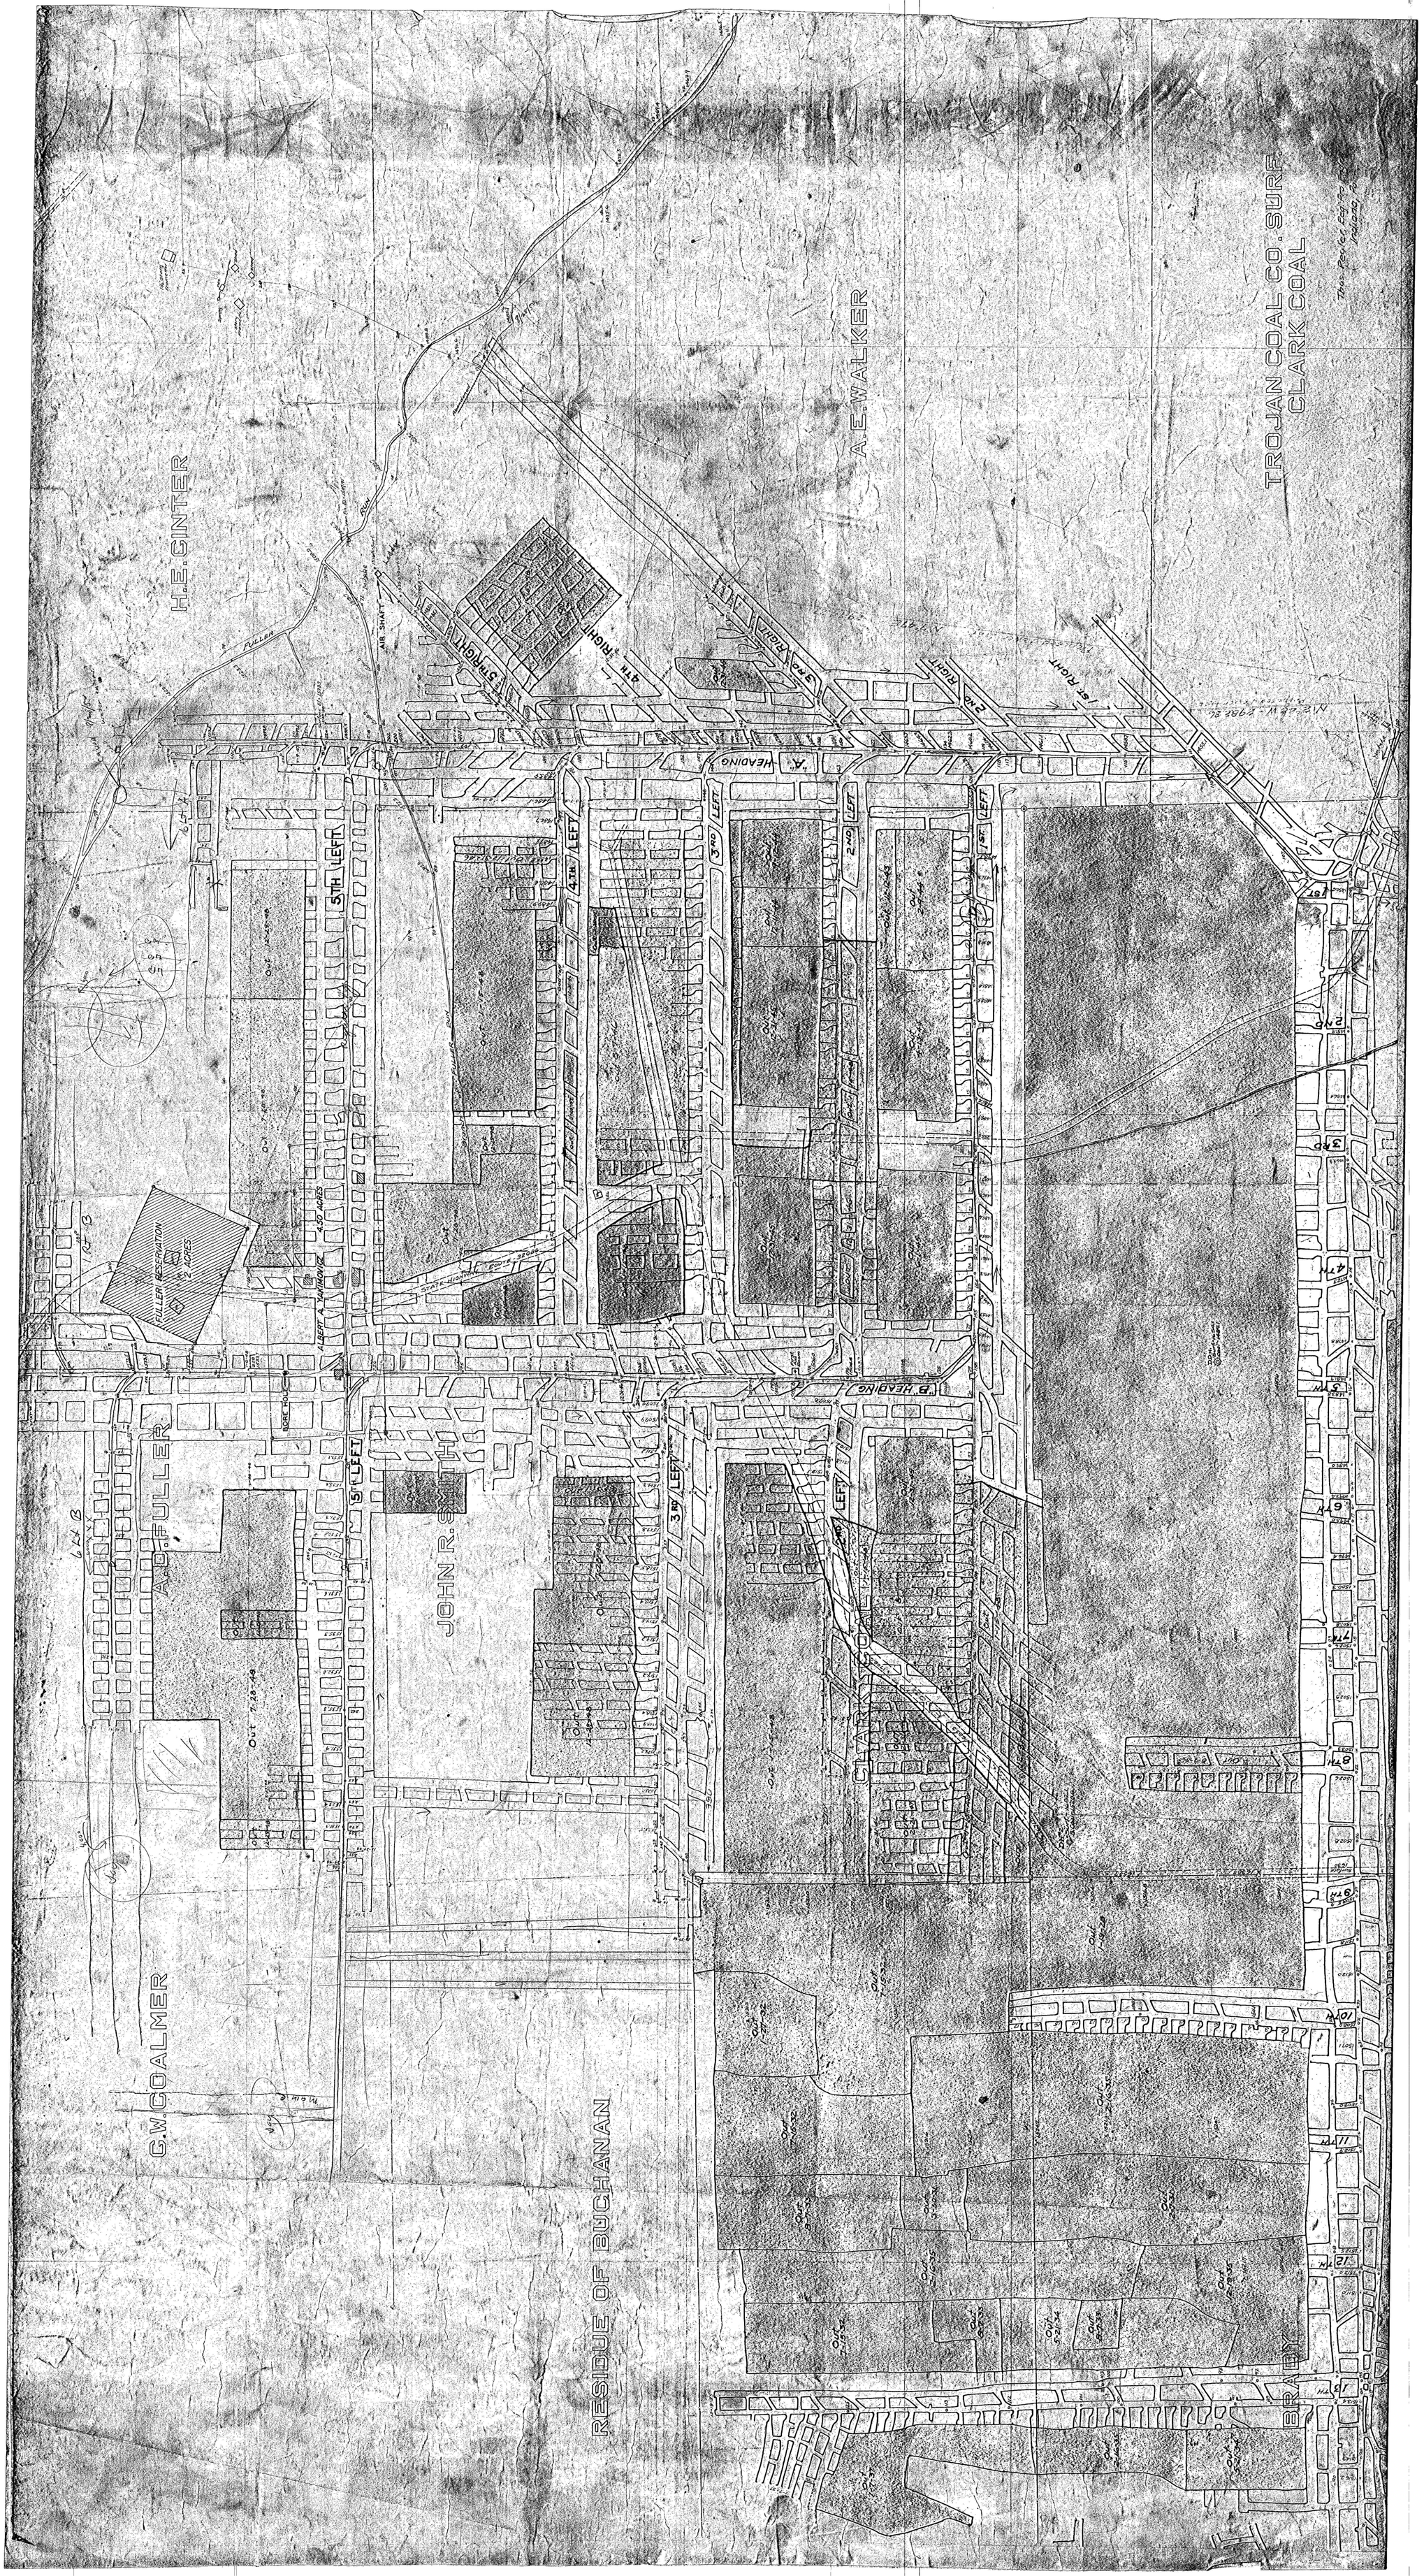

TROJAN COAL CO. SURF.
CLARK COAL
Thos. Pealer Reg. Pro. Eng.
Indiana, Pa.
H.E.GINTER
A.E.WALKER
A.D.FULLER
JOHN R. SMITH
G.W.COALMER
RESIDUE OF BUCHANAN
CLARK
BRADY
FULLER RESERVATION 2 ACRES
ALBERT A. YAKIMOVICZ 4.50 ACRES
FULLER RUN
AIR SHAFT
Abandoned
STATE HIGHWAY ROUTE 32086
BORE HOLE
'A' HEADING
'B' HEADING
5TH RIGHT
4TH RIGHT
3RD RIGHT
2ND RIGHT
1ST RIGHT
5TH LEFT
4TH LEFT
3RD LEFT
2ND LEFT
1ST LEFT
5TH LEFT
3RD LEFT
2ND LEFT
1ST
2ND
3RD
4TH
5TH
6TH
7TH
8TH
9TH
10TH
11TH
12TH
13TH
6 Lt B
1 Rt B
Out 12-28-48
Out 7-28-48
Out 1-15-48
Out 8-7-46
Out 12-31-45
Out 7-28-48
Out 1-19-28
Out 7-15-32
Out 1-21-32
Out 7-16-32
Out 2-16-35
Out 8-7-33
Out 2-7-34
Out 12-19-35
Out 5-21-34
Out 7-15-32
Out 5-27-34
Out 1-7-31
N 2° 46' W 2988.36