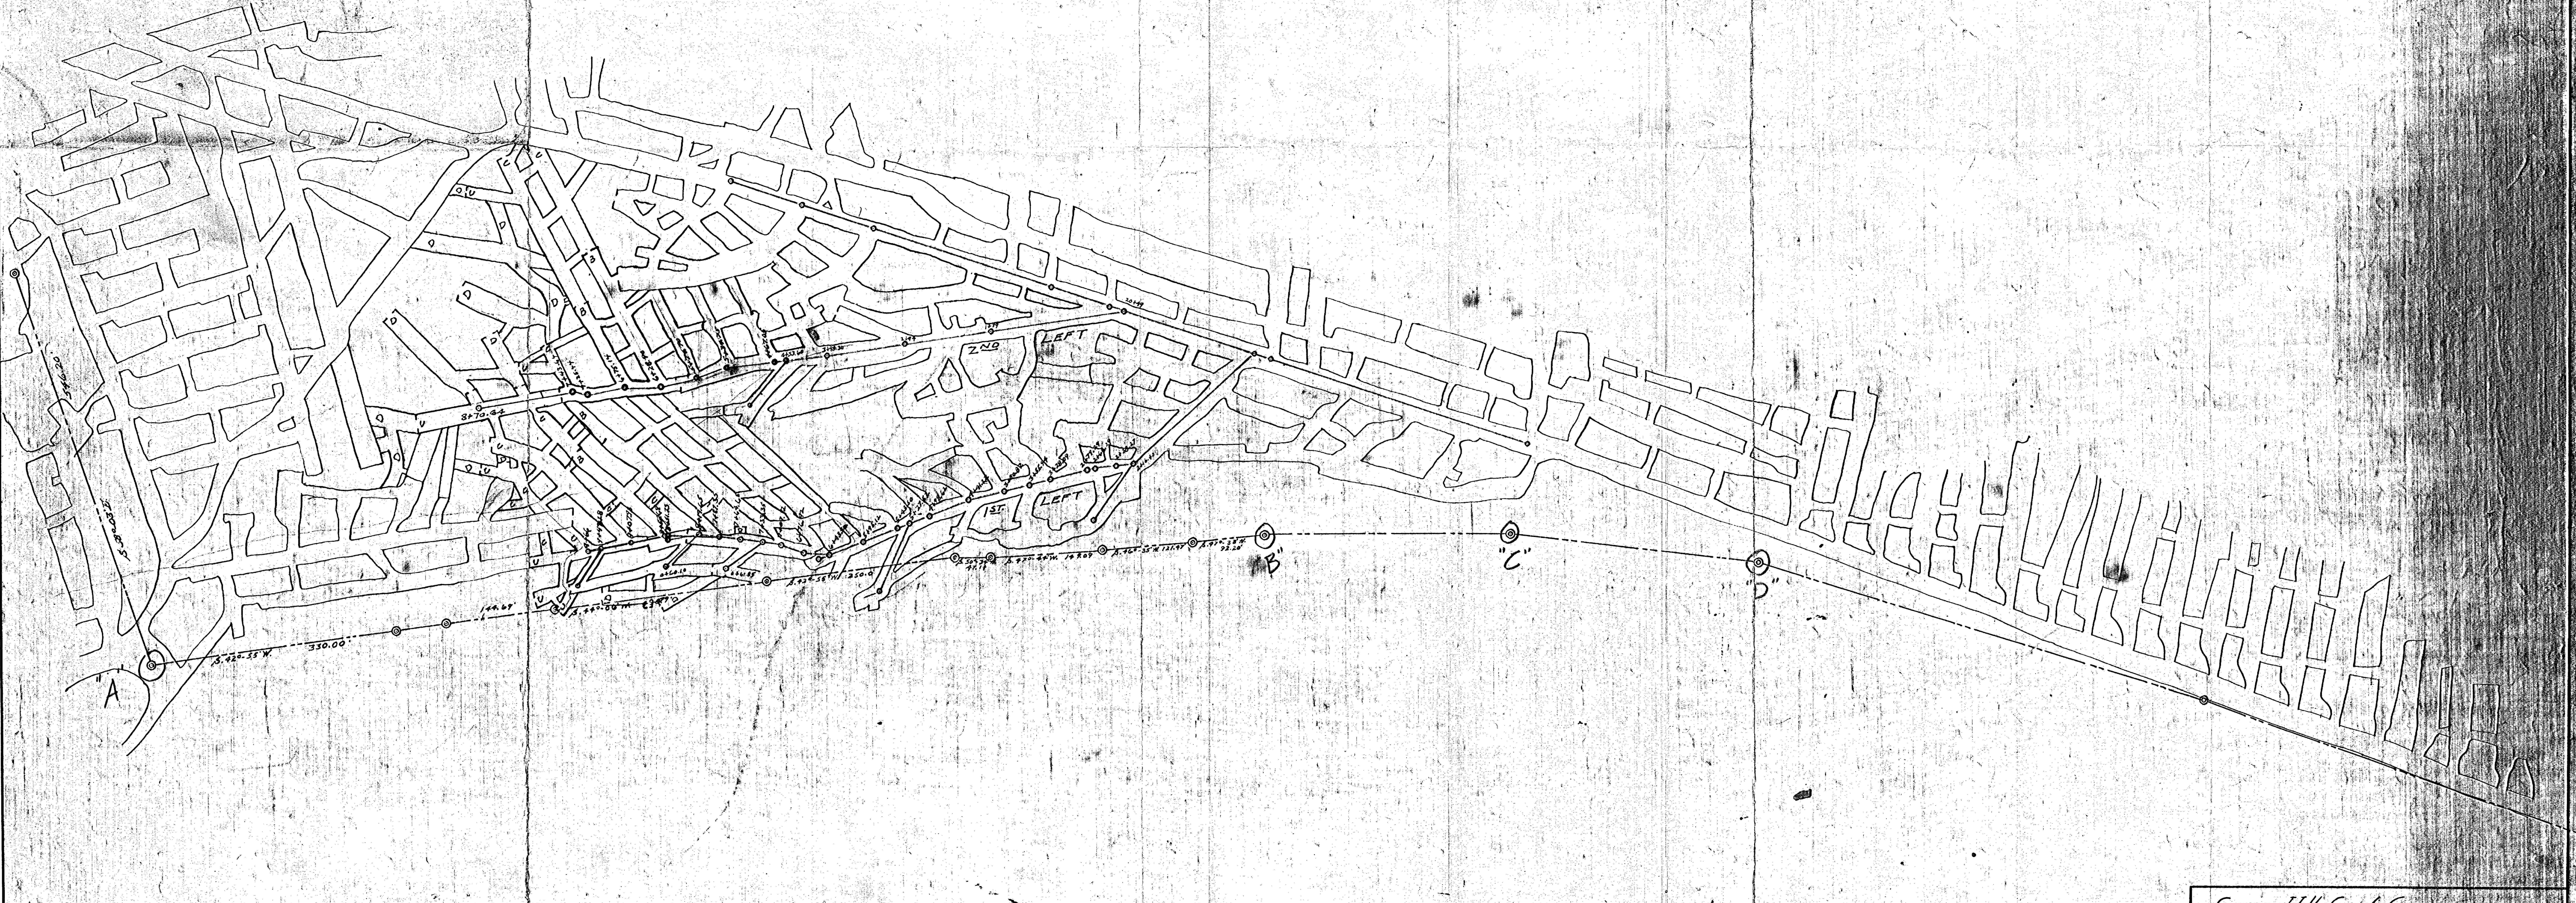

Cal
Fit "A" "B" "C" & "D" on each other.
The small map is up to 1944, the
large map is only up to 1913.
T.L.L.

Green Hill Coal Company

Letter	Date of Survey	Surveyed By	Plotted By
A.	Oct. 31. 1940 Nov. 1. 1940	M. Moore	M. Moore
B	Oct 1941	M. Moore	M. Moore
C	Nov. 10, 1943	F. L. Locher	F. L. Locher
D	Dec. 12, 1944	" "	" "

Note Book No.	Comp. Book No.	Scale 1"=100'
E. R. Owen Engineer Johnstown Pa.		Plan No. F4