


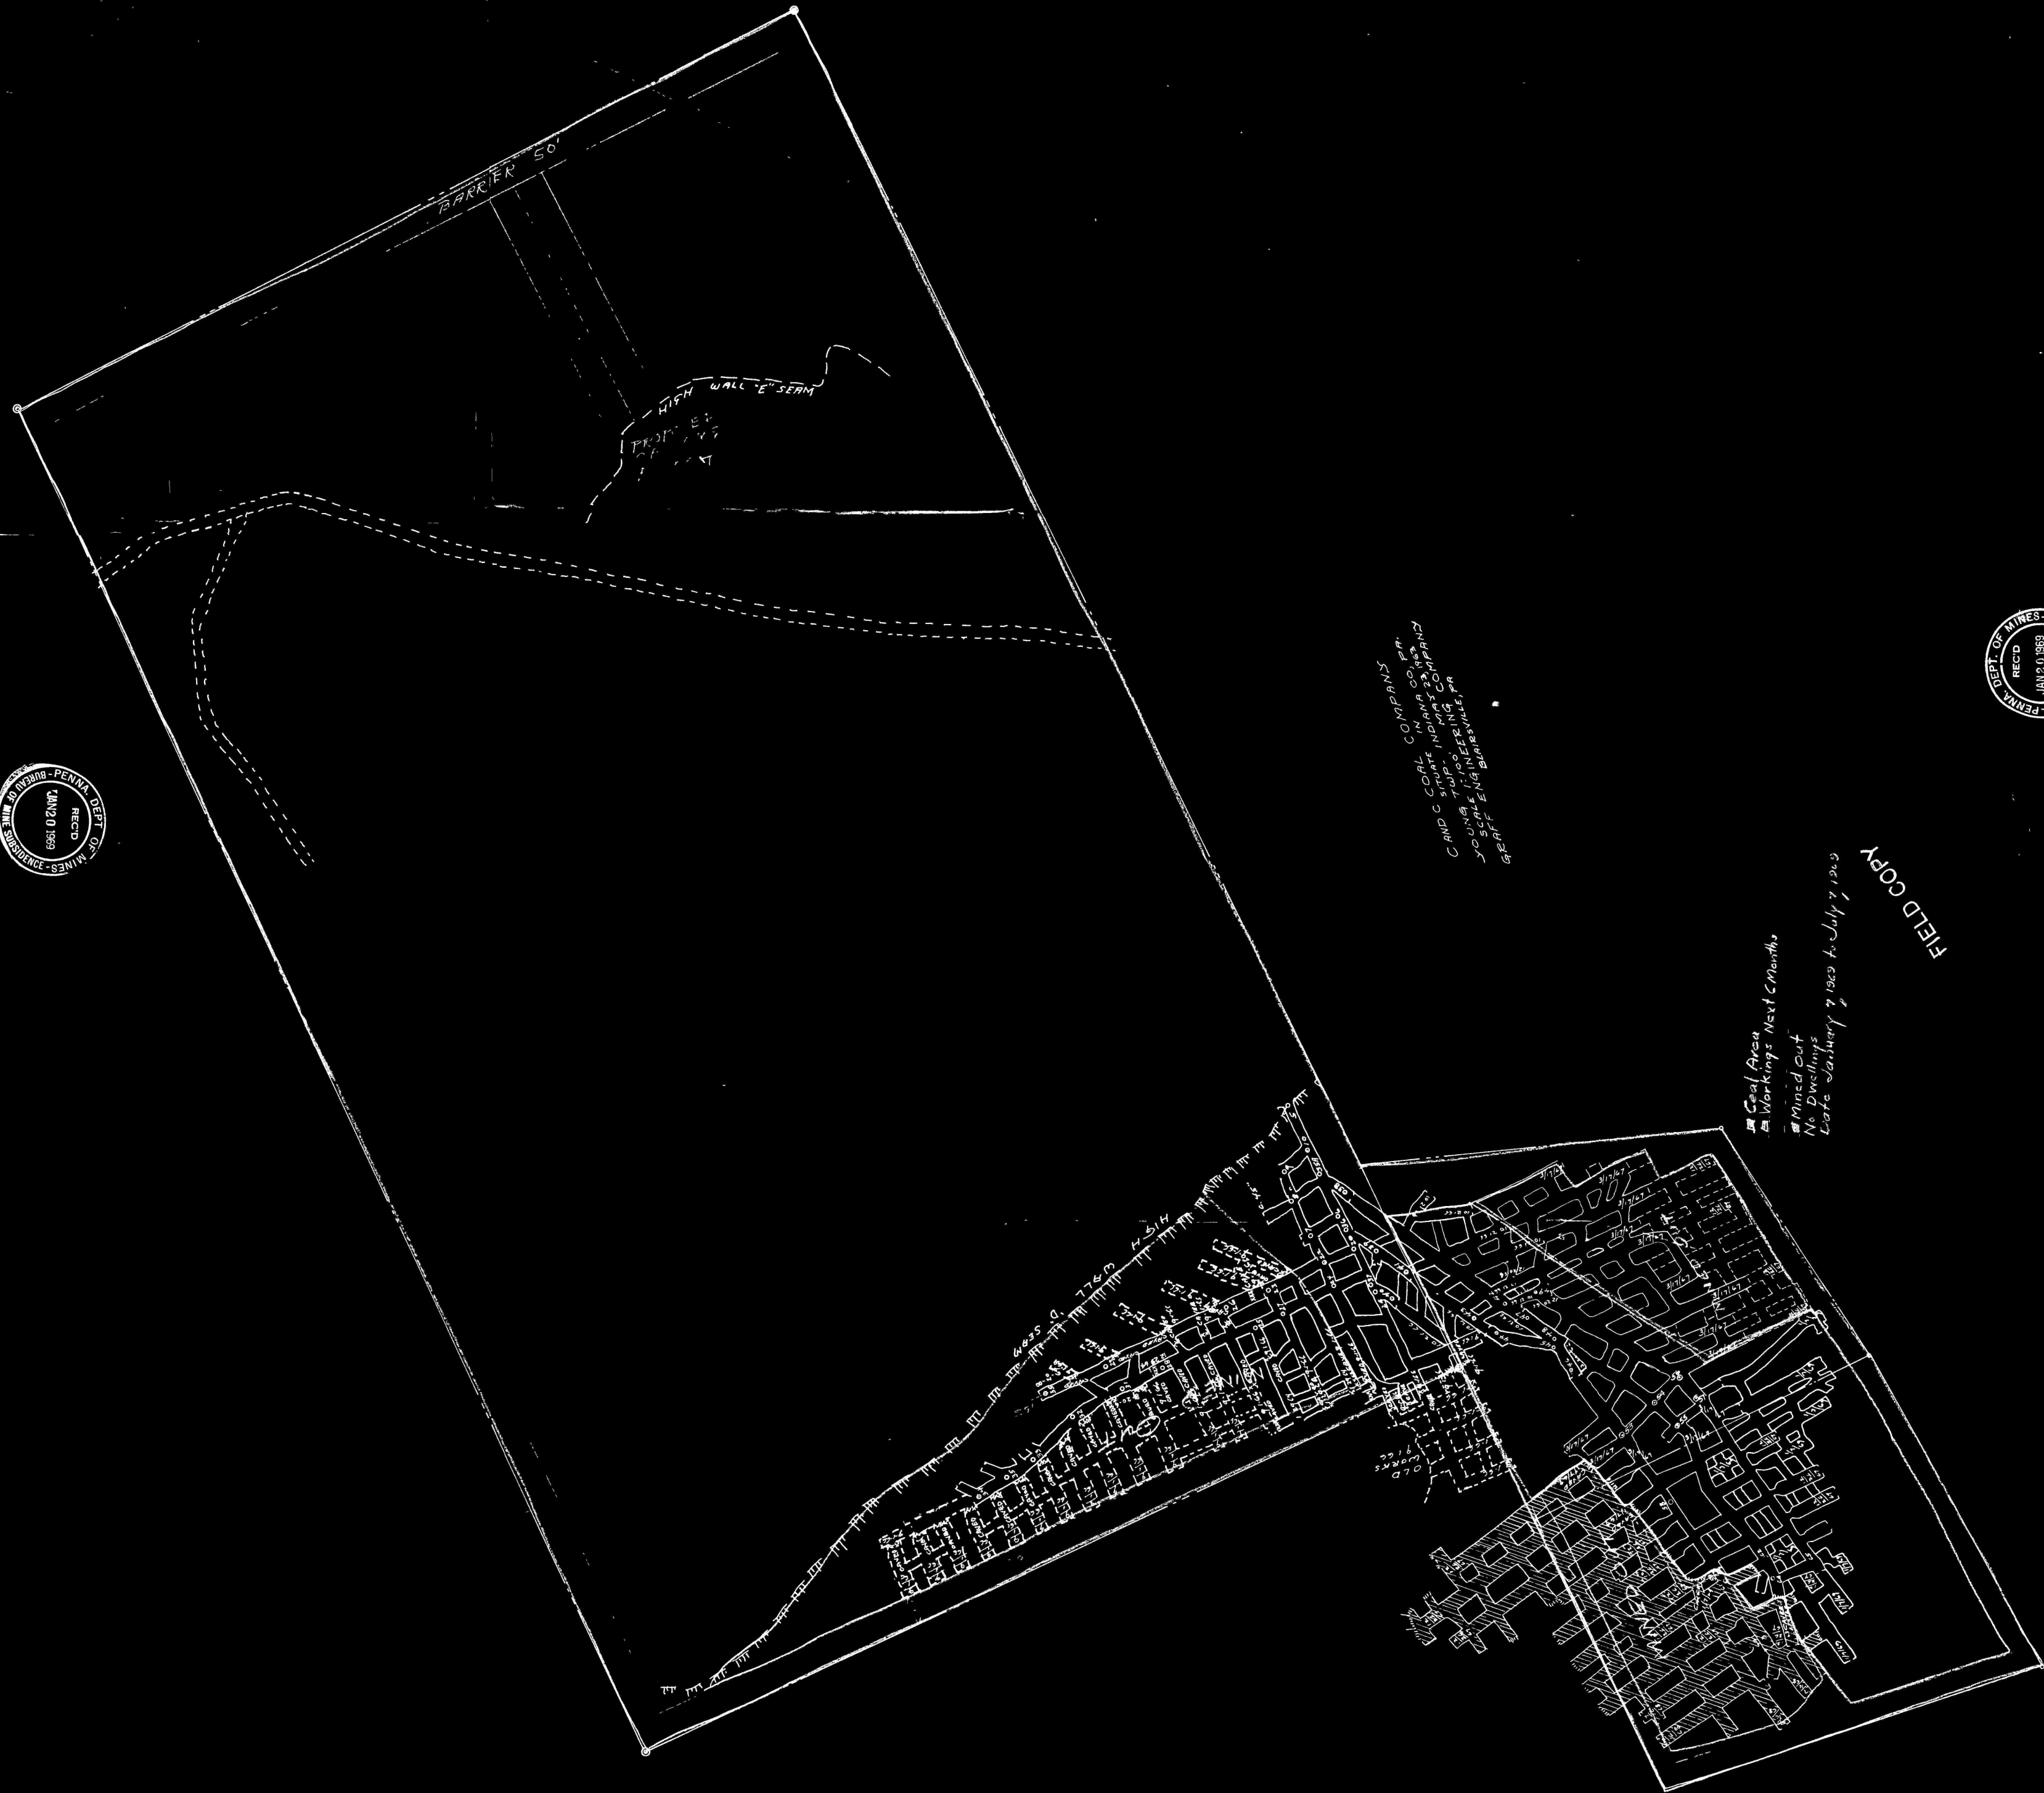

C AND C COAL MINING CO. PA.

Seaf Area
Workings Next 6 Months
Mined Out
No Dwellings
Late January 1969 to July 1969

FIELD COPY

