


STATE PARK LAND

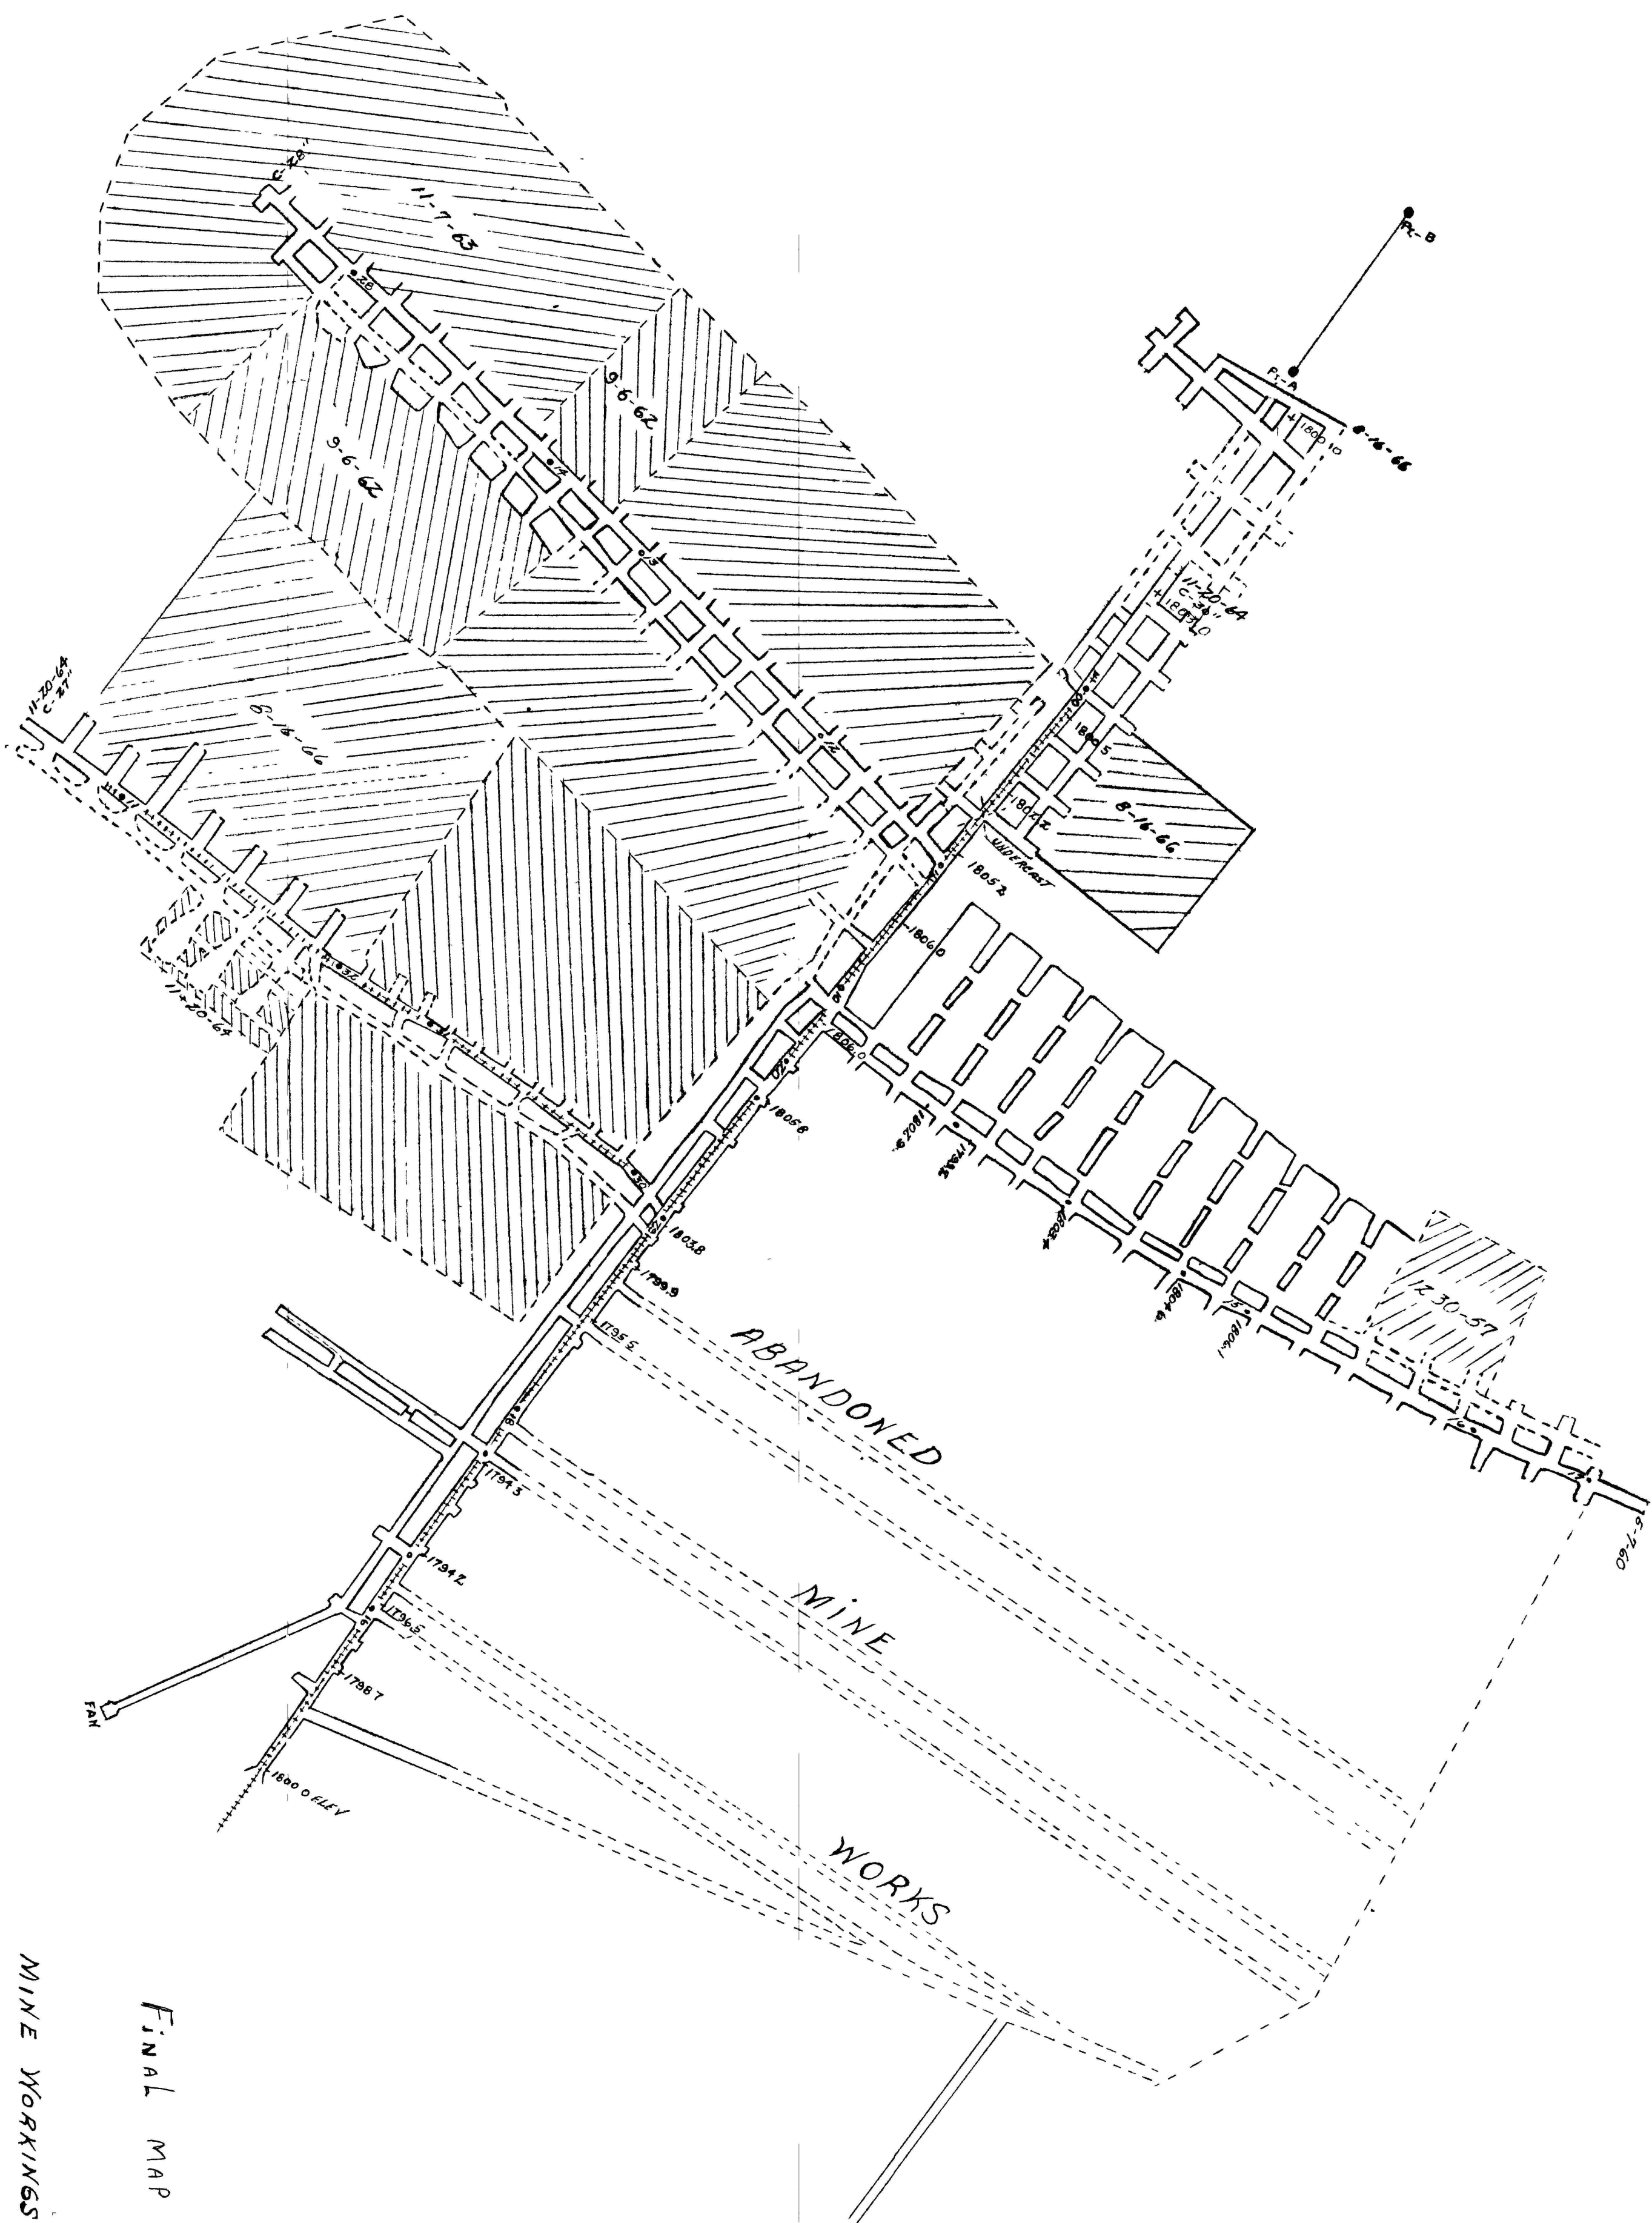

# Final Map of C & C Coal Co.

MINE WORKINGS OF C. AND C. COAL CO.

COLONIAL #7 NINE

WHITE TWP. - CAMBRIDG COUNTY

SCALE - 1" = 100' MAP REVISED 7-8-66

SEAL