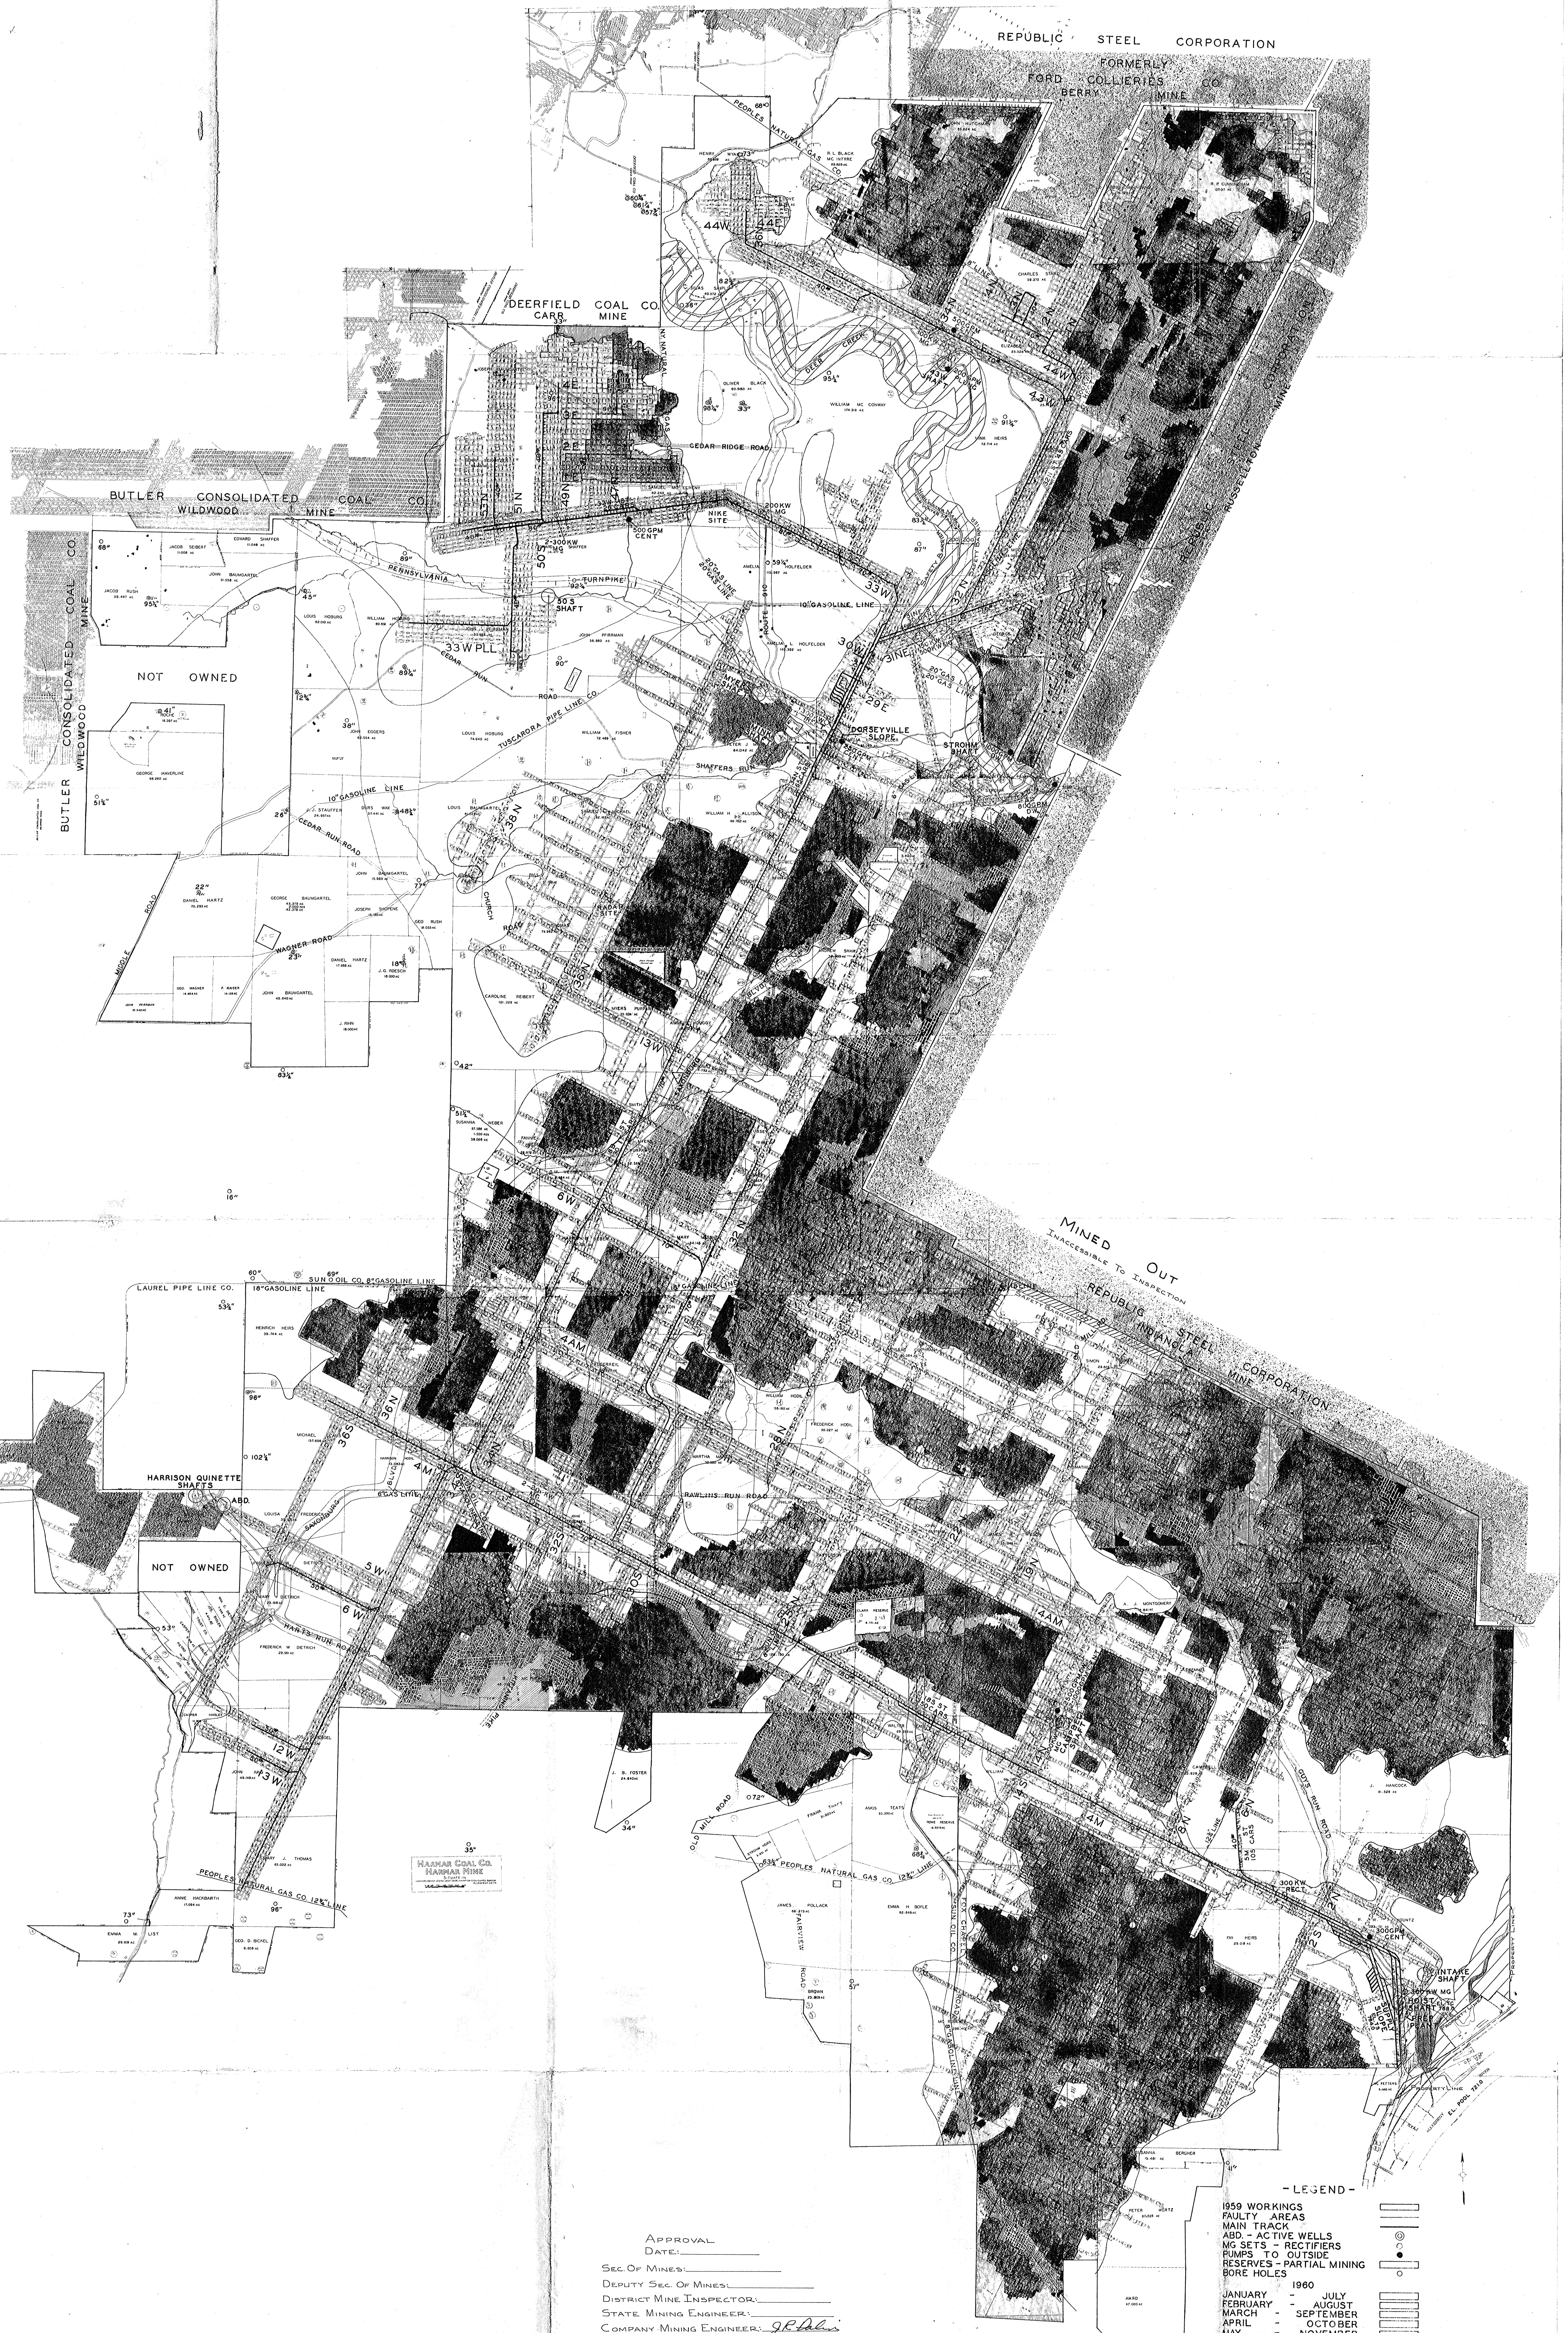
REPUBLIC STEEL CORPORATION
FORMERLY
FORD COLLIERIES CO.
BERRY MINE
DEERFIELD COAL CO
CARR MINE
BUTLER CONSOLIDATED COAL CO
WILDWOOD MINE
BUTLER CONSOLIDATED COAL CO.
WILDWOOD MINE
NOT OWNED
PENNSYLVANIA TURNPIKE
CEDAR RIDGE ROAD
NIKE SITE
30 S SHAFT
33 W PLL
10"GASOLINE LINE
TUSCARORA PIPE LINE CO.
CEDAR RUN ROAD
WAGNER ROAD
FORSEYVILLE SLOPE
STROHM SHAFT
SHAFFERS RUN
MINED OUT
INACCESSIBLE TO INSPECTION
REPUBLIC STEEL CORPORATION
INDIANOLA MINE
LAUREL PIPE LINE CO.
18"GASOLINE LINE
SUN OIL CO. 8"GASOLINE LINE
HARRISON QUINETTE SHAFTS
NOT OWNED
RAWLINS RUN ROAD
HARMAR COAL CO.
HARMAR MINE
PEOPLES NATURAL GAS CO. 12" LINE
OLD MILL ROAD
INTAKE SHAFT
PROPERTY LINE
ALLEGHENY RIVER
EL. POOL 721.0
- LEGEND -
1959 WORKINGS
FAULTY AREAS
MAIN TRACK
ABD. - ACTIVE WELLS
MG SETS - RECTIFIERS
PUMPS TO OUTSIDE
RESERVES - PARTIAL MINING
BORE HOLES
1960
JANUARY - JULY
FEBRUARY - AUGUST
MARCH - SEPTEMBER
APRIL - OCTOBER
MAY - NOVEMBER
JUNE - DECEMBER

Approval
Date:__________

Sec. Of Mines:__________

Deputy Sec. Of Mines:__________

District Mine Inspector:__________

State Mining Engineer:__________

Company Mining Engineer: J.R. Lalui

HARMAR MINE
1960

Legend

▨ — 200' Safety Zone

1" - 600'