


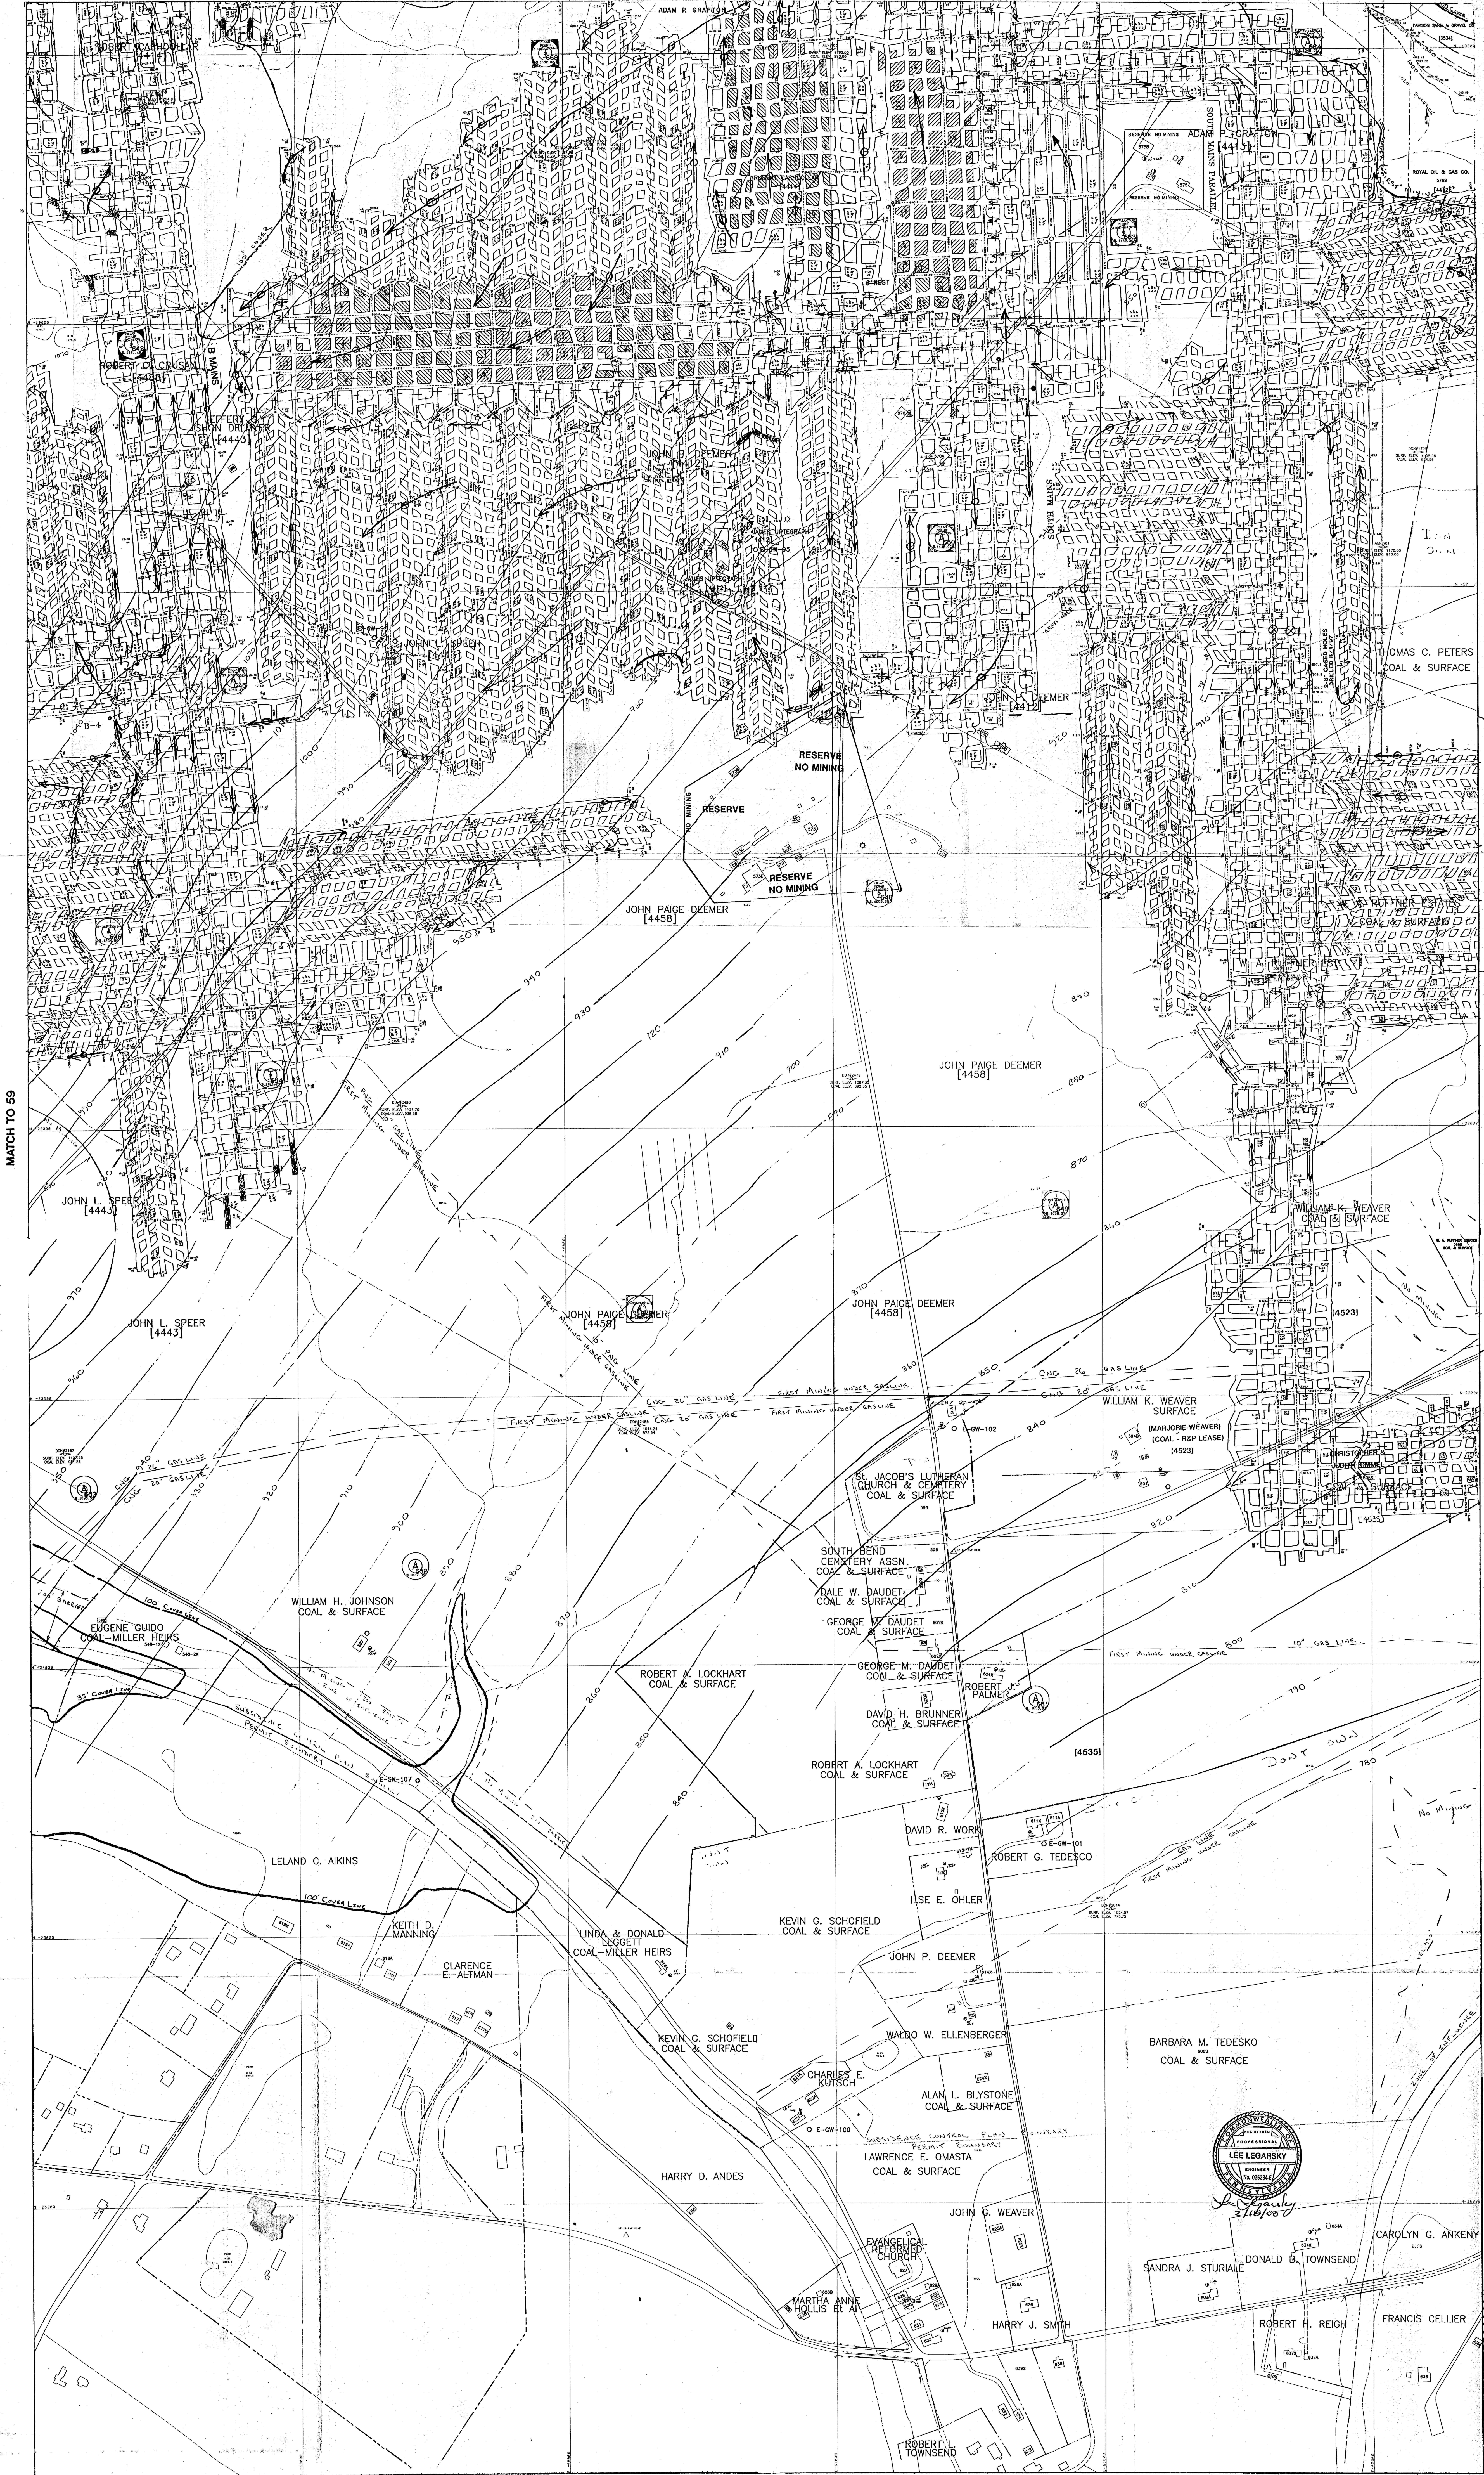

MATCH TO 59

MATCH TO 25

POSTING DATE 12-1-1979
PLUM CREEK MAP

