


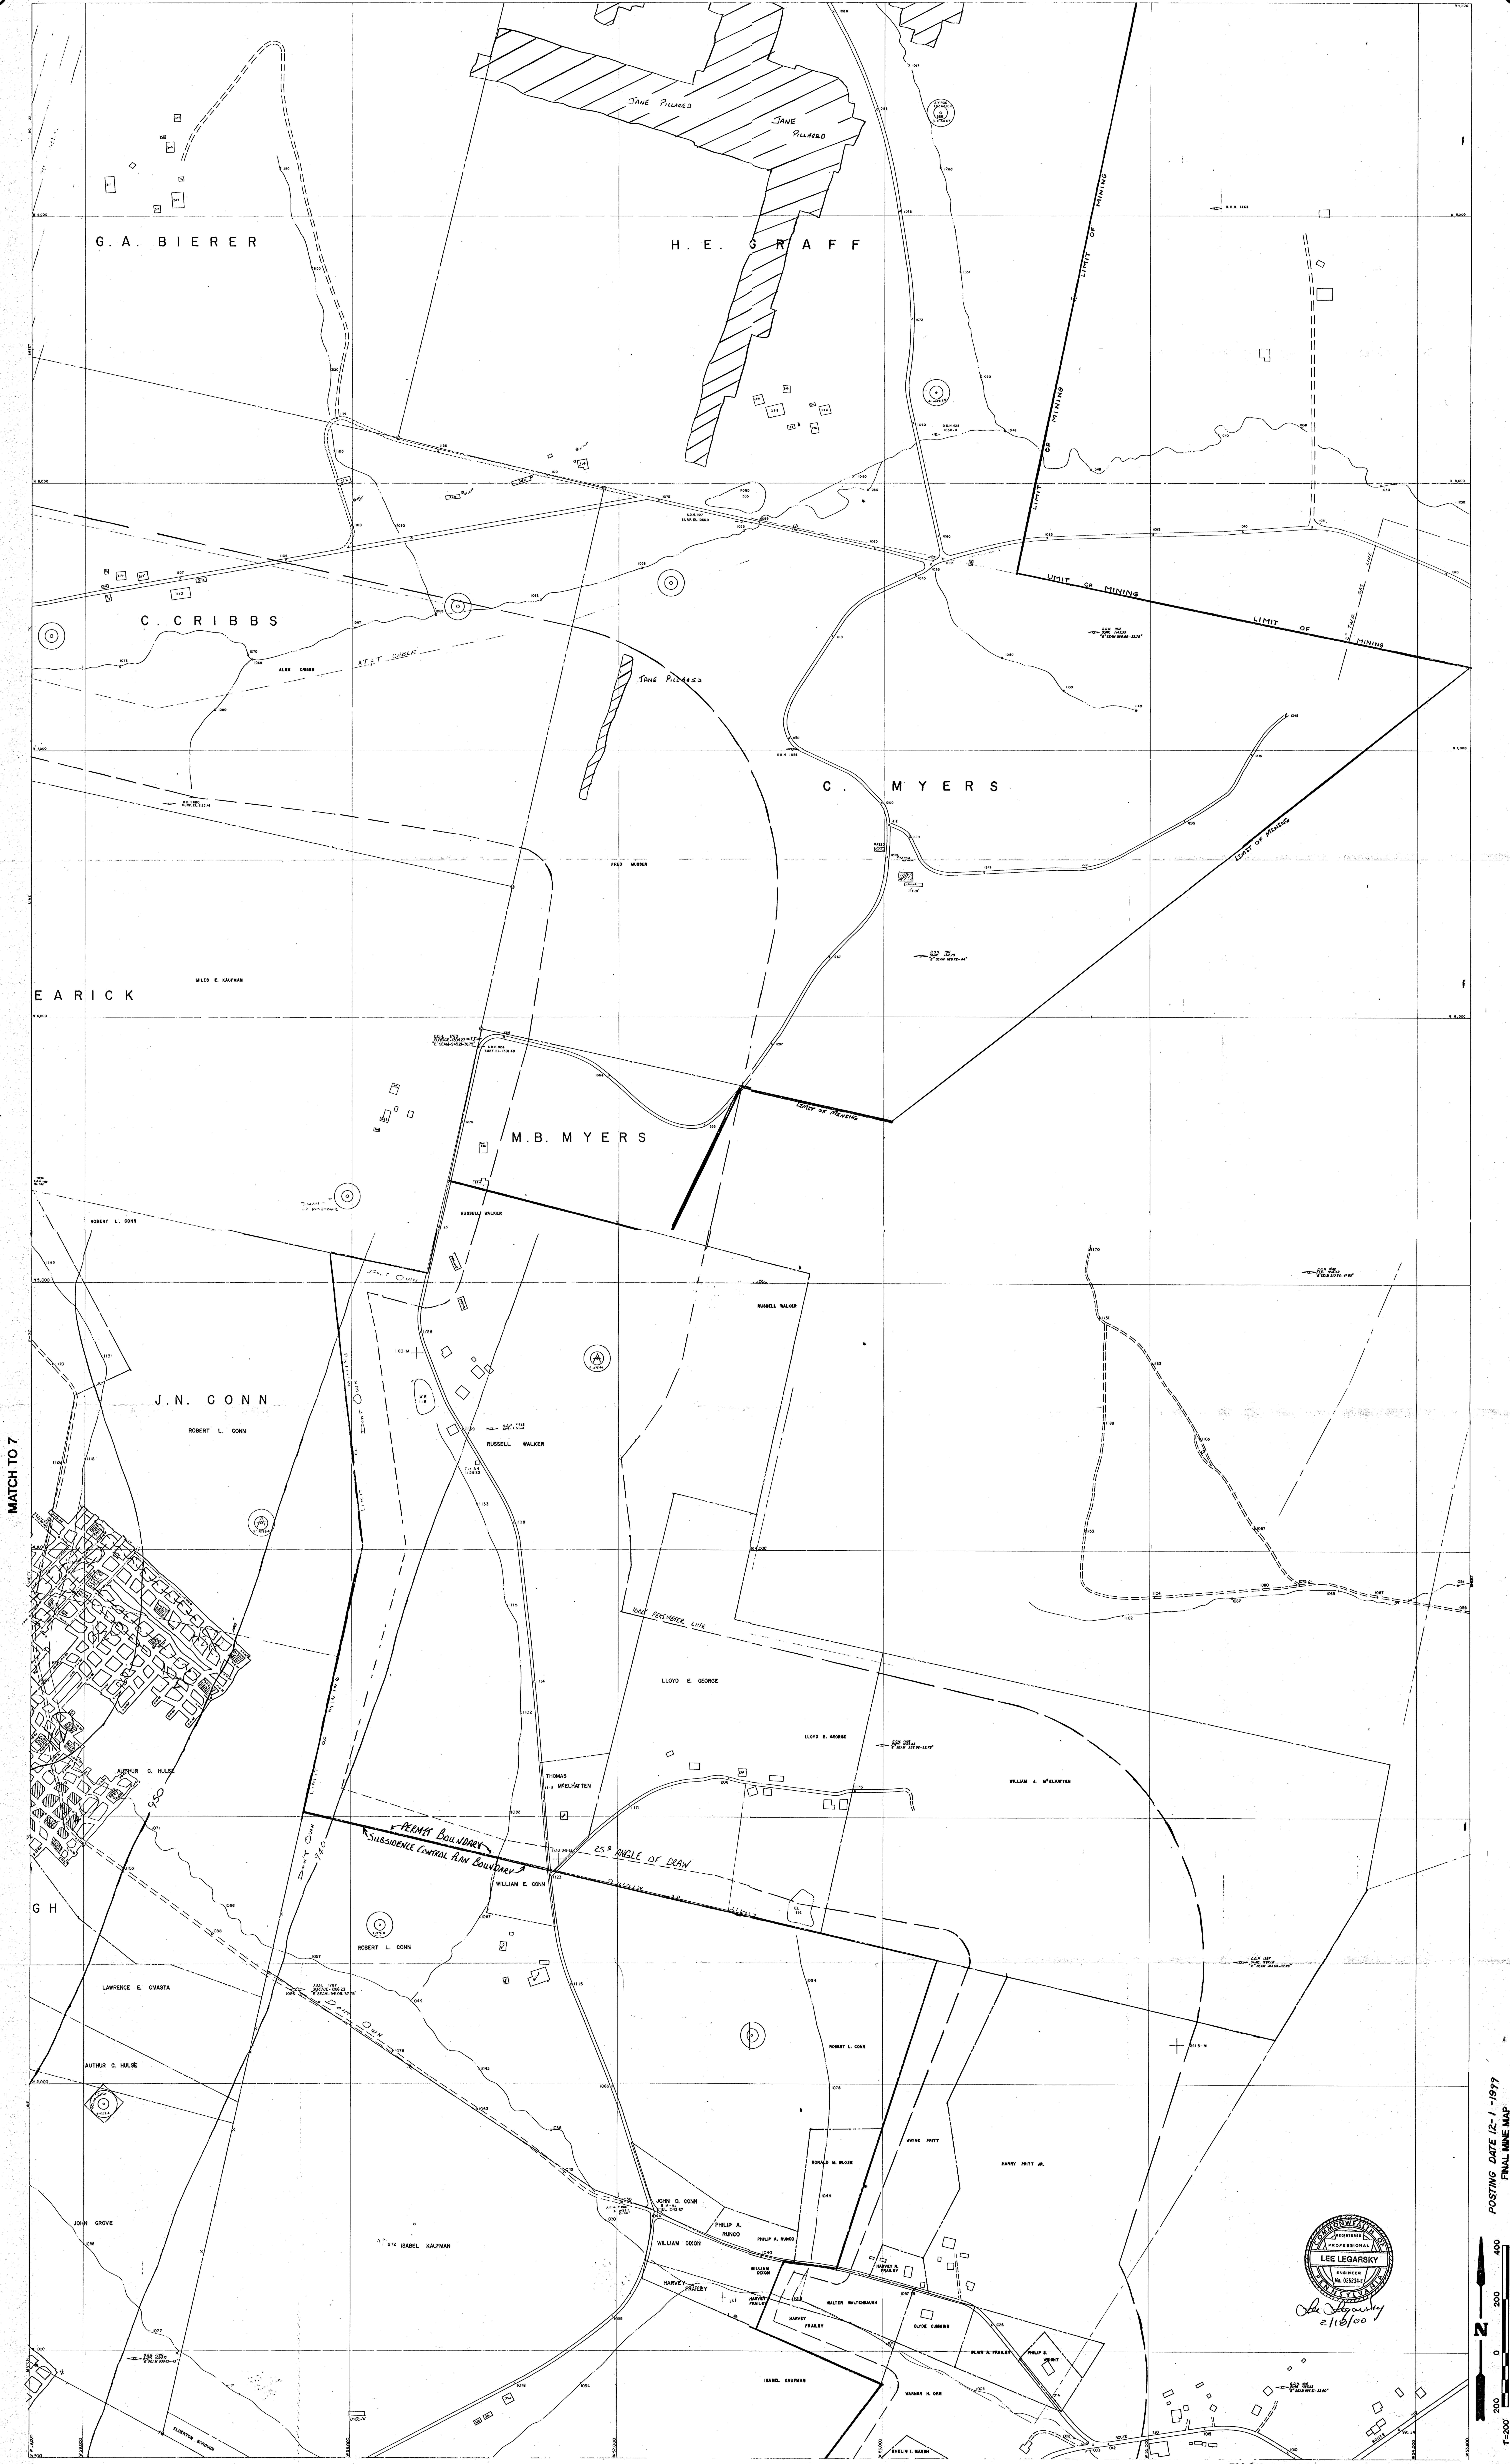


MATCH TO 7

MATCH TO 12

PLUMCEEK & SOUTH BEND TOWNSHIPS.
ARMSTRONG COUNTY

EMILIE No. 1 & 2 MINE
(UPPER FREEPORT COAL SEAM)

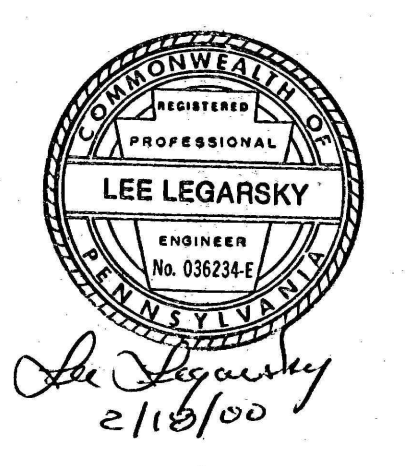

POSTING DATE 12-1-1977
FINAL MINE MAP
N
0 200 400
Scale Feet
T-200