


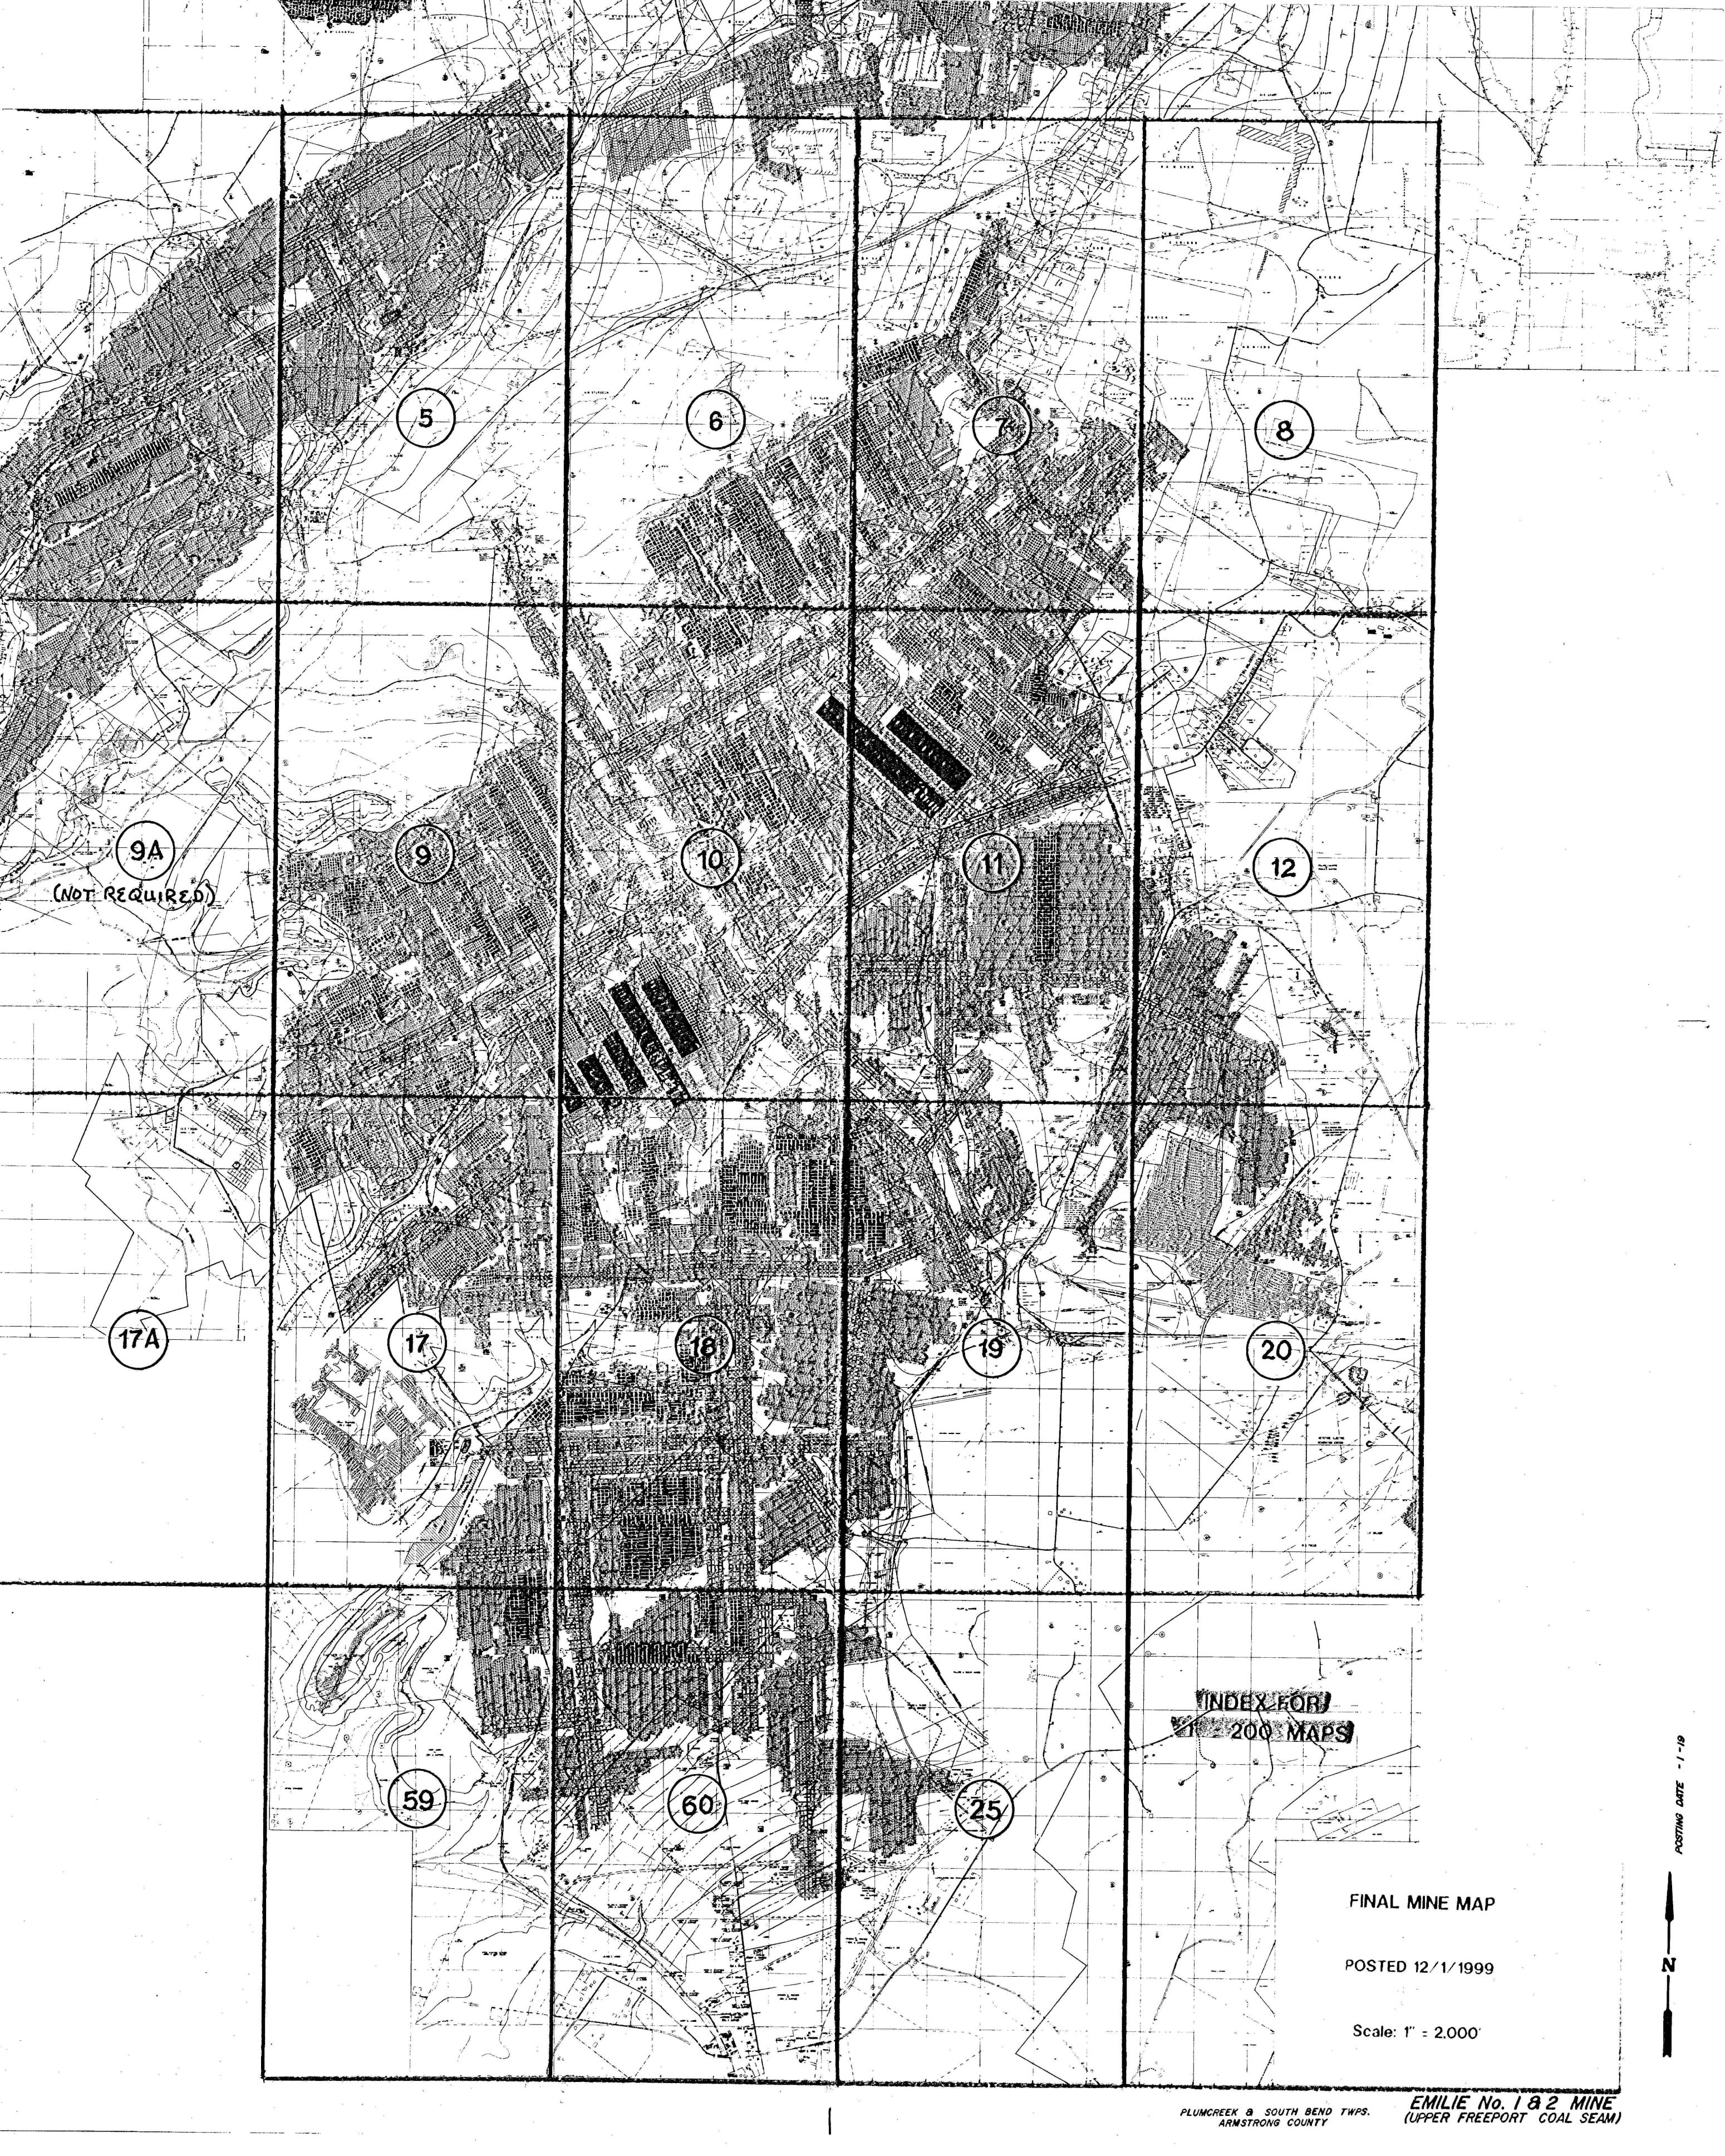

5

6

7

8

9A

9

10

11

12

17A

17

18

19

20

59

60

25

INDEX FOR
200 MAPS

FINAL MINE MAP

POSTED 12/1/1999

Scale: 1" = 2,000'

POSTING DATE - 1-19
N

PLUMCREEK & SOUTH BEND TOWNSHIPS,
ARMSTRONG COUNTY

EMILIE No. 1 & 2 MINE
(UPPER FREEPORT COAL SEAM)