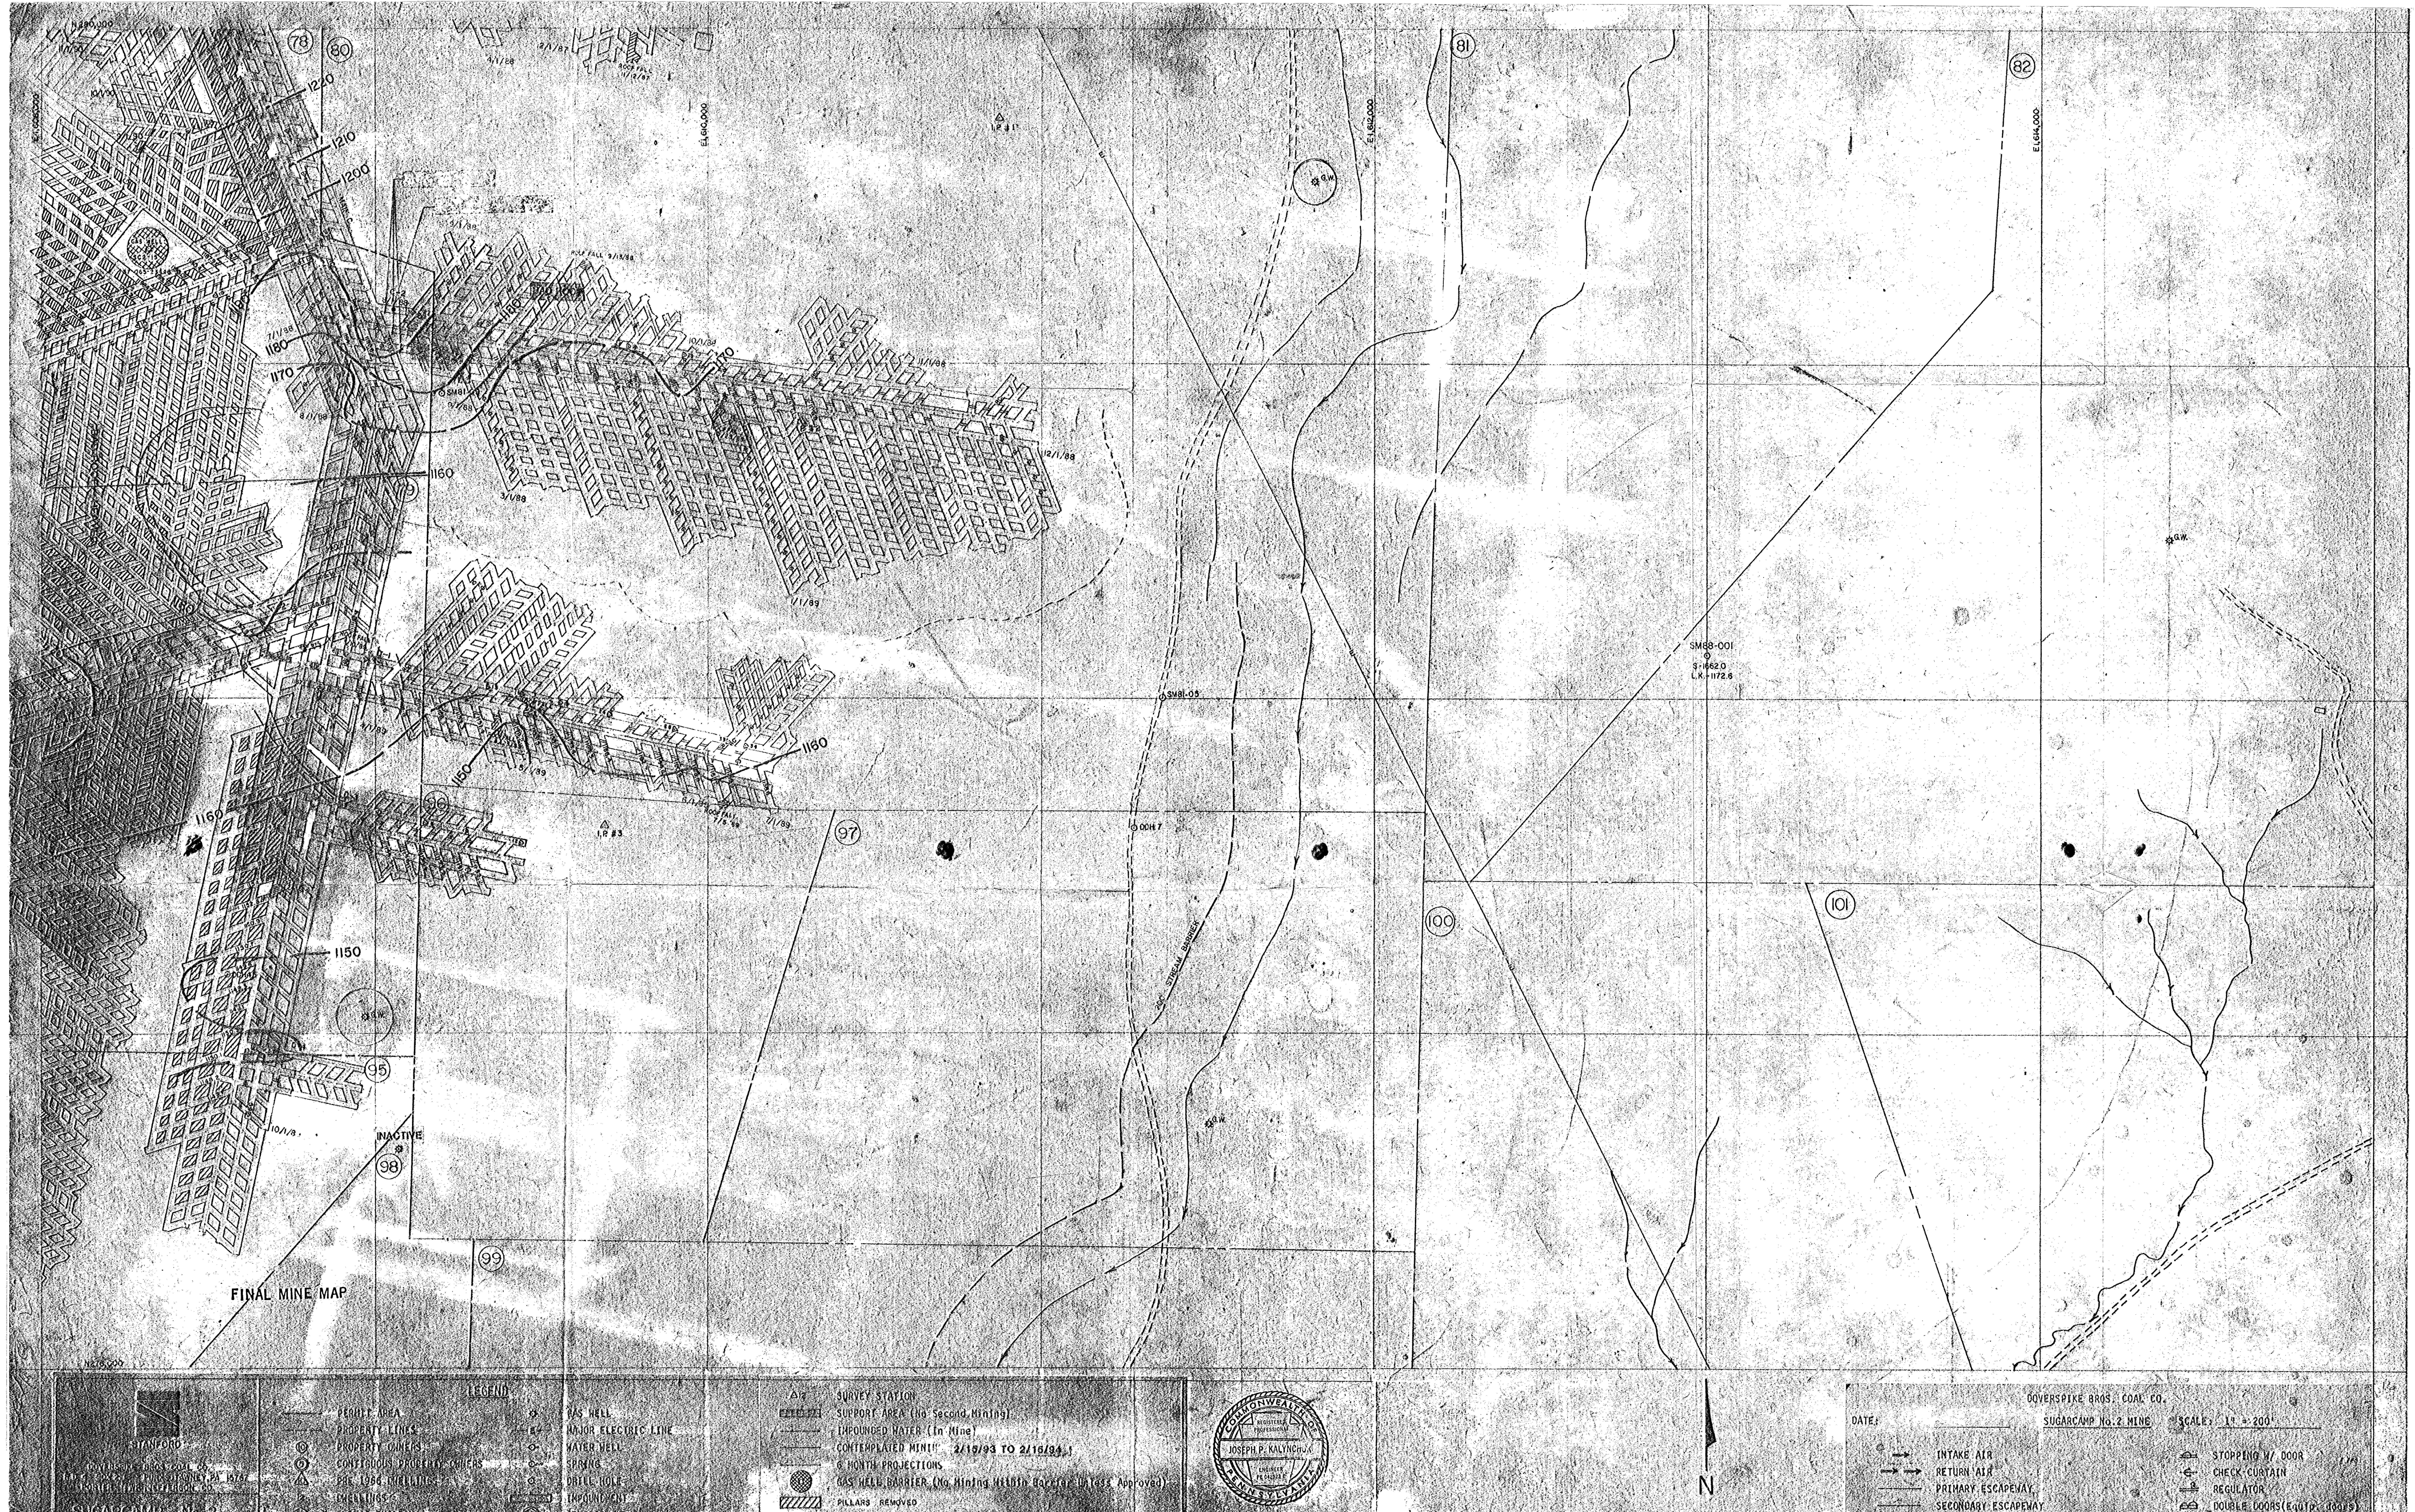

STANFORD

DOVERSPIKE BROS. COAL CO.
R.D. 4, BOX [illegible] PUNXSUTAWNEY, PA 15767
PORTER TWP. JEFFERSON CO.

SUGARCAMP No. 2

[illegible]

EXHIBIT "B"

LEGEND

- PERMIT AREA
- PROPERTY LINES
- PROPERTY OWNERS
- CONTIGUOUS PROPERTY OWNERS
- PRE 1966 DWELLINGS
- DWELLINGS
- PUBLIC BUILDINGS
- L.K. COAL CONTOURS
- L.K. COAL OUTCROP
- GAS LINES
- GAS WELL
- MAJOR ELECTRIC LINE
- WATER WELL
- SPRING
- DRILL HOLE
- IMPOUNDMENT
- CEMETERY
- MINE OPENINGS, NOT SEALED
- MINE OPENINGS, SEALED
- STREAMS
- SURVEY STATION
- SUPPORT AREA (No Second Mining)
- IMPOUNDED WATER (In Mine)
- CONTEMPLATED MINING 2/15/93 TO 2/15/94
- 6 MONTH PROJECTIONS
- GAS WELL BARRIER (No Mining Within Barrier Unless Approved)
- PILLARS REMOVED

JOSEPH P. KALYNCHUK
PE 042523 E

Joseph P. Kalynchuk
5-4-93

N

DOVERSPIKE BROS. COAL CO.

DATE: ______ SUGARCAMP No.2 MINE SCALE: 1" = 200'

- INTAKE AIR
- RETURN AIR
- PRIMARY ESCAPEWAY
- SECONDARY ESCAPEWAY
- BELT LINE
- B-E POINTS (Approved)
- B-E POINTS (Proposed)
- STOPPING
- STOPPING W/ DOOR
- CHECK CURTAIN
- REGULATOR
- DOUBLE DOORS(Equip. doors)
- OVERCAST
- REGULATING OR RUN-THROUGH CHECK

Survey is closed loop, Accuracy is 1:10000
Individuals responsible for information:
Mark Pennsy, Engineer & Larry Smith, Superintendent