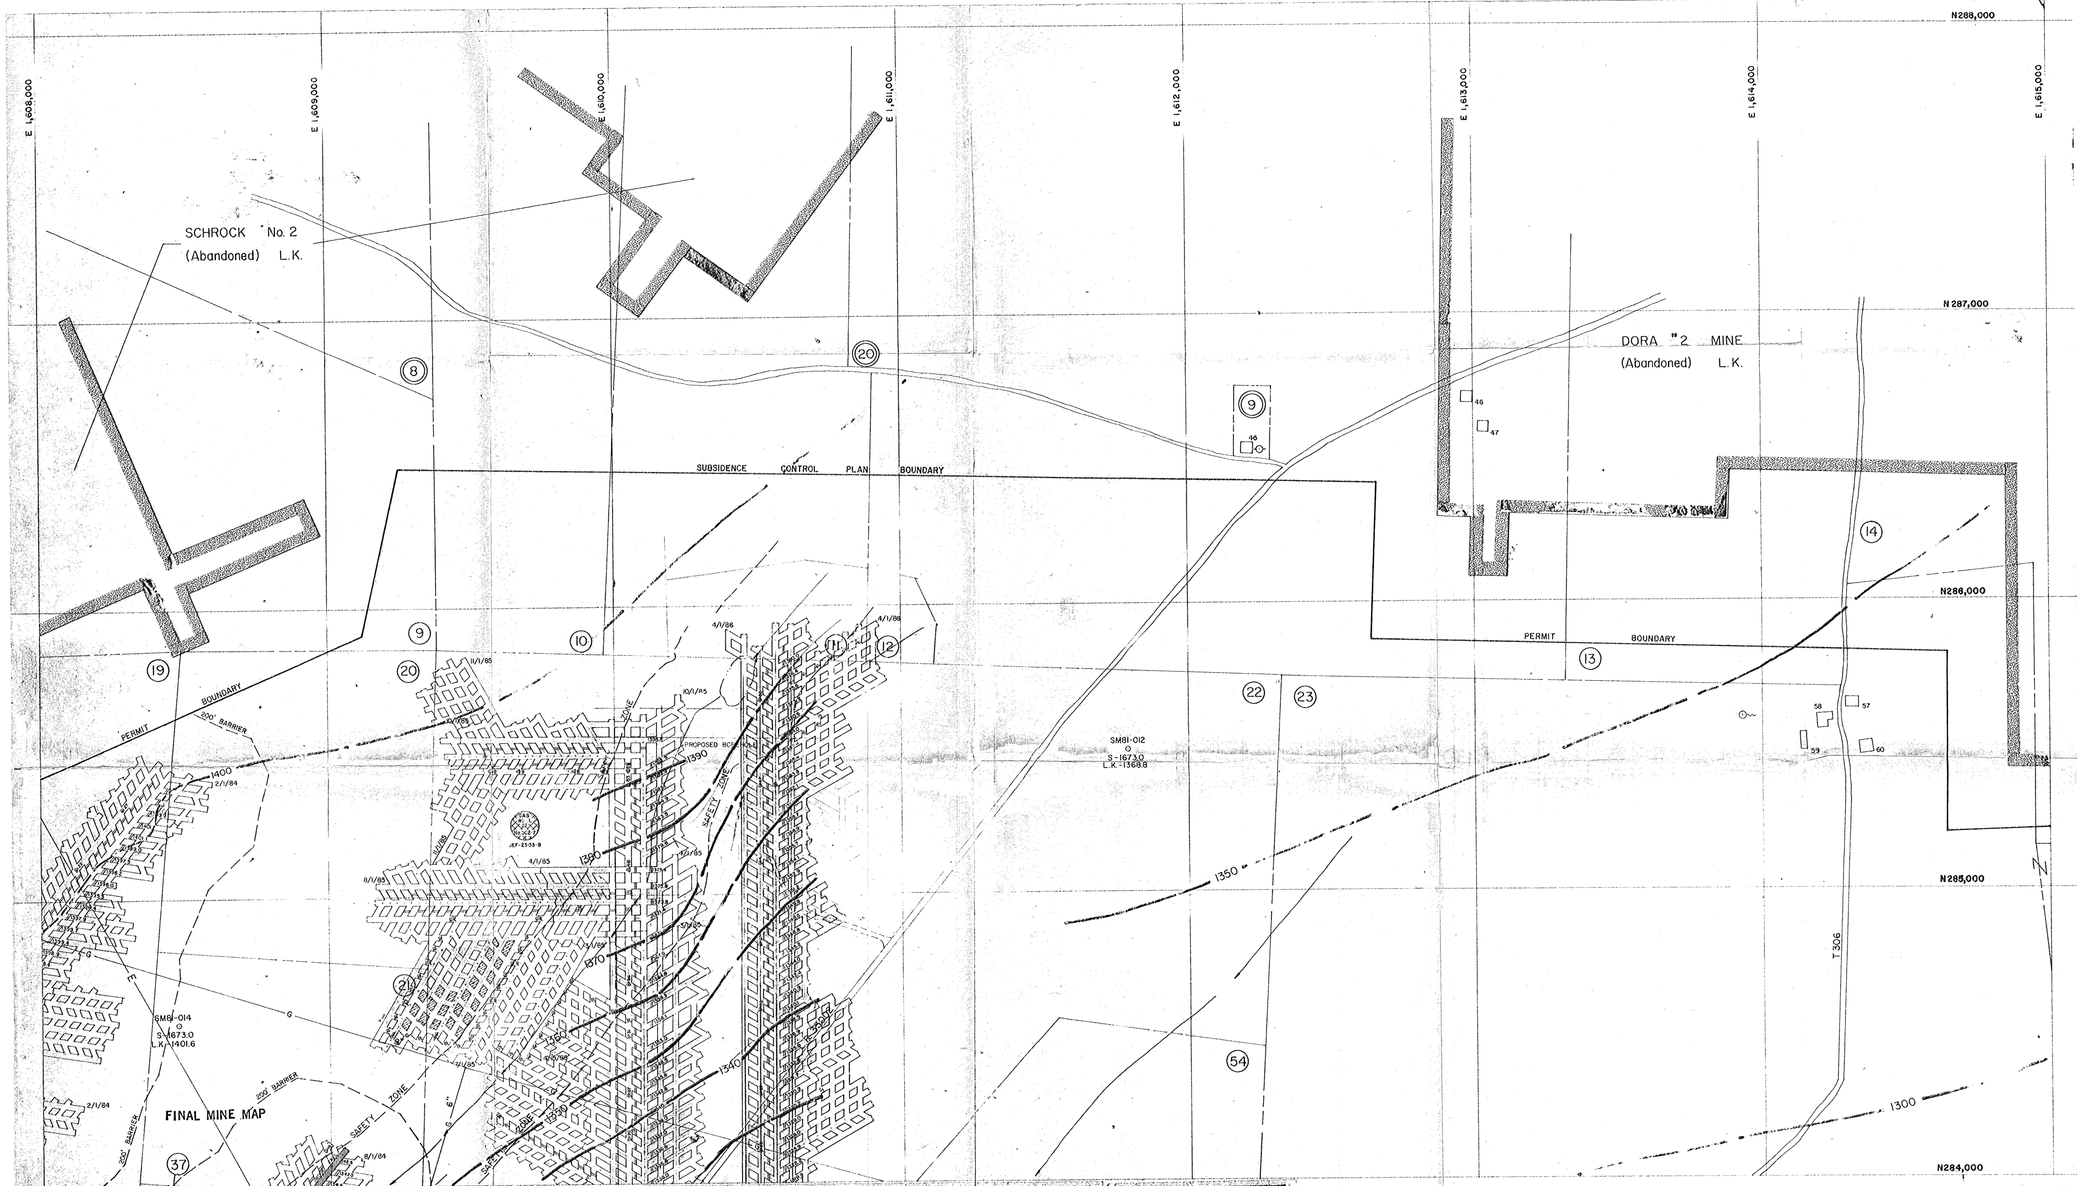

Beanford
PORTER TWP., JEFFERSON CO.
Doverspike Bros. Coal Co.
R.D.4 Box 271 Punxsutawney, Pa. 15767

SUGARCAMP NO. 2

SHEET No. 3 of 6 | SCALE 1" = 200'

EXHIBIT "B"

LEGEND

- PERMIT AREA
- UNDERGROUND WORKINGS
- TOWNSHIP BOUNDARY
- COUNTY BOUNDARY
- TEST BOREHOLE
- CROP LINES — LOWER RIT BLOWS
- COAL CONTOURS — 1200
- SURFACE WORKINGS
- MINE OPENINGS, Not Sealed
- MINE OPENINGS, Sealed
- PROPERTY LINES
- PRE 1966 DWELLINGS
- POST 1966 DWELLINGS — 10
- CEMETERIES
- STRUCTURES
- MAJOR ELECTRIC LINES — E
- PIPELINES — G
- GAS WELLS
- WATER WELLS
- STREAMS
- LAKES or PONDS
- SPRING
- WATER TREATMENT FACILITIES — WTF
- CONTIGUOUS PROPERTY

LEGEND cont.

- WATER
- 6 MONTH PROJECTIONS
- SUPPORT AREA — 2/15/93 TO 2/15/94
- CONTEMPLATED MINING
- COMPLETED MINING
- SURVEY STATION
- GAS WELL BARRIER — (No Mining Within Barrier Unless Approved)

COMMONWEALTH OF PENNSYLVANIA
REGISTERED PROFESSIONAL
JOSEPH P. KALYNCHUK
INDIANA, PENNSYLVANIA

SEAL

Joseph P. Kalynchuk
5-4-93
SIGNATURE

N

DOVERSPIKE BROS. COAL CO.

DATE: _____ SUGARCAMP No. 2 MINE SCALE: 1" = 200'

- INTAKE AIR
- RETURN AIR
- PRIMARY ESCAPEWAY
- SECONDARY ESCAPEWAY
- BELT LINE
- B-E POINTS (Approved)
- B-E POINTS (Proposed)
- STOPPING
- STOPPING W/ DOOR
- CHECK CURTAIN
- REGULATOR
- DOUBLE DOORS (Equip. doors)
- OVERCAST

Survey is closed loop. Accuracy is 1:10000
Individuals responsible for information:
Mark Pennsy, Engineer & Larry Smith, Superintendent