


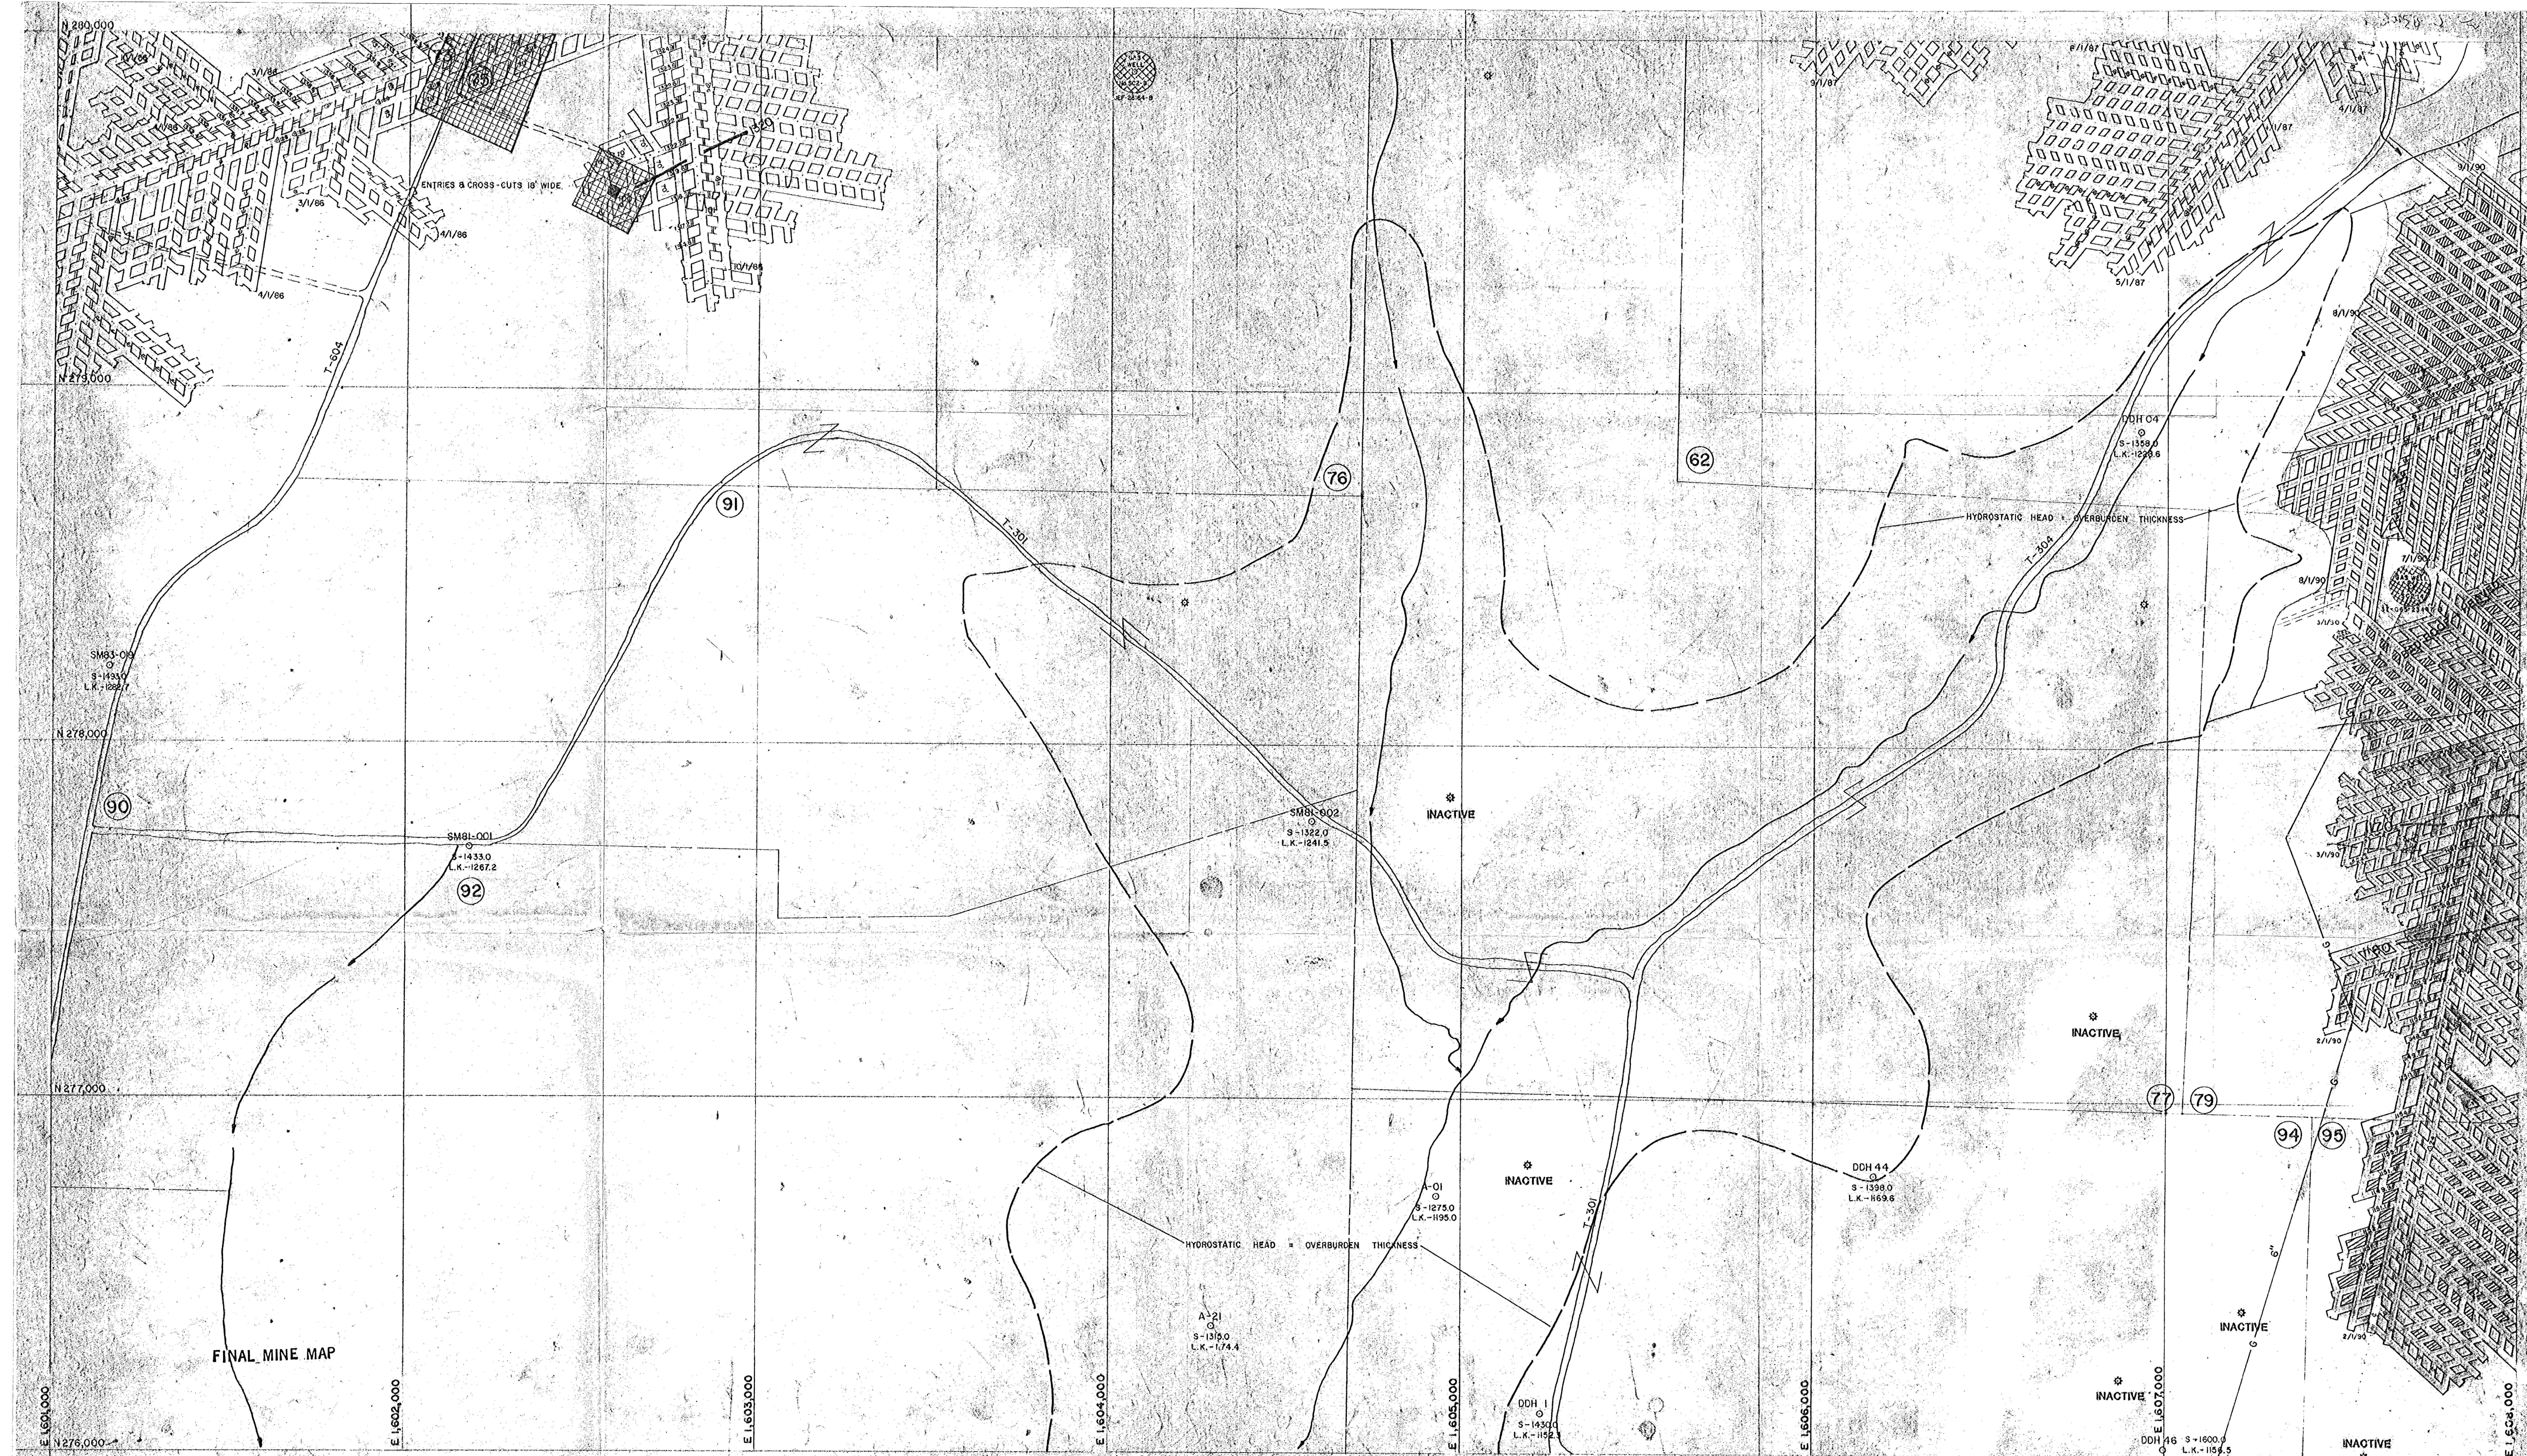

STANFORD
PORTER TWP., JEFFERSON CO.
DOVERSPIKE BROS. COAL CO.
PO BOX 211, Pottsville, PA 17277

SUGARCAMP No. 2

SCALE 1"=200'

EXHIBIT "B"

LEGEND

Permit Area	Post 1966 Dwellings
Underground Workings	Conduits
Township Boundary	Structures
County Boundary	Major Electric Lines
Test Borings	Pipelines
Crop Lines	Gas Wells
Surface Workings	Water Wells
Mine Openings, Not Sealed	Streams
Mine Openings, Sealed	Lakes or Ponds
Property Lines	Water Treatment Facilities
Pre 1966 Dwellings	Contiguous Property
Water Monitoring Point	Coal Contours
Background Topography	Spring
Dore 16 Mine	Minor Linear
Major Linear	

LEGEND continued

Walls

6 Month Projections

Support Area

Contemplated Mining

Survey Station

GAS WELL BARRIER

PILLARS REMOVED

2/16/33 TO 2/16/34

(See Notes on Mine Survey Unless Approved)

Joseph P. McLaughlin
5-4-93

DATE: _____

DOVERSPIKE BROS. COAL CO.
SUGARCAMP No. 2 MINE

SCALE: 1"=200'

INTAKE AIR	STOPPING W/ DOOR
RETURN AIR	CHECK CURTAIN
PRIMARY ESCAPEWAY	REGULATOR
SECONDARY ESCAPEWAY	DOUBLE DOORS (Equip. doors)
BELT LINE	OVERCAST
B-E POINTS (Approved)	
B-E POINTS (Proposed)	
STOPPING	

Survey is closed loop. Accuracy is 1:10000.
Individuals responsible for the information:
Mark Penney, Engineer & Larry Smith, Supervisor