


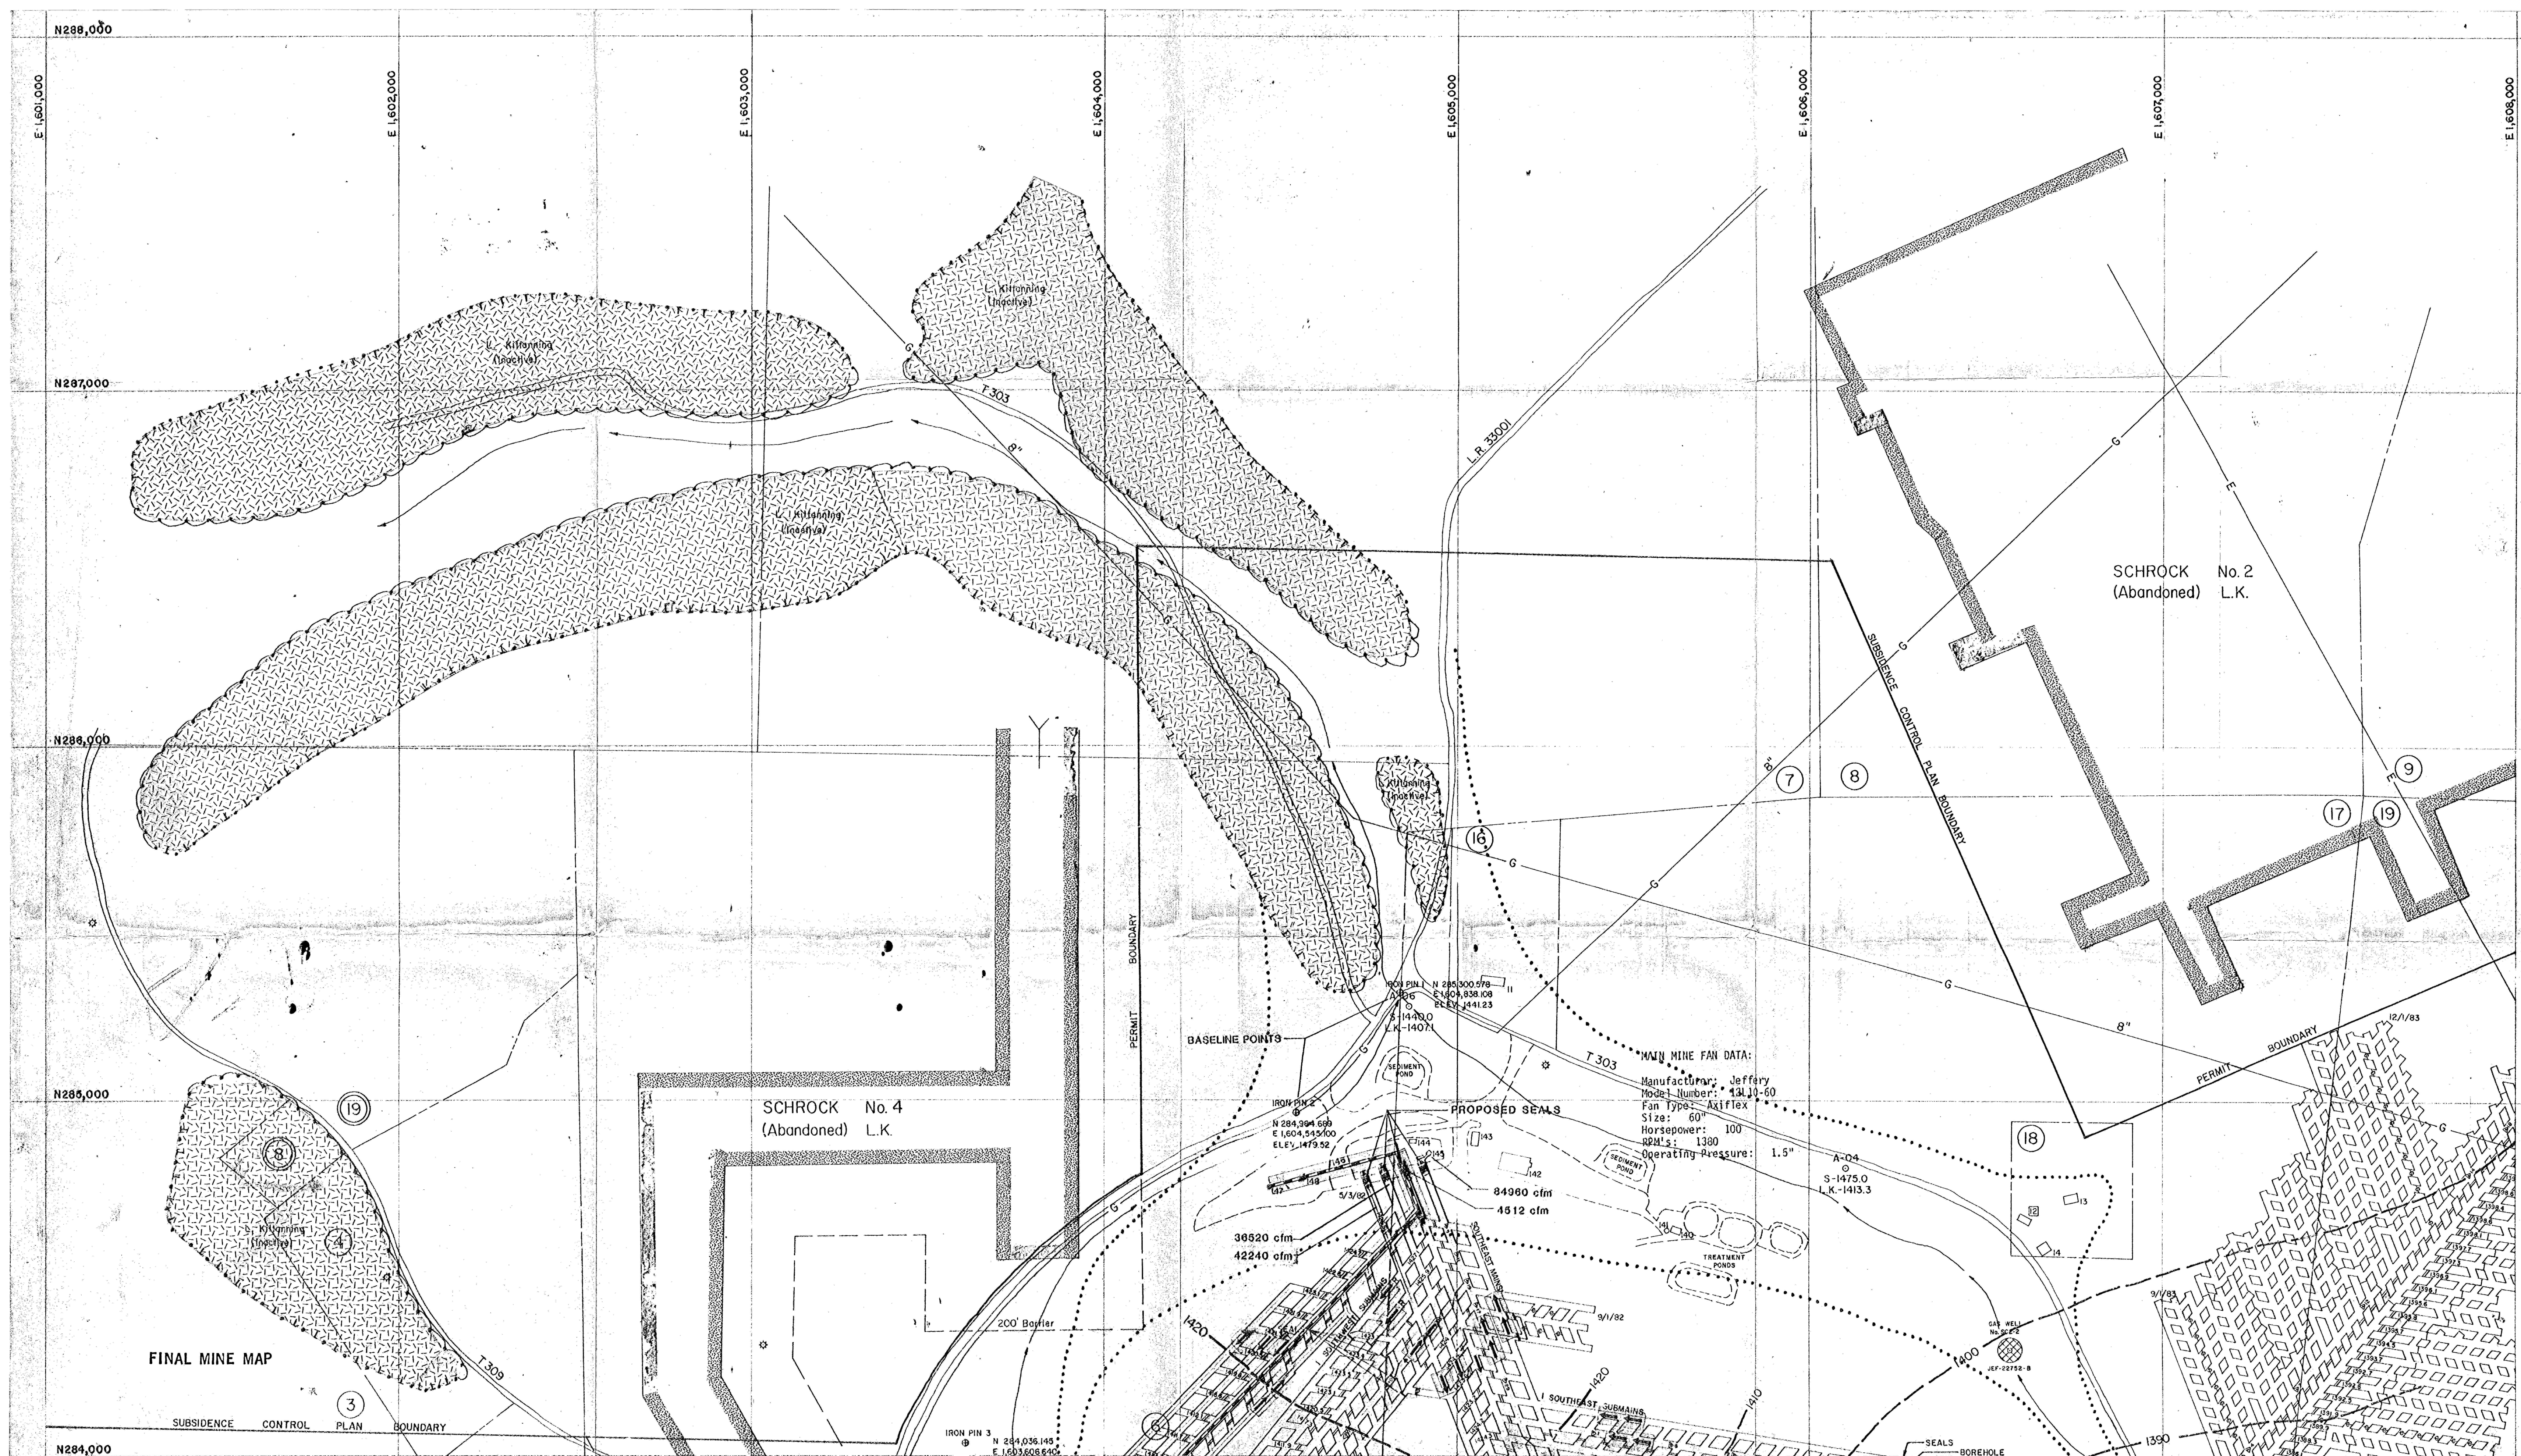

Stanford
 PORTER TWP., JEFFERSON CO.
Doverspike Bros. Coal Co.
 R.D. # 2, Box 271, P.O. Box 271, 19797
SUGARCAMP NO. 2
 SHEET No. 2 of 18 SCALE 1"=200'
EXHIBIT "B"

LEGEND

PERMIT AREA	UNDERGROUND WORKINGS	POST 1968 DWELLINGS	CEMETERIES
TOWNSHIP BOUNDARY	CROP LINES	STRUCTURES	MAJOR ELECTRIC LINES
COUNTY BOUNDARY	COAL CONTOURS	PIPELINES	GAS WELLS
TEST BOREHOLE	SURFACE WORKINGS	WATER WELLS	STREAMS
MINES OPENINGS, Not Sealed	MINES OPENINGS, Sealed	LAKES or PONDS	SPRINGS
PROPERTY LINES	PRE 1968 DWELLINGS	WATER TREATMENT FACILITIES	CONTIGUOUS PROPERTY

LEGEND cont.

WATER	6 MONTH PROJECTIONS
SUPPORT AREA	CONTEMPLATED MINING
COMPLETED MINING	SURVEY STATION
GAS WELL BARRIER	(No Mining Within Barrier Unless Approved)

JOSEPH P. KALYNCHUK
 REGISTERED PROFESSIONAL ENGINEER
 PENNSYLVANIA
 No. 10000
 5-4-93

DOVERSPIKE BROS. COAL CO.
SUGARCAMP No. 2 MINE
 DATE: _____ SCALE: 1"=200'

INTAKE AIR	STOPPING W/ DOOR
RETURN AIR	CHECK CURTAIN
PRIMARY ESCAPEWAY	REGULATOR
SECONDARY ESCAPEWAY	DOUBLE DOORS (Equip. doors)
BELT LINE	OVERCAST
B-E POINTS (Approved)	
B-E POINTS (Proposed)	
STOPPING	

Survey is closed loop. Accuracy is 1:10000
 Individuals responsible for information:
 Mark Pennsy, Engineer & Larry Smith, Superintendent



