

N 284,000

N 283,000

N 282,000

N 281,000

E 1,594,000

E 1,595,000

E 1,596,000

E 1,597,000

E 1,598,000

E 1,599,000

FINAL MINE MAP

25° ANGLE OF DRAW

SUBSIDENCE CONTROL PLAN BOUNDARY

L.R. 33002

T 706

72

73

31

56

30

29

28

2

18

19

20

15

16

1

5

4

3

6

5

6

DOVERSPIKE BROS. COAL CO.

SUGARCAMP No. 2 MINE

SCALE: 1" = 200'

DATE:

INTAKE AIR

RETURN AIR

PRIMARY ESCAPEWAY

SECONDARY ESCAPEWAY

BELT LINE

B-E POINTS (Approved)

B-E POINTS (Proposed)

STOPPING

STOPPING W/ DOOR


CHECK CURTAIN

REGULATOR

DOUBLE DOORS (Equip. doors)

OVERCAST

Survey is closed loop. Accuracy is 1:10000.
Individuals responsible for information:
Mark Pennsy, Engineer & Larry Smith, Superintendent

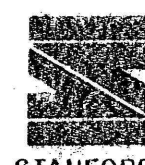

STANFORD

DOVERSPIKE BROS. COAL CO.
R.D. 4 BOX 271 PUNXSUTAWNEY, PA 15767
PORTER TWP., JEFFERSON CO.

SUGARCAMP No. 2

SHEET 5 OF 16 SCALE: 1" = 200'


EXHIBIT "B"

LEGEND

- PERMIT AREA
- PROPERTY LINES
- PROPERTY OWNERS
- CONTIGUOUS PROPERTY OWNERS
- PRE 1966 DWELLINGS
- DWELLINGS
- PUBLIC BUILDINGS
- L.K. COAL CONTOURS
- L.K. COAL OUTCROP
- GAS LINE

- GAS WELL
- MAJOR ELECTRIC LINE
- WATER WELL
- SPRING
- DRILL HOLE
- IMPOUNDMENT
- CEMETERY
- MINE OPENINGS, NOT SEALED
- MINE OPENINGS, SEALED
- STREAMS

- SURVEY STATION
- SUPPORT AREA (No Second Mining)
- IMPOUNDED WATER (In Mine)
- CONTEMPLATED MINING 2/15/93 TO 2/15/94
- 6 MONTH PRO
- GAS WELL BARRIER (No Mining Within Barrier Unless Approved)

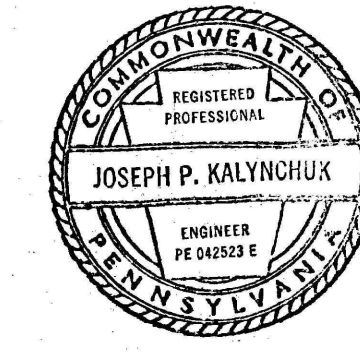

Joseph P. Kalyonchuk
5-4-93
SIGNATURE