


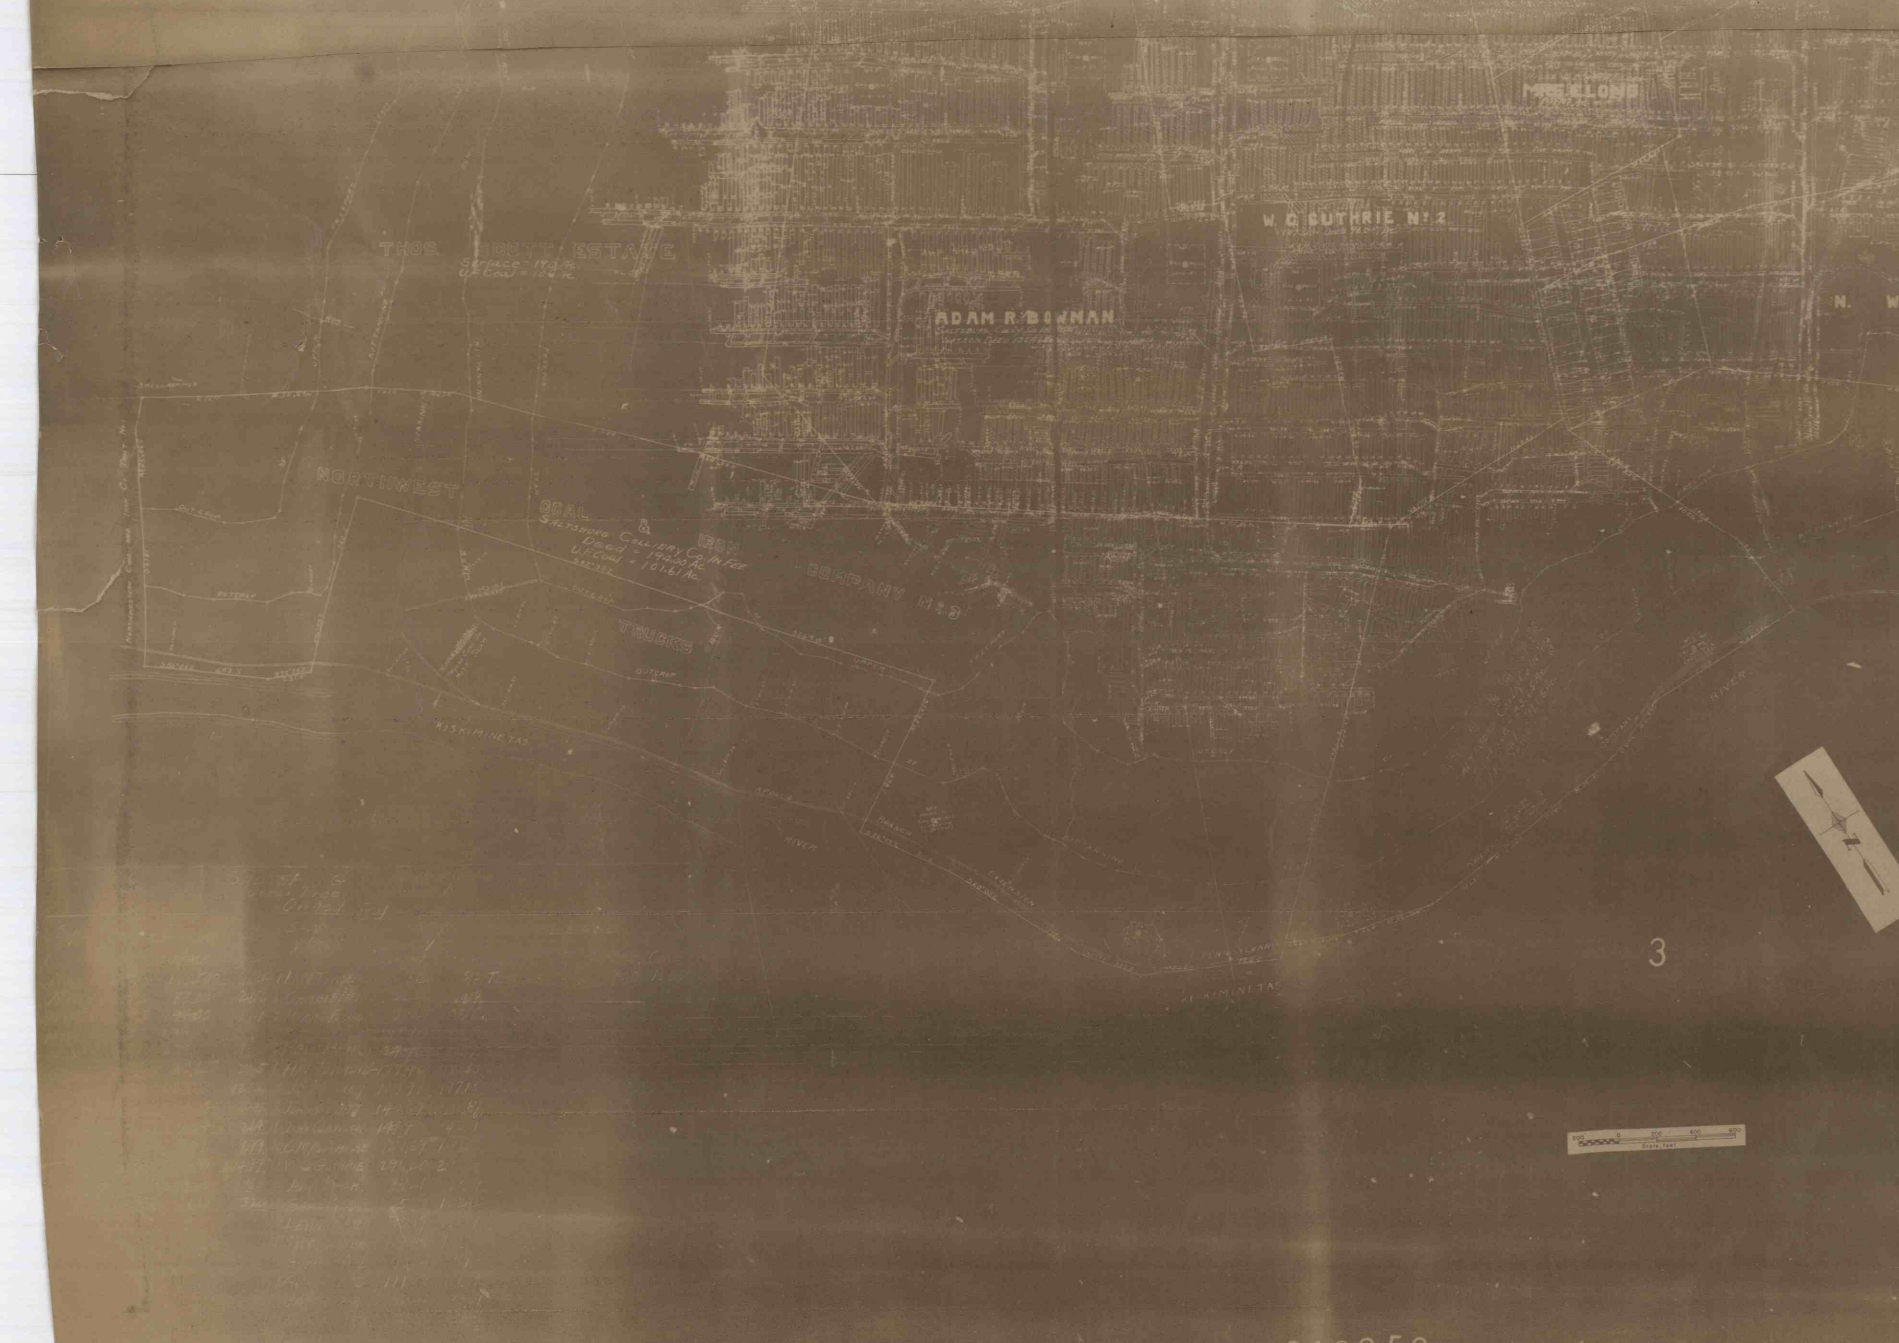

MAP
showing the lands of
FREEPORT COAL
Sheet 15
ENGINEERING DEPARTMENT
OCTOBER 1914