


73.172-6 PAN DATA
LOCATION: DRIFT OPENING RPM 1000
TYPE: AIRAL BLADE SETTING 15"
SIDE: 60' 0" 0"
PRESSURE: 100 PSI
MODEL: UNKNOWN

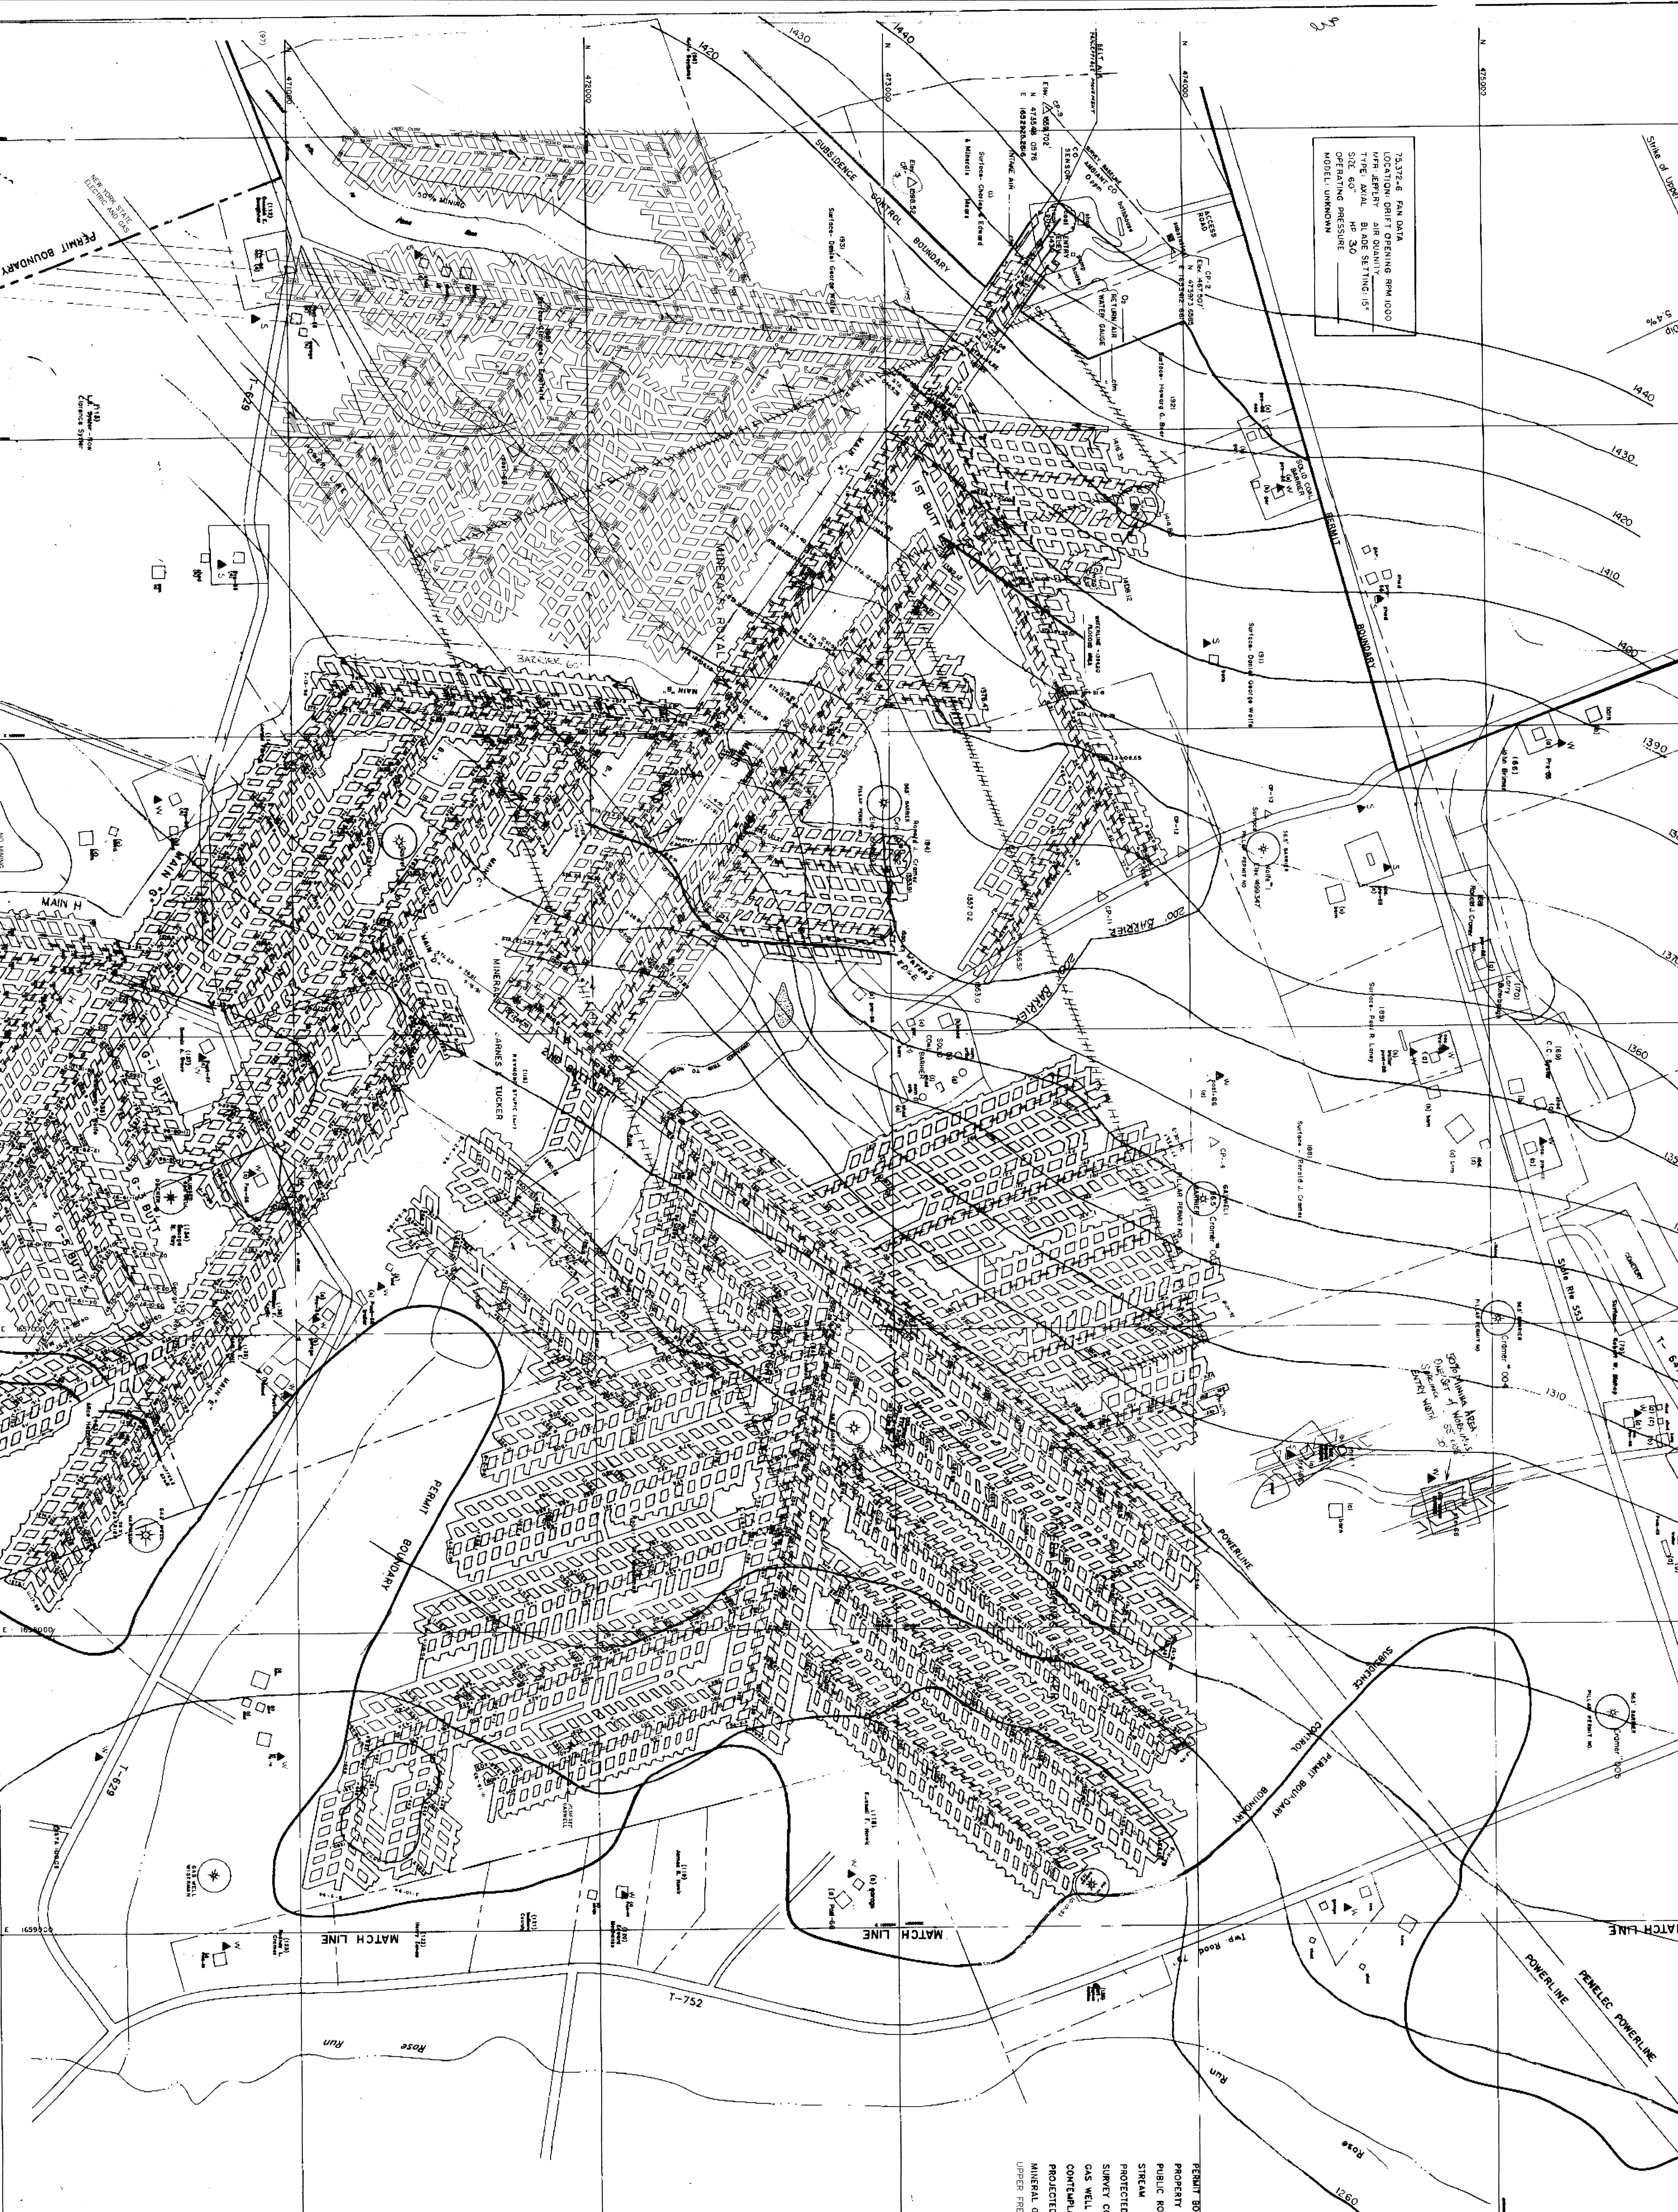

MINE ID NO. 36-08174
THIS MAP MEETS REQUIREMENTS FOR
73.1200 AND 73.372
SURVEYED BY CLOSED LOOP METHOD
ACC. 1-15000

RESPONSIBLE PERSON FOR MAP INFO
CLAR RUFFEN III
(GENERAL SUPERINTENDENT)

- LEGEND
- PROPERTY LINE
 - PUBLIC ROAD
 - STREAM
 - PROTECTED STRUCTURE
 - SURVEY CONTROL POINT
 - GAS WELL
 - CONTEMPLATED MINING AREA
 - PROJECTED MINING 74'-0" 44' TO 38'-0" 00'
 - MINERAL OWNERSHIP LINE
 - UPPER FREEPORT COAL CONTOUR

REVISIONS

DATE	BY	DESCRIPTION
9/2/82	3/10/83	
9/2/83	3/10/83	
3/15/84	3/10/83	
3/15/84	3/20/86	
6/20/84	6/7/86	

- LEGEND
- WORKING SECTION
 - PRIMARY ESCAPEWAY
 - ALTERNATIVE ESCAPEWAY
 - MAN DOOR
 - PERMANENT STOPPING
 - REGULATOR
 - CHECK CURTAIN
 - BELT HAULAGE
 - INTAKE AIRFLOW
 - RETURN AIR
 - OVERCAST
 - PROPOSED SEAL
 - SEAL POINT
 - EQUIPMENT DOORS
 - IMPACT SEALS

NOTE:
ELEVATIONS FROM STA. 312 AND ABOVE B.O.C.
ALL OTHERS T.O.C.
NOTE:
STOPPING WILL BE REQUIRED AS NEEDED
TO MAINTAIN PROPER VENTILATION.
FIELD OFFICE WILL BE NOTIFIED AS WORKERS
FREE INCREASES ONE CROSSOVER ON WORK
AND/OR AS NEEDED FROM BYFIELD OFFICE AND
MINE OFFICIALS.
CROSS CUTS ARE 20 FEET.

FINAL MINE MAP