


DEEP MINE SAFETY 2000

0 1,000 2,000 4,000
Feet

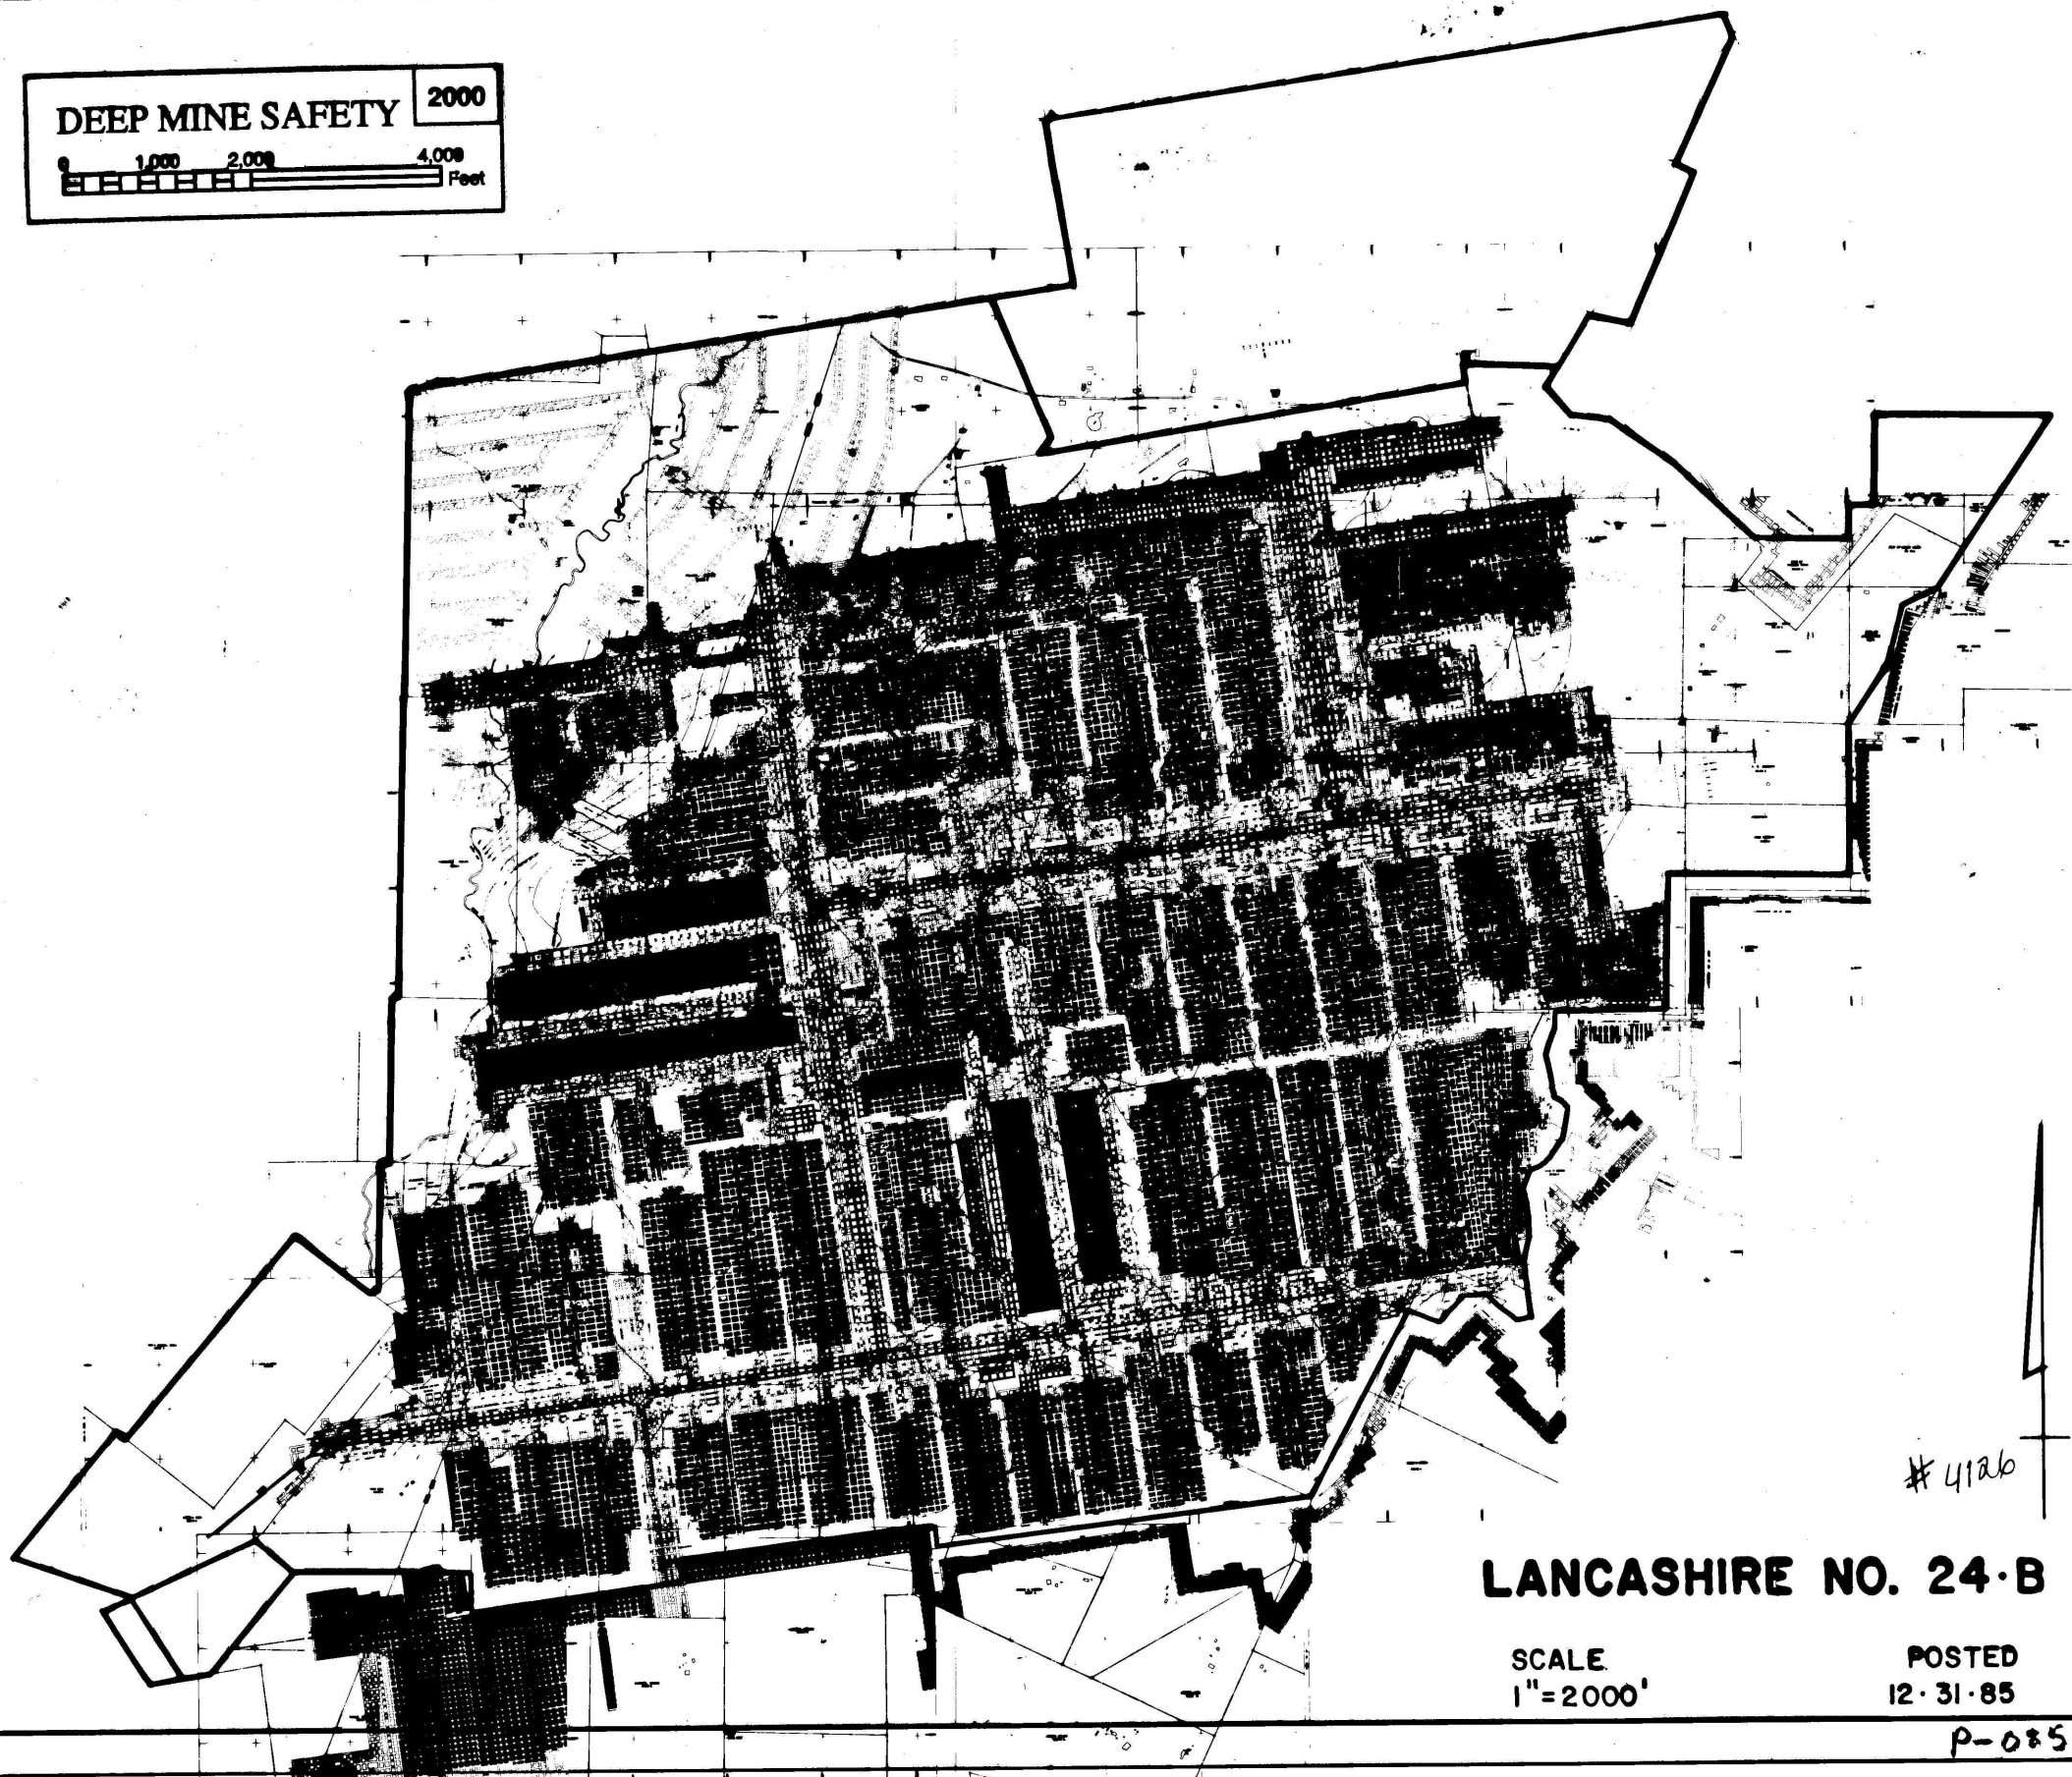

#4126
LANCASHIRE NO. 24-B

SCALE
1"=2000'

POSTED
12-31-85

P-085