
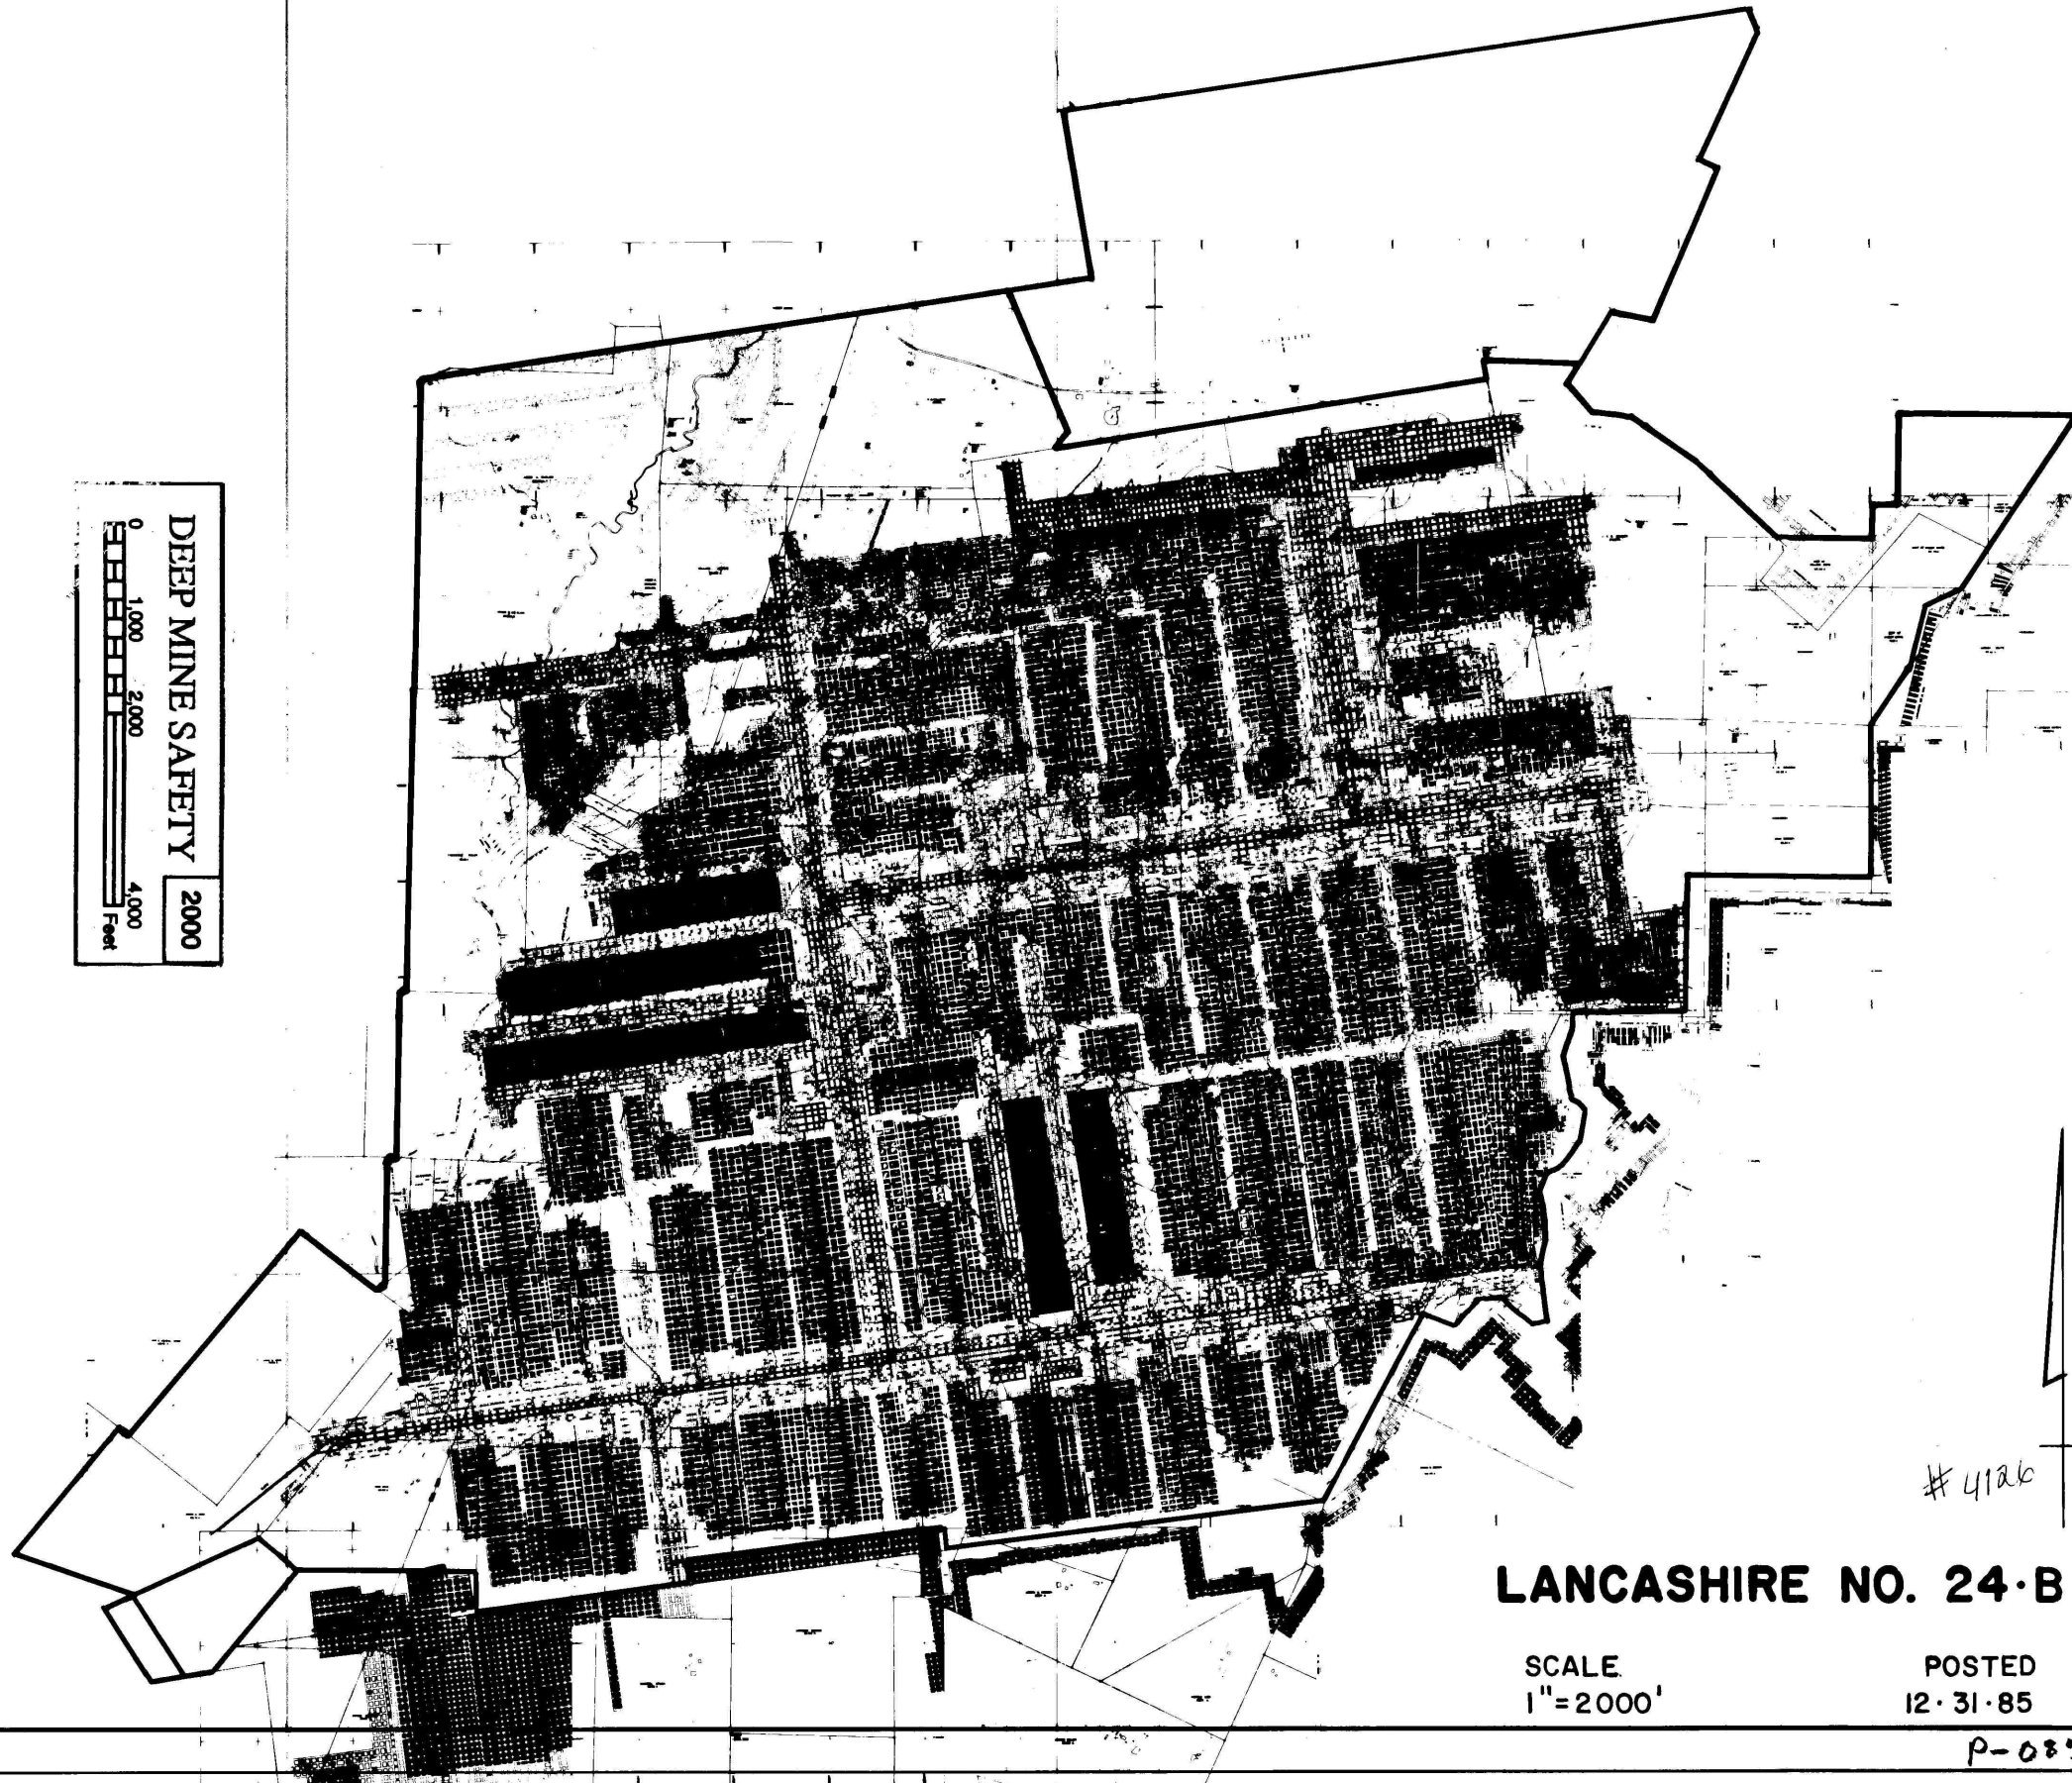


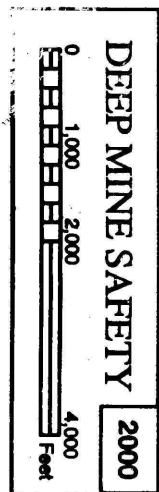

#4126

LANCASHIRE NO. 24-B

SCALE
1"=2000'

POSTED
12-31-85

P-085